


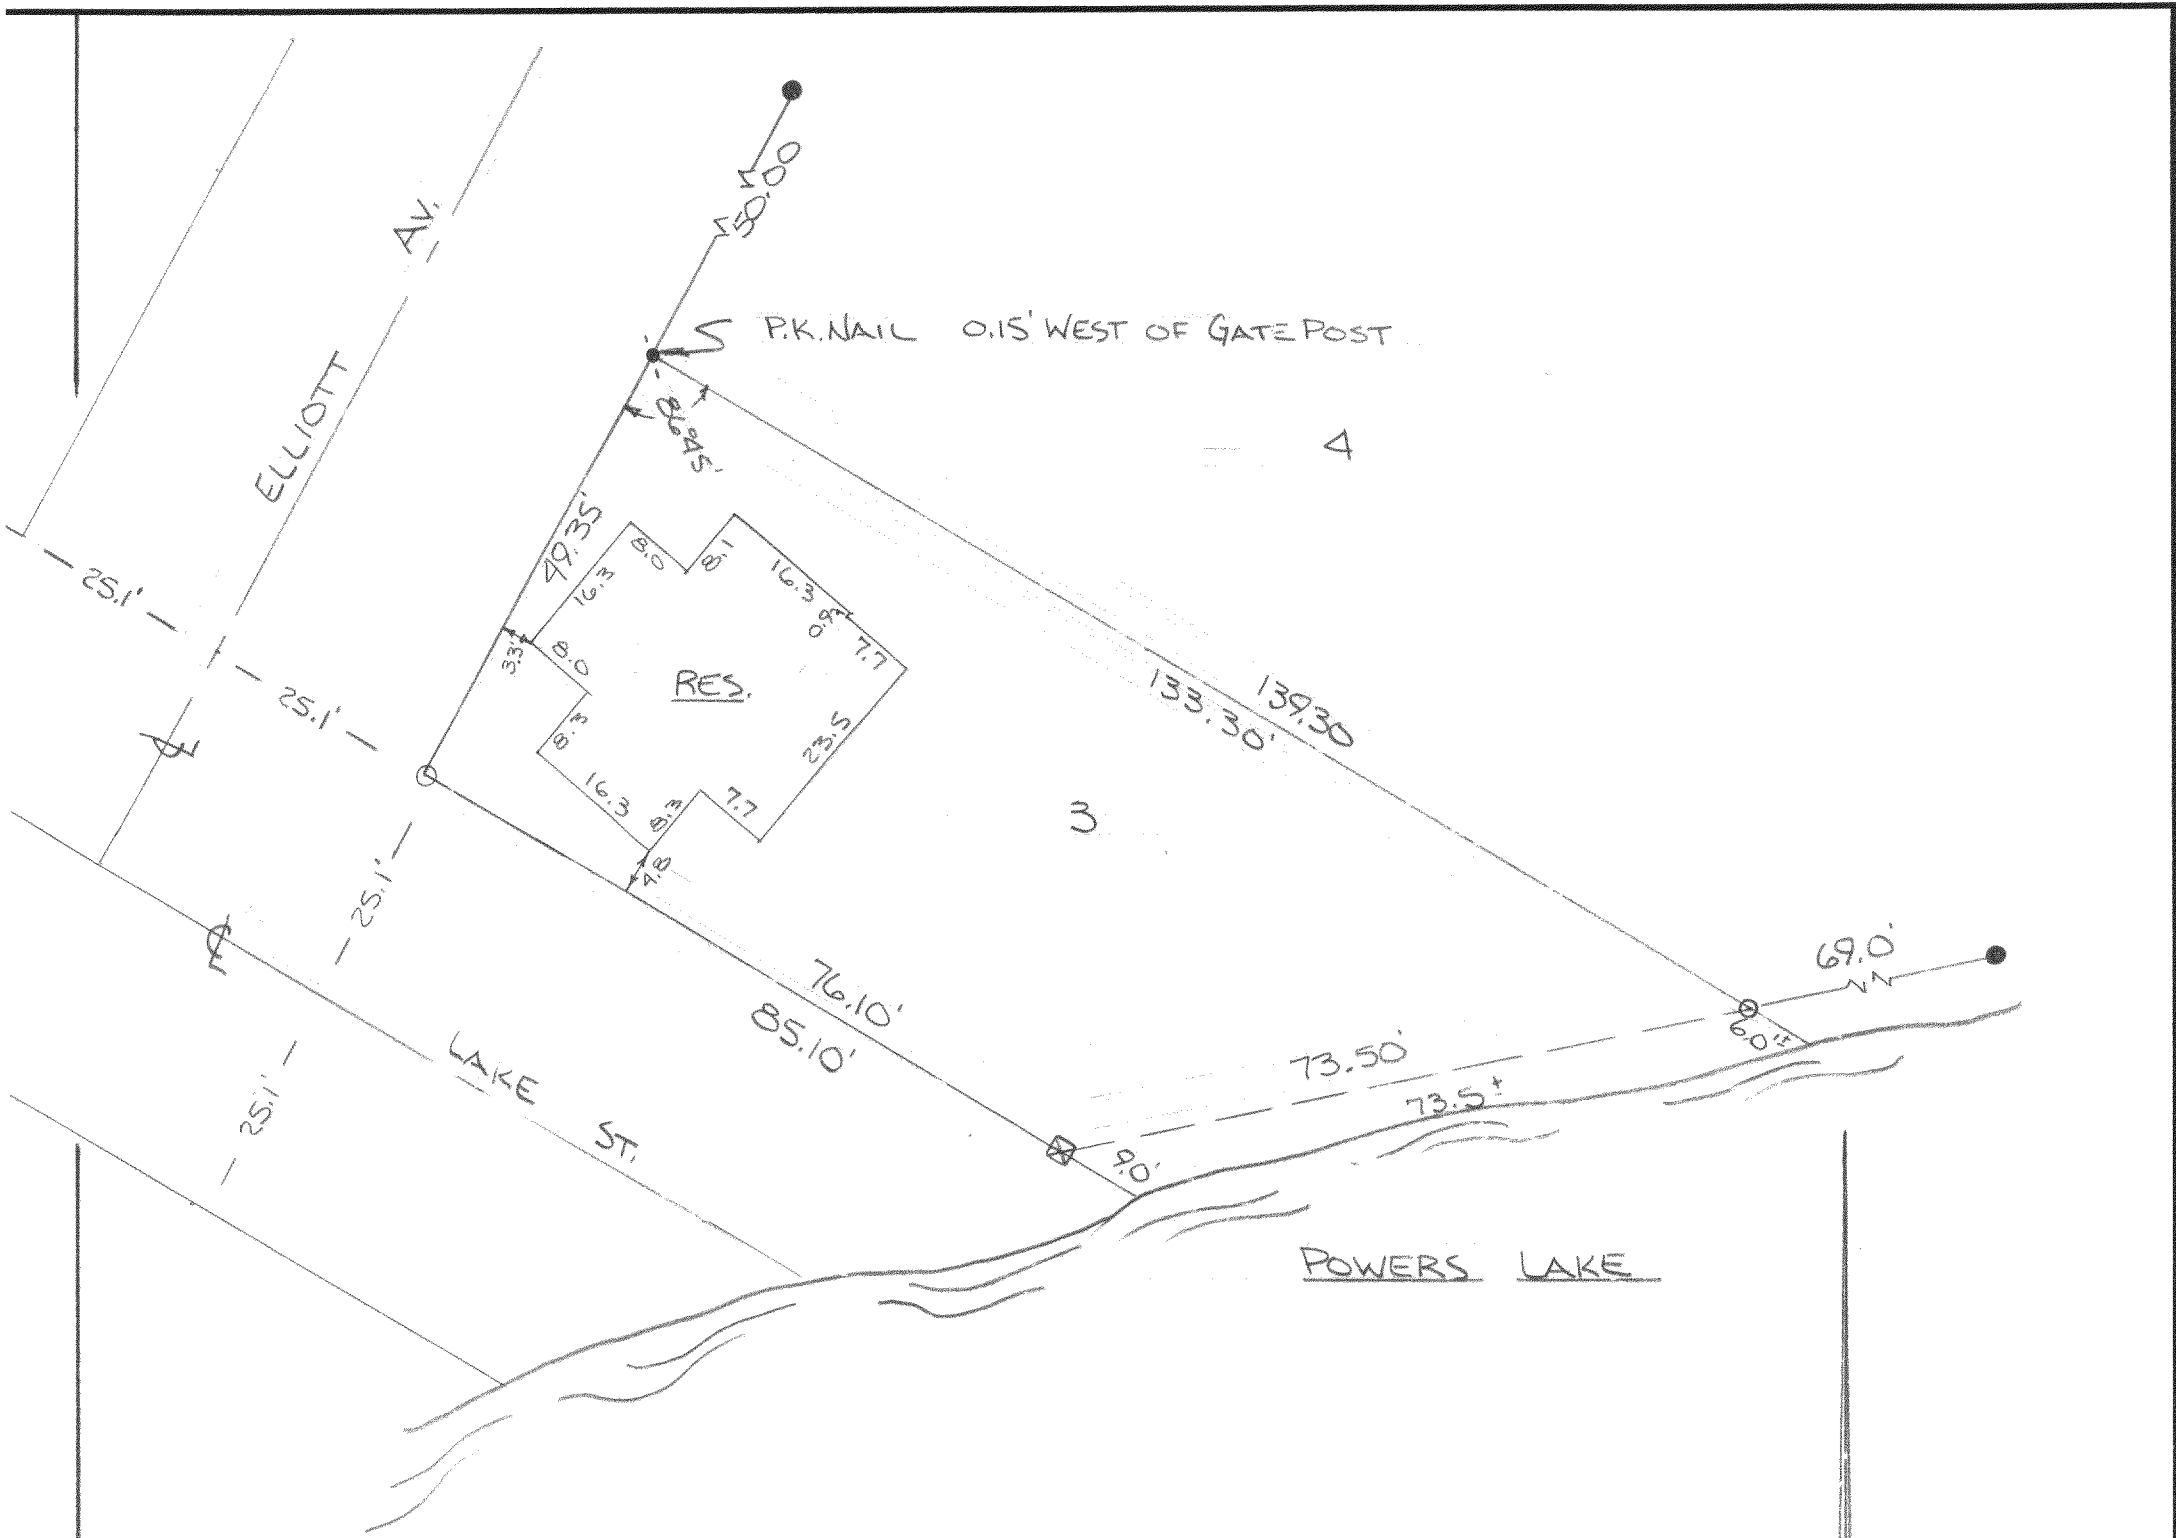

LEGEND

- INDICATES IRON PIPE FOUND
- INDICATES IRON PIPE SET
- ⊗ INDICATES CONCRETE MONUMENT
- INDICATES P.K. NAIL

DESCRIPTION:

Lot three (3) of Wm. Elliott's Powers Lake Subdivision, a subdivision located in the NE $\frac{1}{4}$ of Section 13, T1N, R18E, Walworth County, Wisconsin.

CERTIFICATE:

I, Joseph M. Biagi, surveyor, do hereby certify that I have surveyed the property hereon described.

DATE:

November 7, 1973

Joseph M. Biagi
Elkhorn, Wisconsin

ELS #12

LOT 3 WM. ELLIOTT'S POWERS LAKE SUB.		
SCALE: 1" = 20'-0"	APPROVED BY:	DRAWN BY GW
DATE: NOV. 7, 1973		REVISED
		DRAWING NUMBER
		125-73

ME - 3

118-27B