


PREPARED FOR:
BRIAN WRIGHT
1933 BRIAR RIDGE RD.
LAKE GENEVA, WI 53147

PLAT OF

PATHFINDER SURVEYING INC.
W2888 KRUEGER ROAD, UNIT "D"
LAKE GENEVA, WI, 53147
262-248-3697



PARCEL NUMBER 18 OF WILDERLAND UNRECORDED SUBDIVISION, LOCATED
IN THE NORTHEAST 1/4, OF THE NORTHWEST 1/4 OF SECTION 8, TOWN 1
NORTH, RANGE 18 EAST, WALWORTH COUNTY, WISCONSIN.

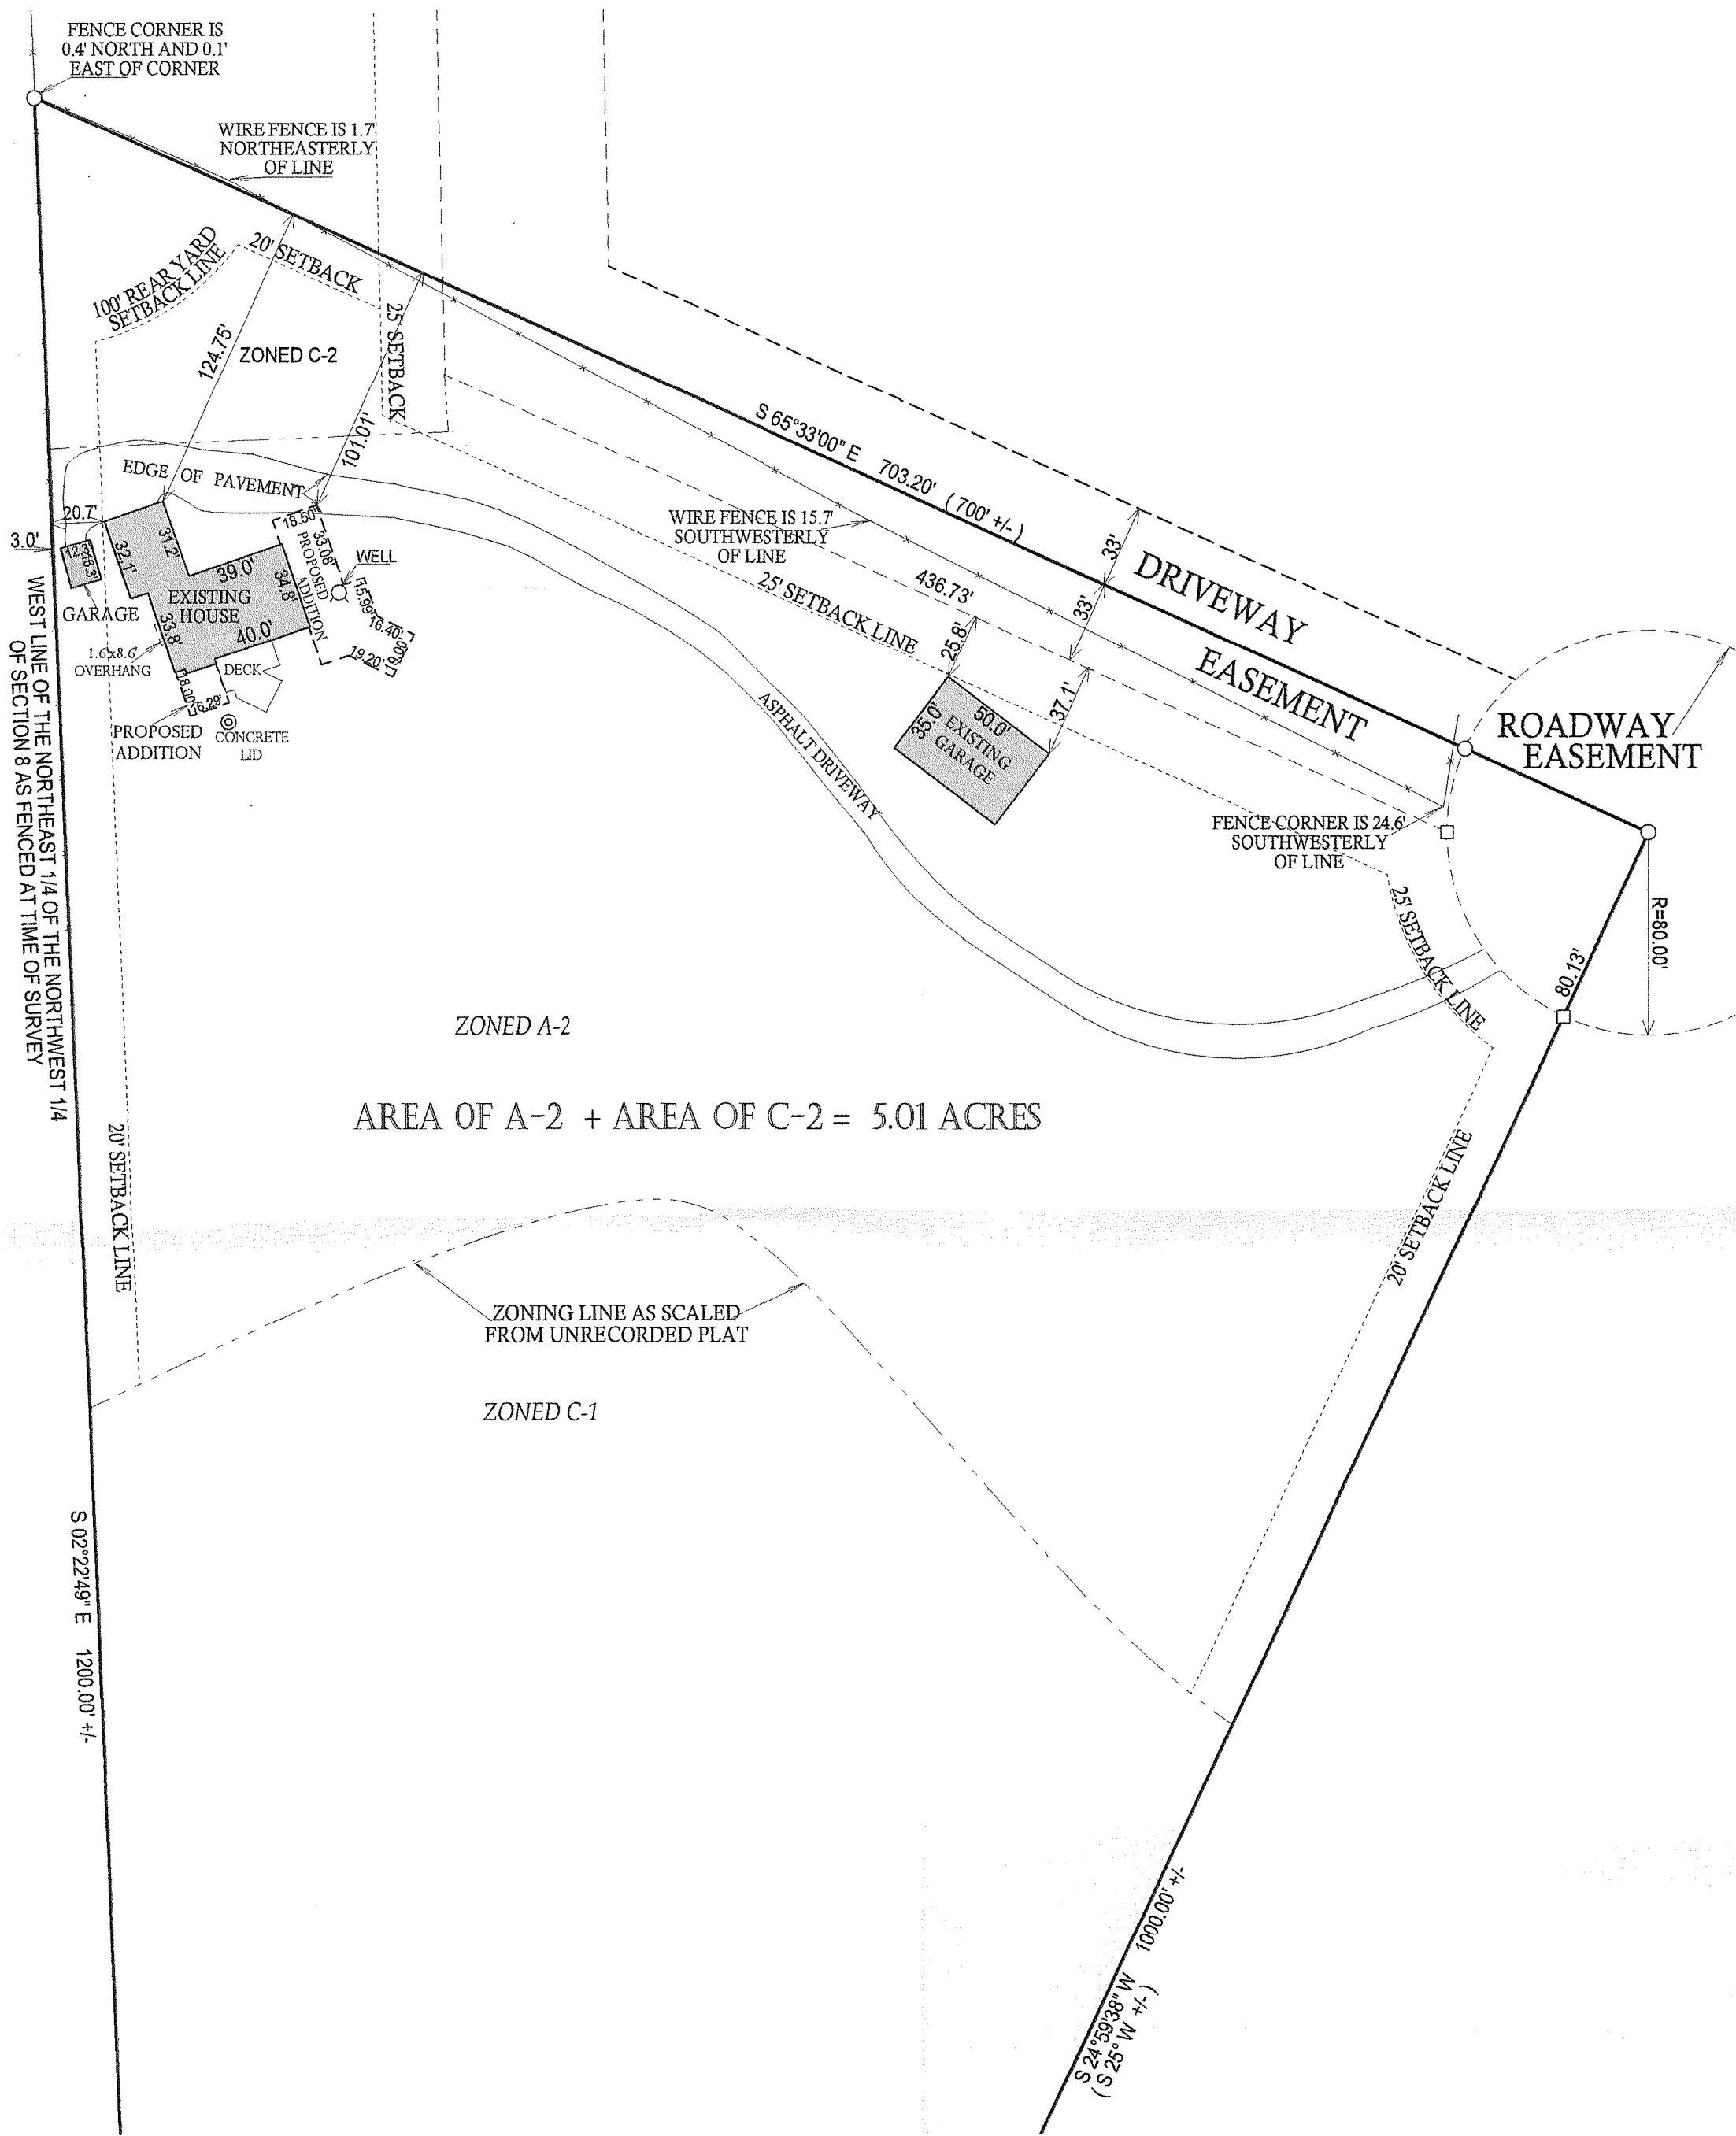

AREA OF A-2 + AREA OF C-2 = 5.01 ACRES

ZONING LINE AS SCALED
FROM UNRECORDED PLAT

ZONED C-1

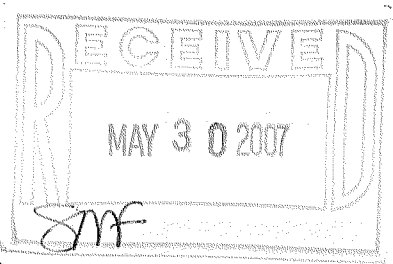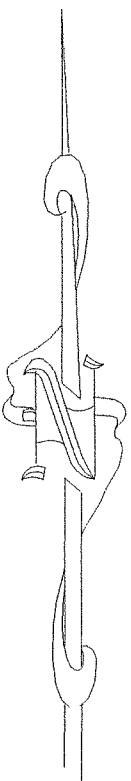

- () = RECORDED AS
- = FOUND IRON BAR
- = FOUND IRON PIPE
- = SET IRON PIPE
- = SET IRON BAR


SCALE: 1" = 60'

JOB #: 06-362

TAX ID #: MW 00018

NOTE: BASIS OF BEARING IS RECORD PLAT.

COMPARE LEGAL DESCRIPTION ABOVE AND DRAWING WITH DEED. FOR BUILDING RESTRICTIONS AND
EASEMENTS NOT SHOWN, REFER TO DEED, ABSTRACT SOURCES AND LOCAL MUNICIPAL CODES. NOTIFY
THE SURVEYOR IMMEDIATELY OF ANY DISCREPANCY.

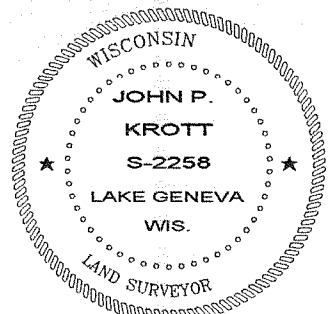

JOHN P. KROTT S - 2258
Wisconsin Registered Land Surveyor
(original if signed in red)

REVISED 3-2-2007, GARAGE ASBUILT / ADDITION
REVISED 9 / 28 / 2006
DATED THIS 8th DAY OF AUGUST, 2006.

118-2817