


PREPARED FOR
MILES SWANSON
PO. BOX 321
PELL LAKE WI. 53157

PLAT OF SURVEY


PATHFINDER SURVEYING INC.
W2888 KRUEGER RD. UNIT "D"
LAKE GENEVA WI. 53147
(262) 248-3697

- OF -

LOTS 1578 THRU 1582 BLOCK 25 PELL LAKE HIGHLANDS
LOCATED IN TOWN 1 NORTH, RANGE 18 EAST,
WALWORTH COUNTY, WISCONSIN.

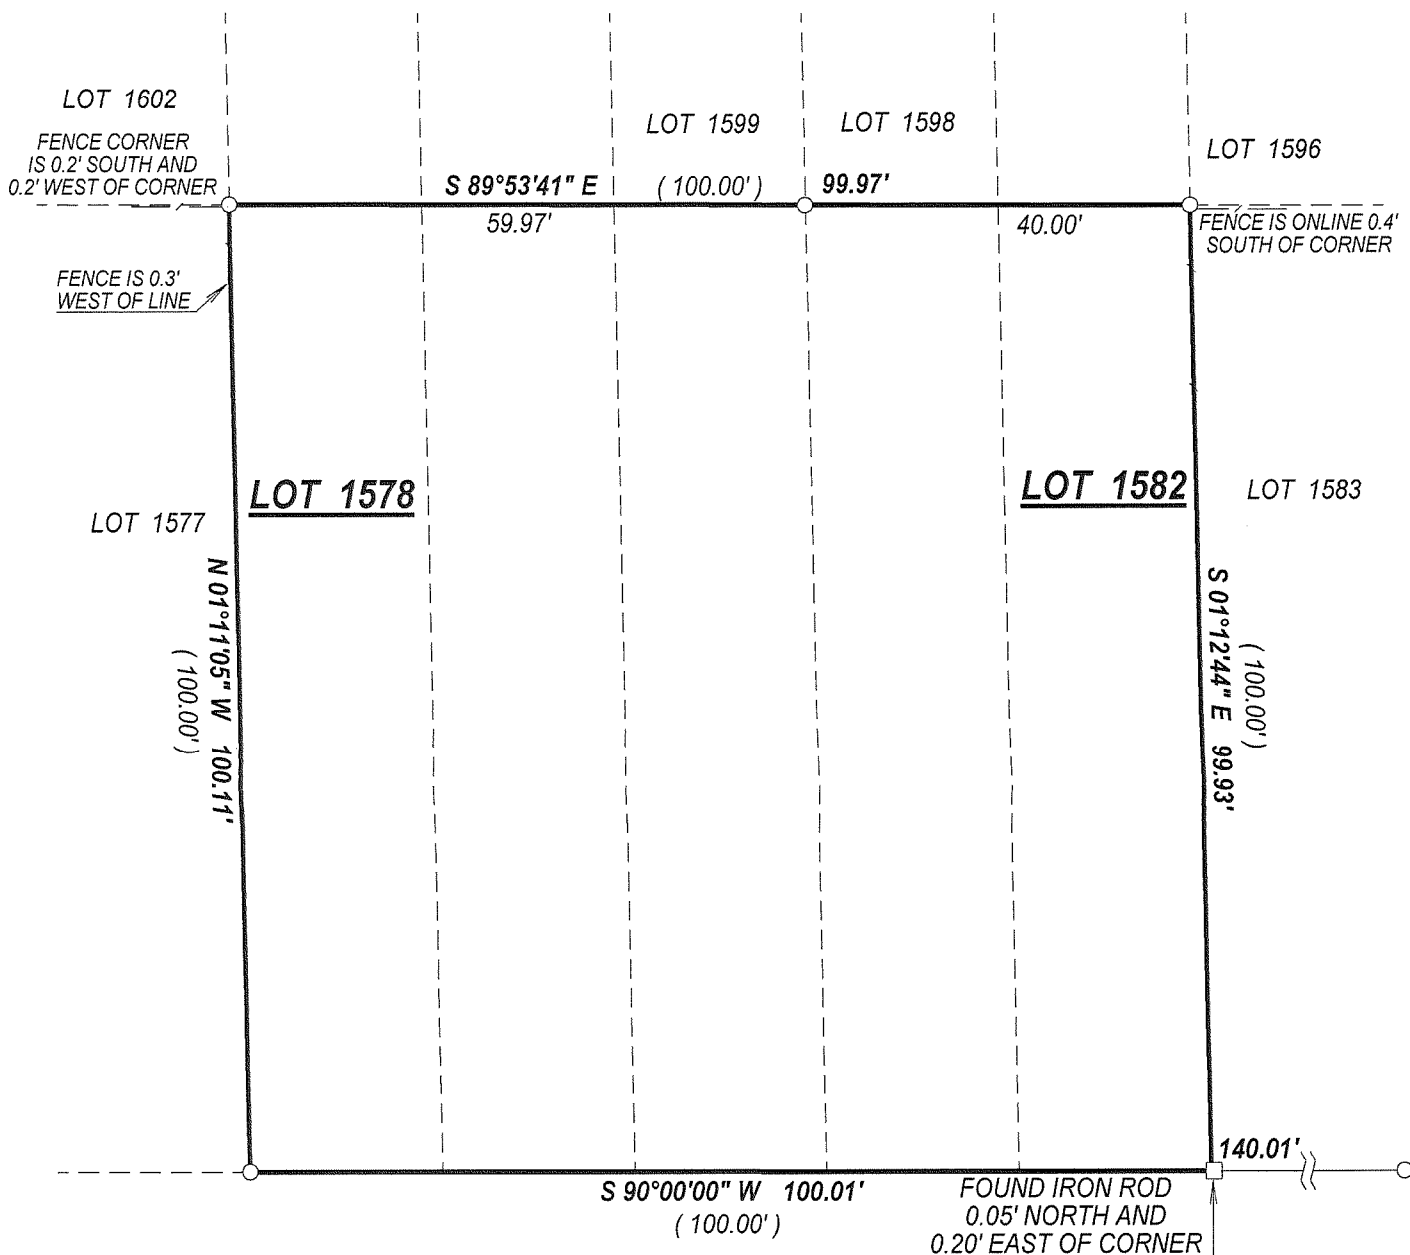

C.L. HIGHLAND BOULEVARD
(50' WIDE)

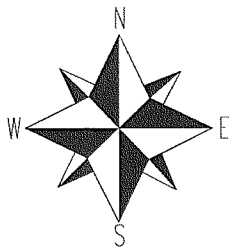

() = recorded as

□ = found iron bar

○ = found iron pipe


● = set iron pipe

■ = set iron bar

SCALE 1" = 20'

JOB # 07-216


TAX ID # MPLH00270

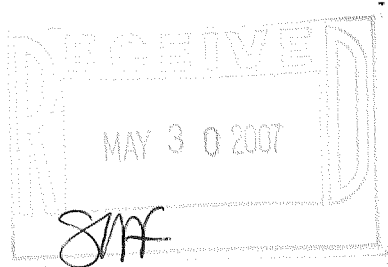

COMPARE LEGAL DESCRIPTION ABOVE AND DRAWING WITH DEED. FOR BUILDING RESTRICTIONS AND EASEMENTS NOT SHOWN, REFER TO DEED, ABSTRACT SOURCES AND LOCAL MUNICIPAL CODES. NOTIFY THE SURVEYOR IMMEDIATELY OF ANY DISCREPANCY.

"I hereby certify that I have surveyed the above described property and that the above map, to the best of my knowledge and belief, is a true representation thereof and shows the size and location of all visible structures, apparent easements and encroachments if any."

This survey is made for the present owners of the property, and those who purchase, mortgage, or guarantee the title thereto, within one year from the date hereof.

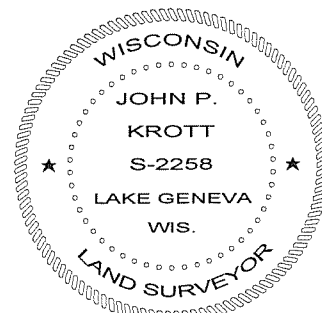

John P. Krott

JOHN KROTT S - 2258
Wisconsin Registered Land Surveyor
(original if signed in red)

DATED THIS THE 25th DAY OF MAY 2007.

118-2824