

PREPARED FOR  
MIKE RILEY  
5859 W WARWICK  
CHICAGO IL. 60634

# PLAT OF SURVEY


- OF -

LOTS 519 THRU 523 OF BLOCK 9 OF PELL LAKE ADDITION,  
A SUBDIVISION LOCATED IN SECTIONS 13 AND 23,  
T1N, R18E, WALWORTH COUNTY, WISCONSIN.

PATHFINDER SURVEYING INC.  
W2888 KRUEGER RD. UNIT "D"  
LAKE GENEVA WI. 53147  
(262) 248-3697

## C.L. GREEN ROAD

(40' WIDE UNIMPROVED ROAD)

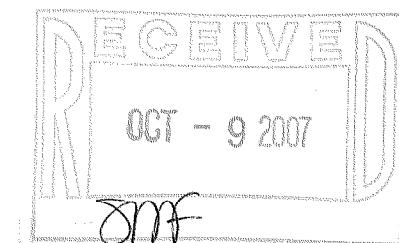

LOT 502


LOT 501

BLOCK 9

LOT 497

SHED

SHED

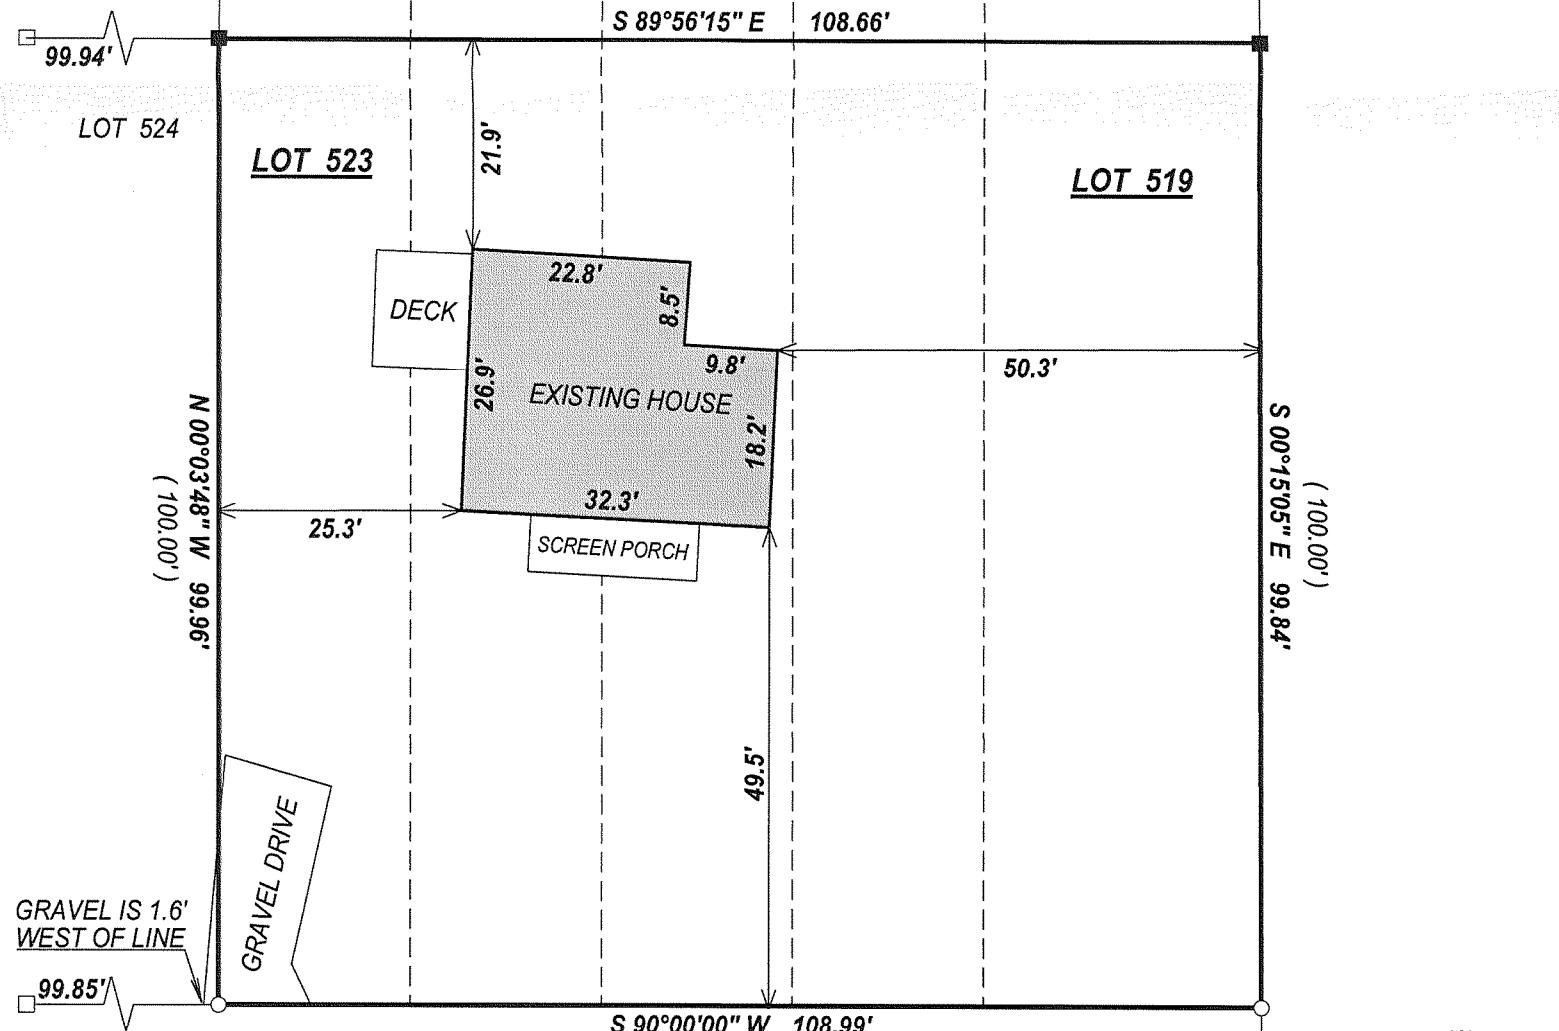

( ) = RECORDED AS

= FOUND IRON BAR

= FOUND IRON PIPE

= SET IRON BAR

SCALE 1" = 20'

JOB # 07-303

TAX ID # MPLA00106

## C.L. FLORENCE ROAD

(50' WIDE)

COMPARE LEGAL DESCRIPTION ABOVE AND DRAWING WITH DEED. FOR BUILDING RESTRICTIONS AND  
EASEMENTS NOT SHOWN, REFER TO DEED, ABSTRACT SOURCES AND LOCAL MUNICIPAL CODES. NOTIFY  
THE SURVEYOR IMMEDIATELY OF ANY DISCREPANCY.

"I hereby certify that I have surveyed the above described property and that  
the above map, to the best of my knowledge and belief, is a true representation  
thereof and shows the size and location of all visible structures, apparent  
easements and encroachments if any."

This survey is made for the present owners of the property, and those who  
purchase, mortgage, or guarantee the title thereto, within one year from  
the date hereof.

JOHN KROTT S-2258  
Wisconsin Registered Land Surveyor  
(original if signed in red)

DATED THIS THE 10th DAY OF JULY 2007.

JOHN KROTT S-2258

Wisconsin Registered Land Surveyor

(original if signed in red)

DATED THIS THE 10th DAY OF JULY 2007.

118-2871