



FARRIS, HANSEN & ASSOCIATES, INC.

ENGINEERING — ARCHITECTURE — SURVEYING
 7 RIDGWAY COURT — P.O. BOX 437 — ELKHORN, WISCONSIN 53121
 PHONE: (262) 723-2098 FAX: (262) 723-5886

ASSIGNED THE NORTH LINE OF LOT 2
 N 88°43'14"E

—WORK ORDERED BY—
 BEYERS BUILDERS
 36720 128TH
 TWIN LAKE, WISCONSIN 53181

OVERLOOK DRIVE

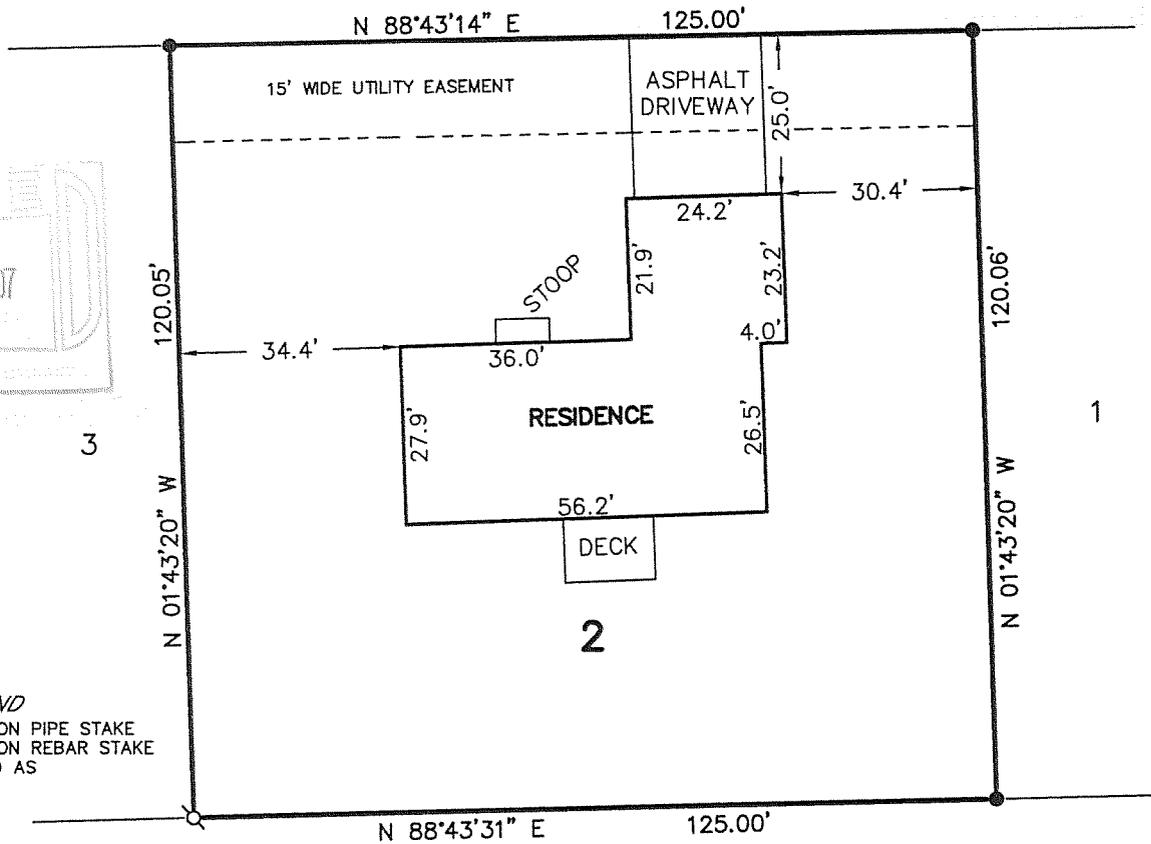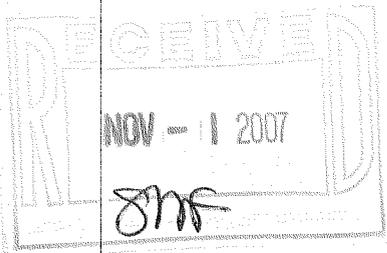

LEGEND
 ○—FOUND IRON PIPE STAKE
 ●—FOUND IRON REBAR STAKE
 (XXX)—RECORDED AS

PLAT OF SURVEY OF


Lot 2, Willow Estates, a subdivision located in the SE 1/4 of the NE 1/4 of Section 15, Town 1 North, Range 18 East. Said land being in the Town of Bloomfield, County of Walworth, and State of Wisconsin.

Tax Key No. MWB 00002
 Property Address: N1525 Overlook Drive

LEGAL DESCRIPTION OF RECORD TAKEN FROM TITLE COMMITMENT PROVIDED BY CLIENT



NOTE: COPIES OF THIS MAP TO WHICH THE FOLLOWING CERTIFICATE WILL APPLY SHOW THE SURVEYOR'S ORIGINAL SEAL AND SIGNATURE IN RED INK. COPIES BY ANY OTHER MEANS MAY HAVE ALTERATIONS WHICH DO NOT REPRESENT THE SURVEYOR'S WORK PRODUCT. I HEREBY CERTIFY THAT THE ABOVE DESCRIBED PROPERTY HAS BEEN SURVEYED UNDER MY DIRECTION AND THAT THE ABOVE MAP IS A TRUE REPRESENTATION THEREOF AND SHOWS THE SIZE AND LOCATION OF THE PROPERTY, ITS EXTERIOR BOUNDARIES, THE LOCATION OF ALL VISIBLE STRUCTURES, AND DIMENSIONS OF ALL PRINCIPLE BUILDINGS THEREON, BOUNDARY FENCES, APPARENT EASEMENTS, ROADWAYS, AND VISIBLE ENCROACHMENTS, IF ANY. THIS SURVEY IS MADE FOR THE USE OF THE PRESENT OWNERS OF THE PROPERTY, AND ALSO THOSE WHO PURCHASE, MORTGAGE, OR GUARANTEE THE TITLE THERETO WITHIN ONE YEAR FROM THE DATE HEREOF.

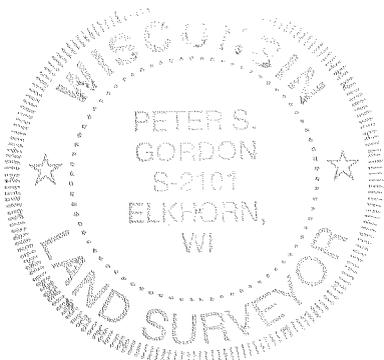

DATED: 10/19/2007

Peter S. Gordon
 PETER S. GORDON

PROJECT: 7476
 DATE: 10/19/2007
 SHEET 1 OF 1

MWE-2
 OCT 19 2007

118-2876