


BROOKWOOD ACRES SUBDIVISION

LOT 9

LOCATED IN THE SW 1/4 OF SECTION 14,
TOWN 1 NORTH, RANGE 18 EAST,
WALWORTH COUNTY, WISCONSIN

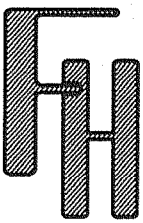

WORK ORDERED BY -
FRANK CASELLA
1016 HOOKS LANE
MCHEENRY, IL 60050


FARRIS, HANSEN & ASSOCIATES, INC.
ENGINEERING - ARCHITECTURE - SURVEYING
7 RIDGWAY COURT P.O. BOX 437
ELKHORN, WISCONSIN 53121
OFFICE: (262) 723-2098 FAX: (262) 723-5886

REVISIONS
8/15/04 - LK
CHANGED TO
3-CAR GARAGE
9/11/2007-KB
TO SHOW SIZE
AND LOCATION
OF AS-BUILT
RESIDENCE


PROJECT NO.
5048.09
DATE:
07/30/04
SHEET NO.
1 OF 1

VIOLET ROAD

66' WIDE R.O.W. DEDICATED TO THE PUBLIC

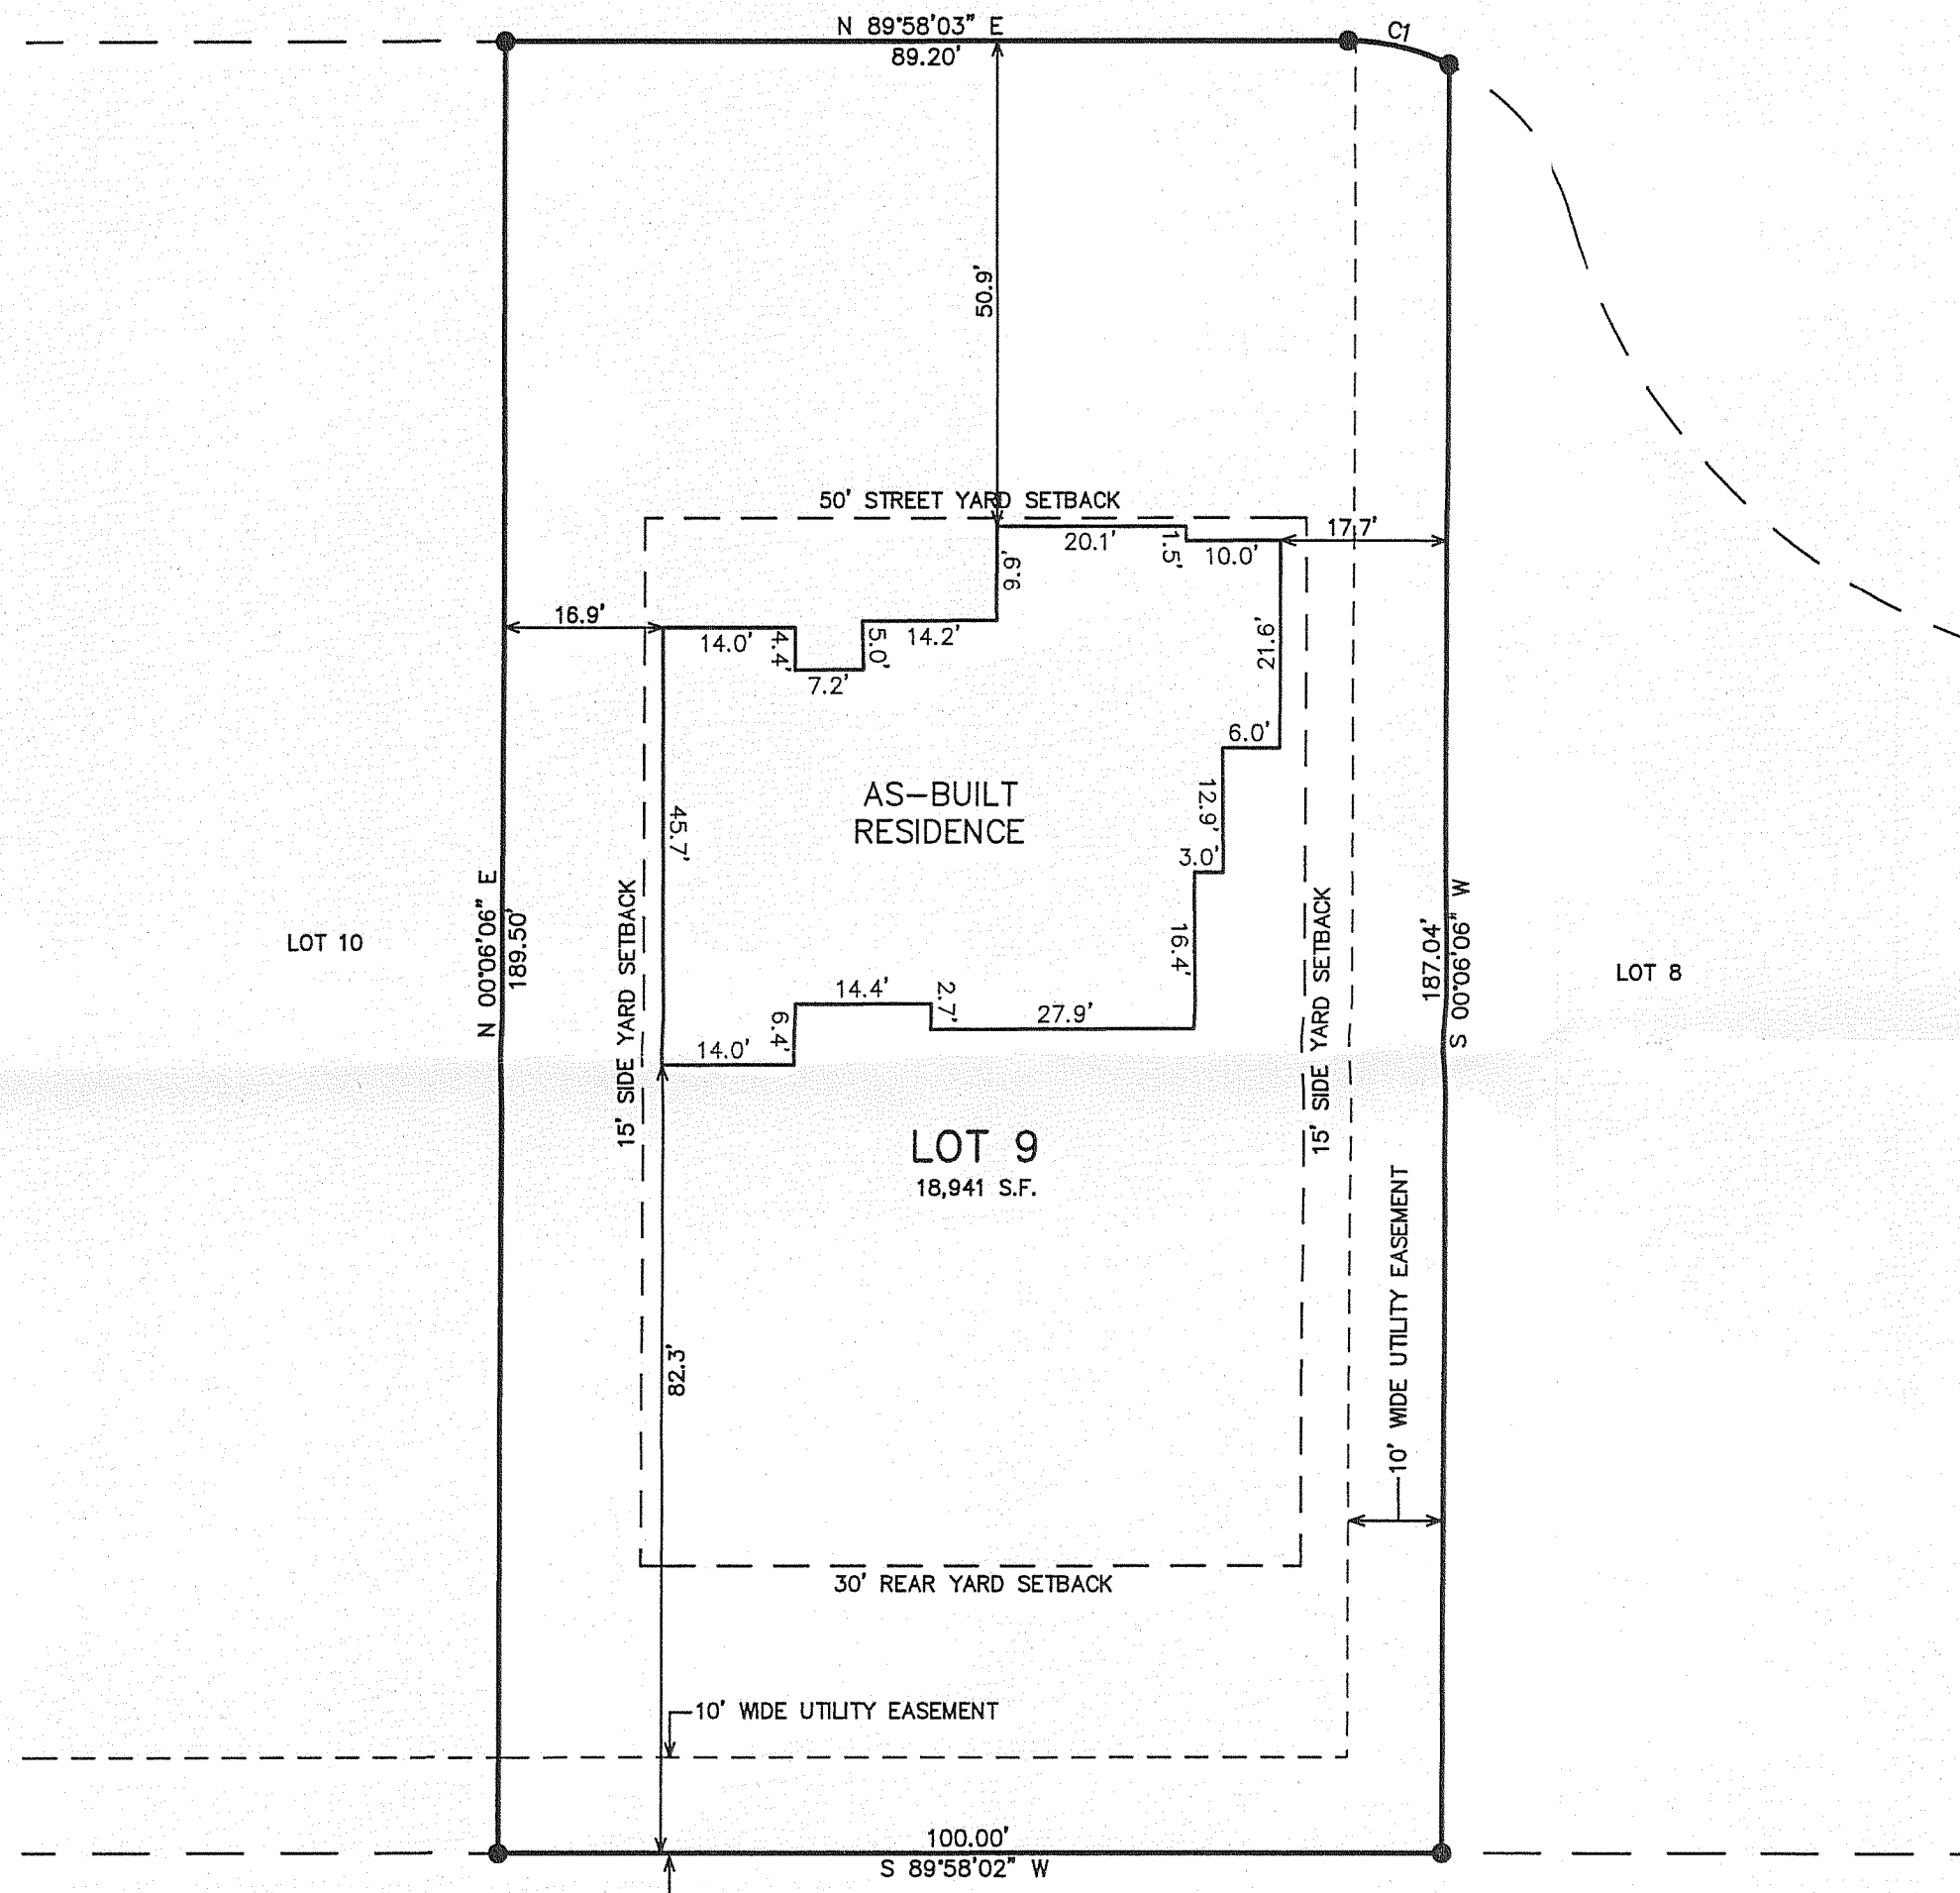

ASSIGNED SOUTH LINE OF THE SW 1/4 OF SECTION 14-1-18
N 89°57'45" W (PER C.S.M. 2919)

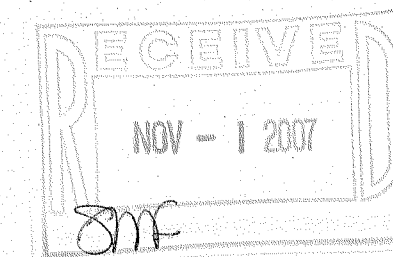

NOTE: COPIES OF THIS MAP TO WHICH THE FOLLOWING CERTIFICATE WILL APPLY SHOW THE SURVEYOR'S ORIGINAL SEAL AND SIGNATURE IN RED INK. COPIES BY ANY OTHER MEANS MAY HAVE ALTERATIONS WHICH DO NOT REPRESENT THE SURVEYOR'S WORK PRODUCT.

I HEREBY CERTIFY THAT THE ABOVE DESCRIBED PROPERTY HAS BEEN SURVEYED UNDER MY DIRECTION AND THAT THE ABOVE MAP IS A TRUE REPRESENTATION THEREOF AND SHOWS THE SIZE AND LOCATION OF THE PROPERTY AND ITS EXTERIOR BOUNDARIES. THIS SURVEY IS MADE FOR THE USE OF THE PRESENT OWNERS OF THE PROPERTY, AND ALSO THOSE WHO PURCHASE, MORTGAGE, OR GUARANTEE THE TITLE THERETO WITHIN ONE YEAR FROM THE DATE HEREOF.

DATED: JULY 30, 2004


Peter S. Gordon
PETER S. GORDON R.L.S. 2101



LEGEND

● = SET IRON REBAR STAKE
(XXX) = RECORDED AS

CURVE	ARC	RADIUS	CHORD LENGTH	CHORD BEARING
C1	11.17	25.00	11.07	S 77°14'00" E

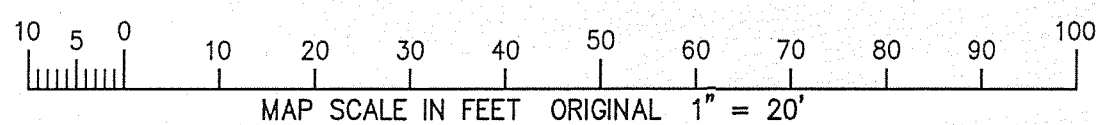

9/11/2007 X:\Projects\5048.DCAD\INDV\LOTS\ASBL\LOT_9

MBRA-9

118-2877