


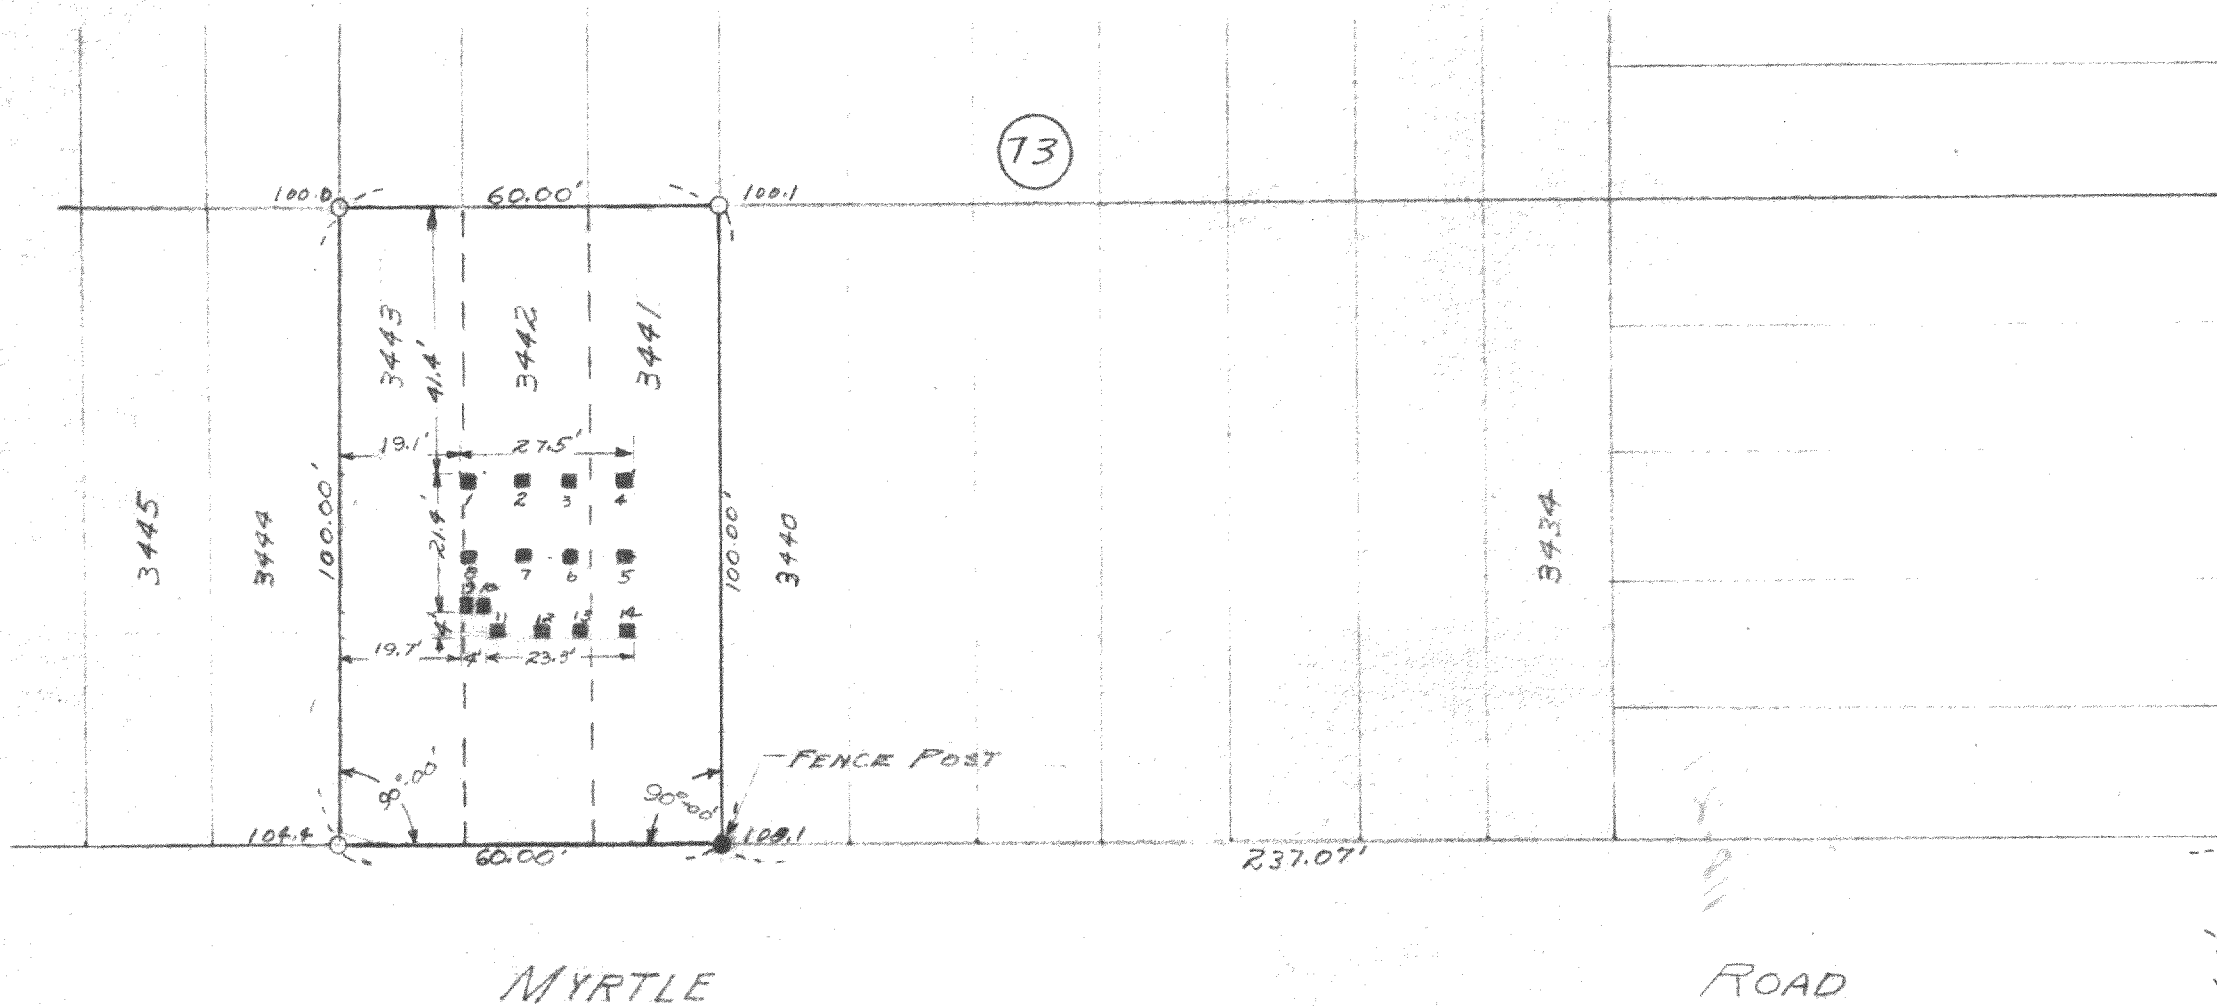

SCALE 1"=30'
 O IRON PIPE
 ■ CONC. BLOCK PIER

ELEVATION TOP OF CONC. BLOCK PIERS		
PIER NO.	TOP OF PIER	GROUND
1	104.12	101.1
2	103.58	101.3
3	103.45	101.6
4	103.75	101.8
5	104.06	102.6
6	103.63	102.2
7	103.48	102.0
8	103.81	101.7
9	103.78	102.1
10	103.84	102.2
11	103.80	102.6
12	103.41	
13	103.67	
14	104.15	103.4

BENCH MARK - TOP OF PIER NO. 1
 ELEVATION 104.12

STATE OF WISCONSIN) ss
 COUNTY OF WALWORTH)

I, LLOYD L. JENSEN, DO HEREBY CERTIFY THAT THE ABOVE PLAT IS A TRUE AND CORRECT PLAT OF A SURVEY MADE ON NOVEMBER 28, 1950, OF PROPERTY LEGALLY DESCRIBED AS FOLLOWS:

COMMENCING AT THE SOUTHEAST CORNER OF BLOCK 73 OF SECTION 3 OF PELL LAKE SUBDIVISION, THENCE WEST 237.07' TO THE PLACE OF BEGINNING. THENCE CONTINUE WEST 60.00', THENCE NORTH 100.00', THENCE EAST 60.00', THENCE SOUTH 100.00' TO THE PLACE OF BEGINNING. SAID PROPERTY BEING LOTS 3441, 3442 & 3443 OF BLOCK 73, OF WALWORTH COUNTY, WISCONSIN.

SAID PLAT SHOWS THE LOCATION AND DIMENSIONS OF ALL BUILDING IMPROVEMENTS THEREON.

NOVEMBER 28, 1950

Lloyd L. Jensen
 COUNTY SURVEYOR

(Lots 3441 - 3443 incl)