

PREPARED FOR
KRUIZAN CONSTRUCTION
2080 HAFPS ROAD
GENOA CITY WI. 53128

KROTT SURVEYING INC.


N3705 WILLOW BEND LANE
LAKE GENEVA WI. 53147
PHONE # (262)248-3697
FAX # (262)249-0639

PLAT OF SURVEY

-OF-

LOTS 5764 THRU 5769 BLOCK 108, OF SECTION 3 OF PELL
LAKE SUBDIVISION LOCATED IN SECTION 15, TOWN 1
NORTH, RANGE 18 EAST, WALWORTH COUNTY, WISCONSIN.

BLOCK 108

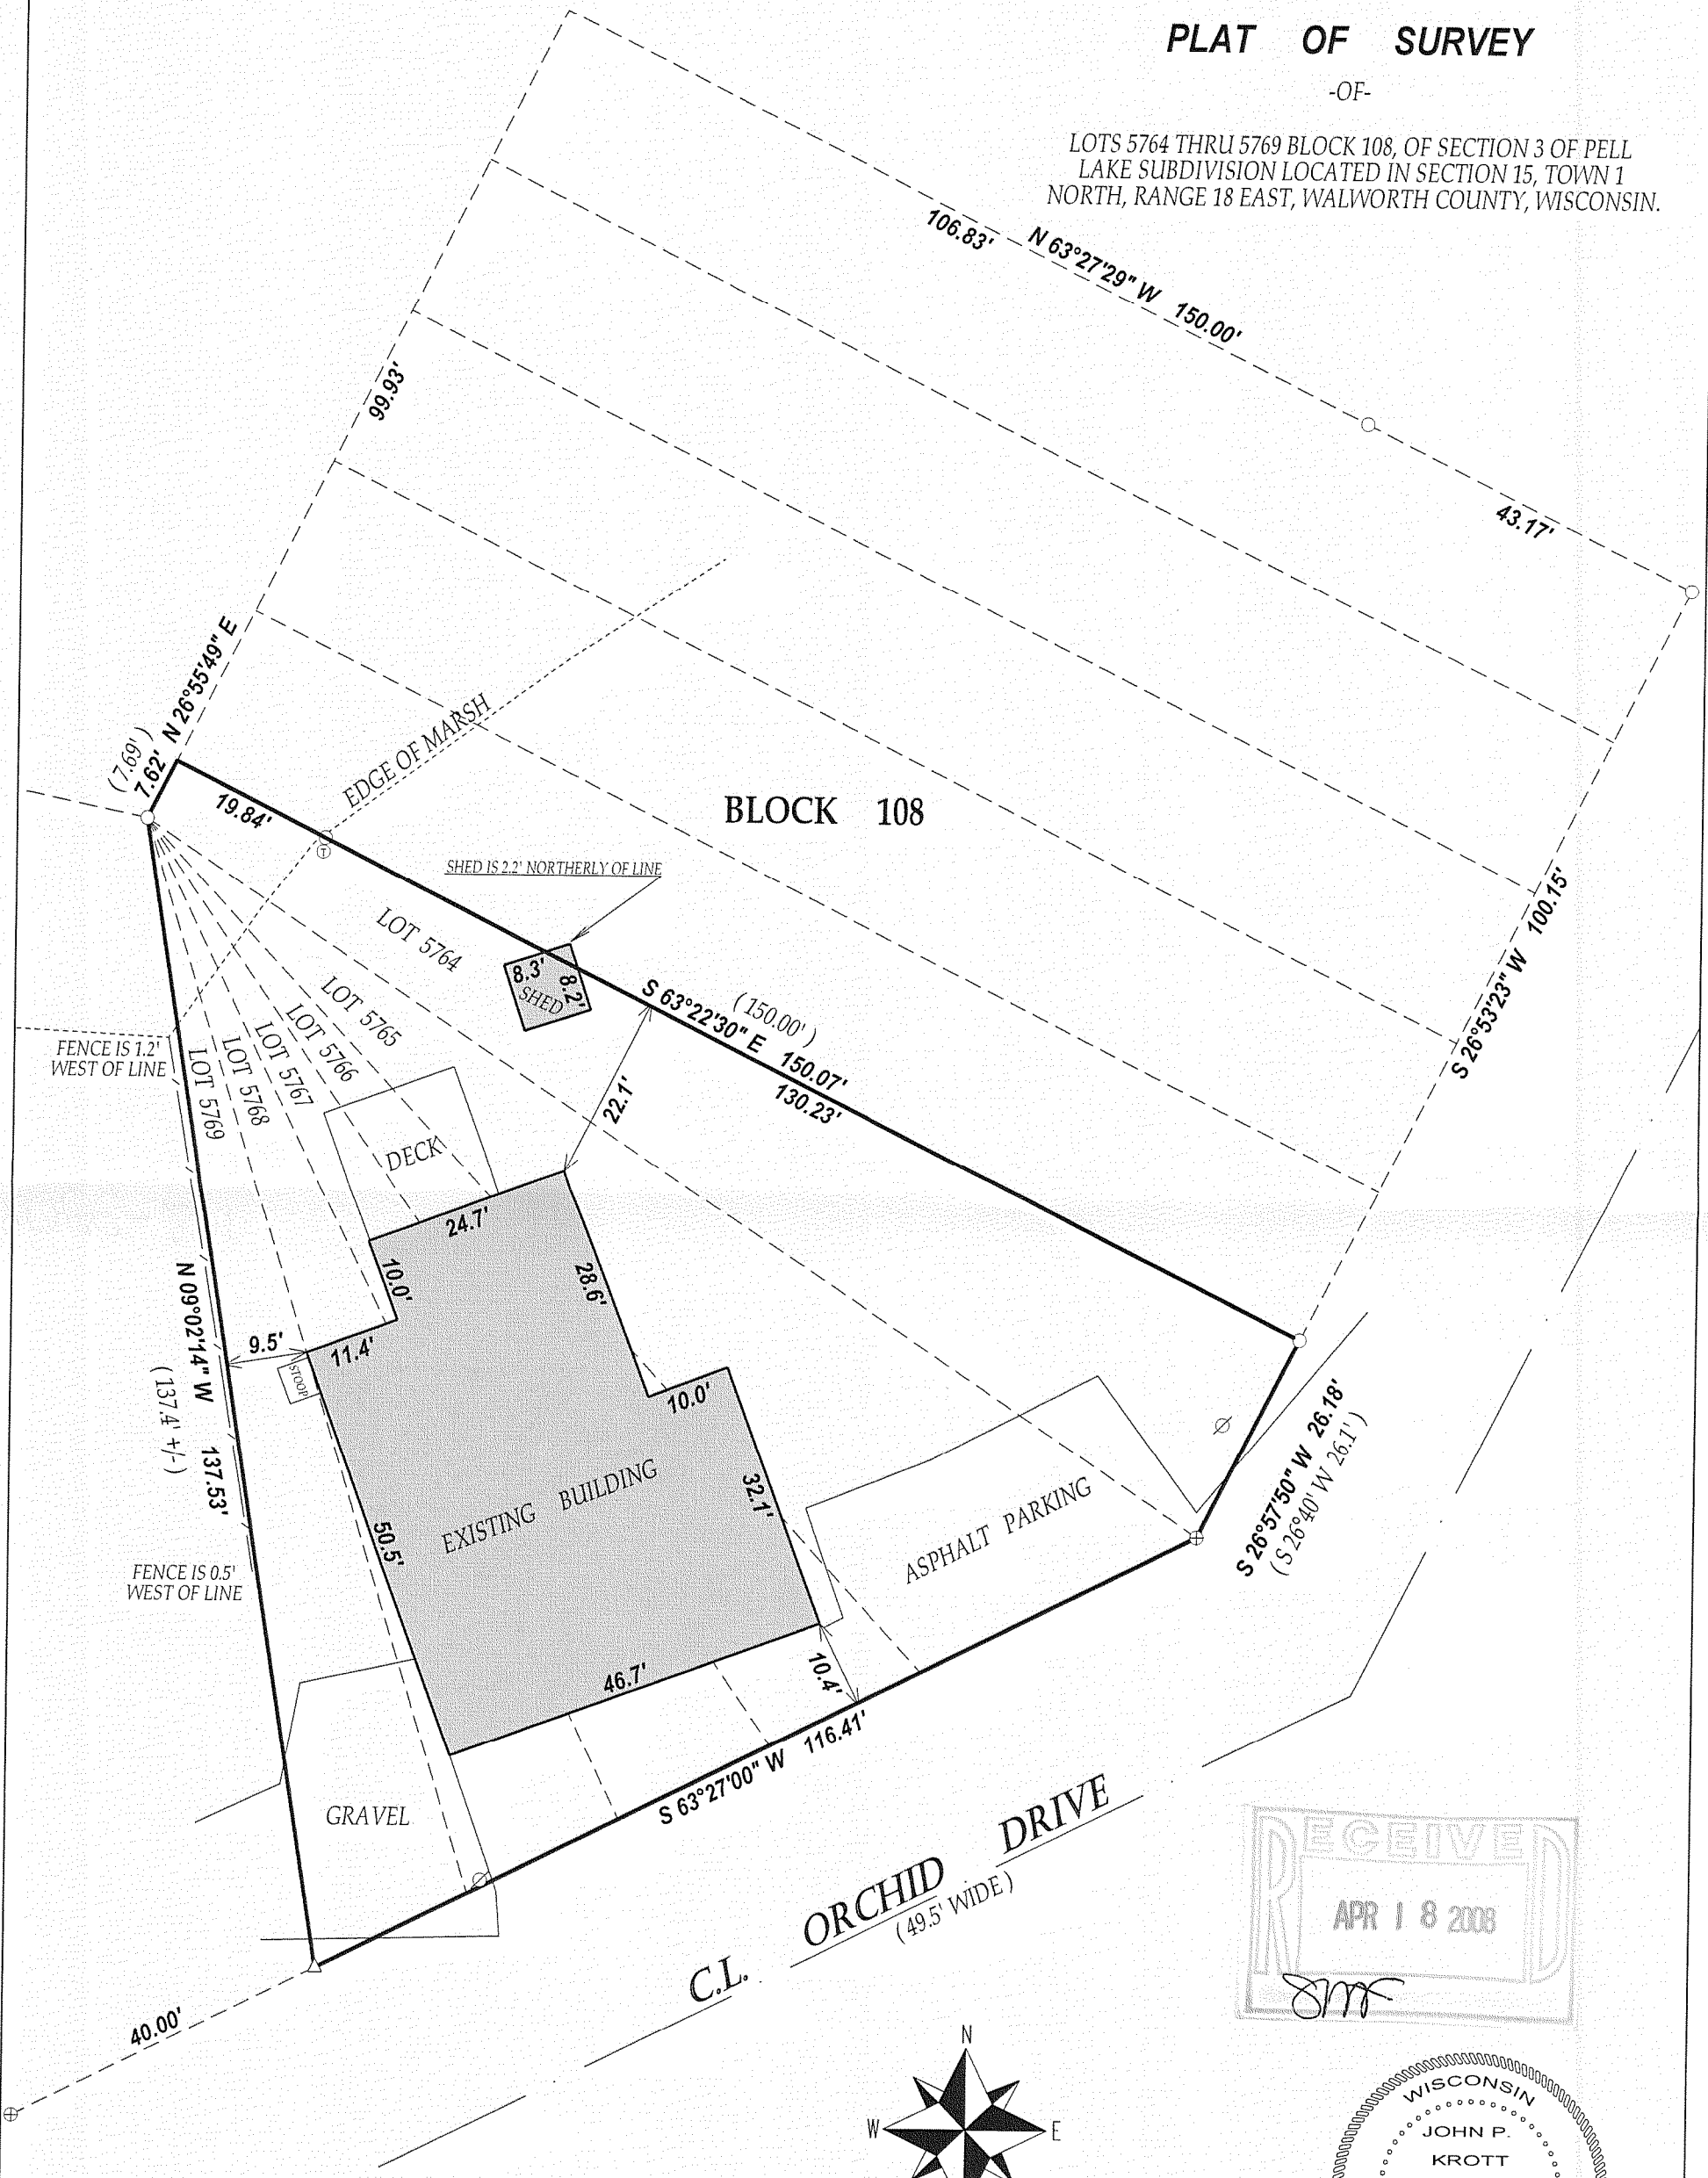

LEGEND

- FOUND IRON PIPE
- ⊕ FOUND RAILROAD SPIKE
- △ SET P.K. NAIL
- ⊗ POWER POLE
- ⊙ TELEPHONE PEDISTAL

(xx) RECORDED AS

SCALE 1" = 30'



0 20 40 60

COMPARE LEGAL DESCRIPTION ABOVE AND DRAWING WITH DEED.
FOR BUILDING RESTRICTIONS AND EASEMENTS NOT SHOWN, REFER
TO DEED, ABSTRACT SOURCES AND LOCAL MUNICIPAL CODES. NOTIFY
THE SURVEYOR IMMEDIATELY OF ANY DISCREPANCY.

"I hereby certify that I have surveyed the above described property and that
the above map is a true representation thereof and shows the size and
location of all visible structures, apparent easements and encroachments
if any."

This survey is made for the present owners of the property, and those who
purchase, mortgage, or guarantee the title thereto, within one year from
the date hereof.

JOB # 08-038 TAX ID # MPL01250A
DATED THIS THE 20th DAY OF MARCH 2008.

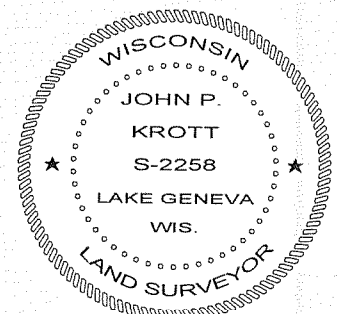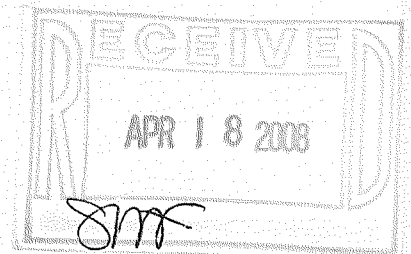

JOHN KROTT S - 2258
Wisconsin Registered Land Surveyor
(original if signed in red)

MPL - 1250A

118-2908