


FARRIS, HANSEN & ASSOCIATES, INC.
 ENGINEERING — ARCHITECTURE — SURVEYING
 7 RIDGWAY COURT — P.O. BOX 437 — ELKHORN, WISCONSIN 53121
 PHONE: (262) 723-2098 FAX: (262) 723-5886

—WORK ORDERED BY—
 TRACY FIRKING
 N1175 WALNUT ROAD
 PELL LAKE, WISCONSIN 53157



ASSIGNED THE NORTHEASTERLY LINE OF BLOCK 7
 S52°00'00"E

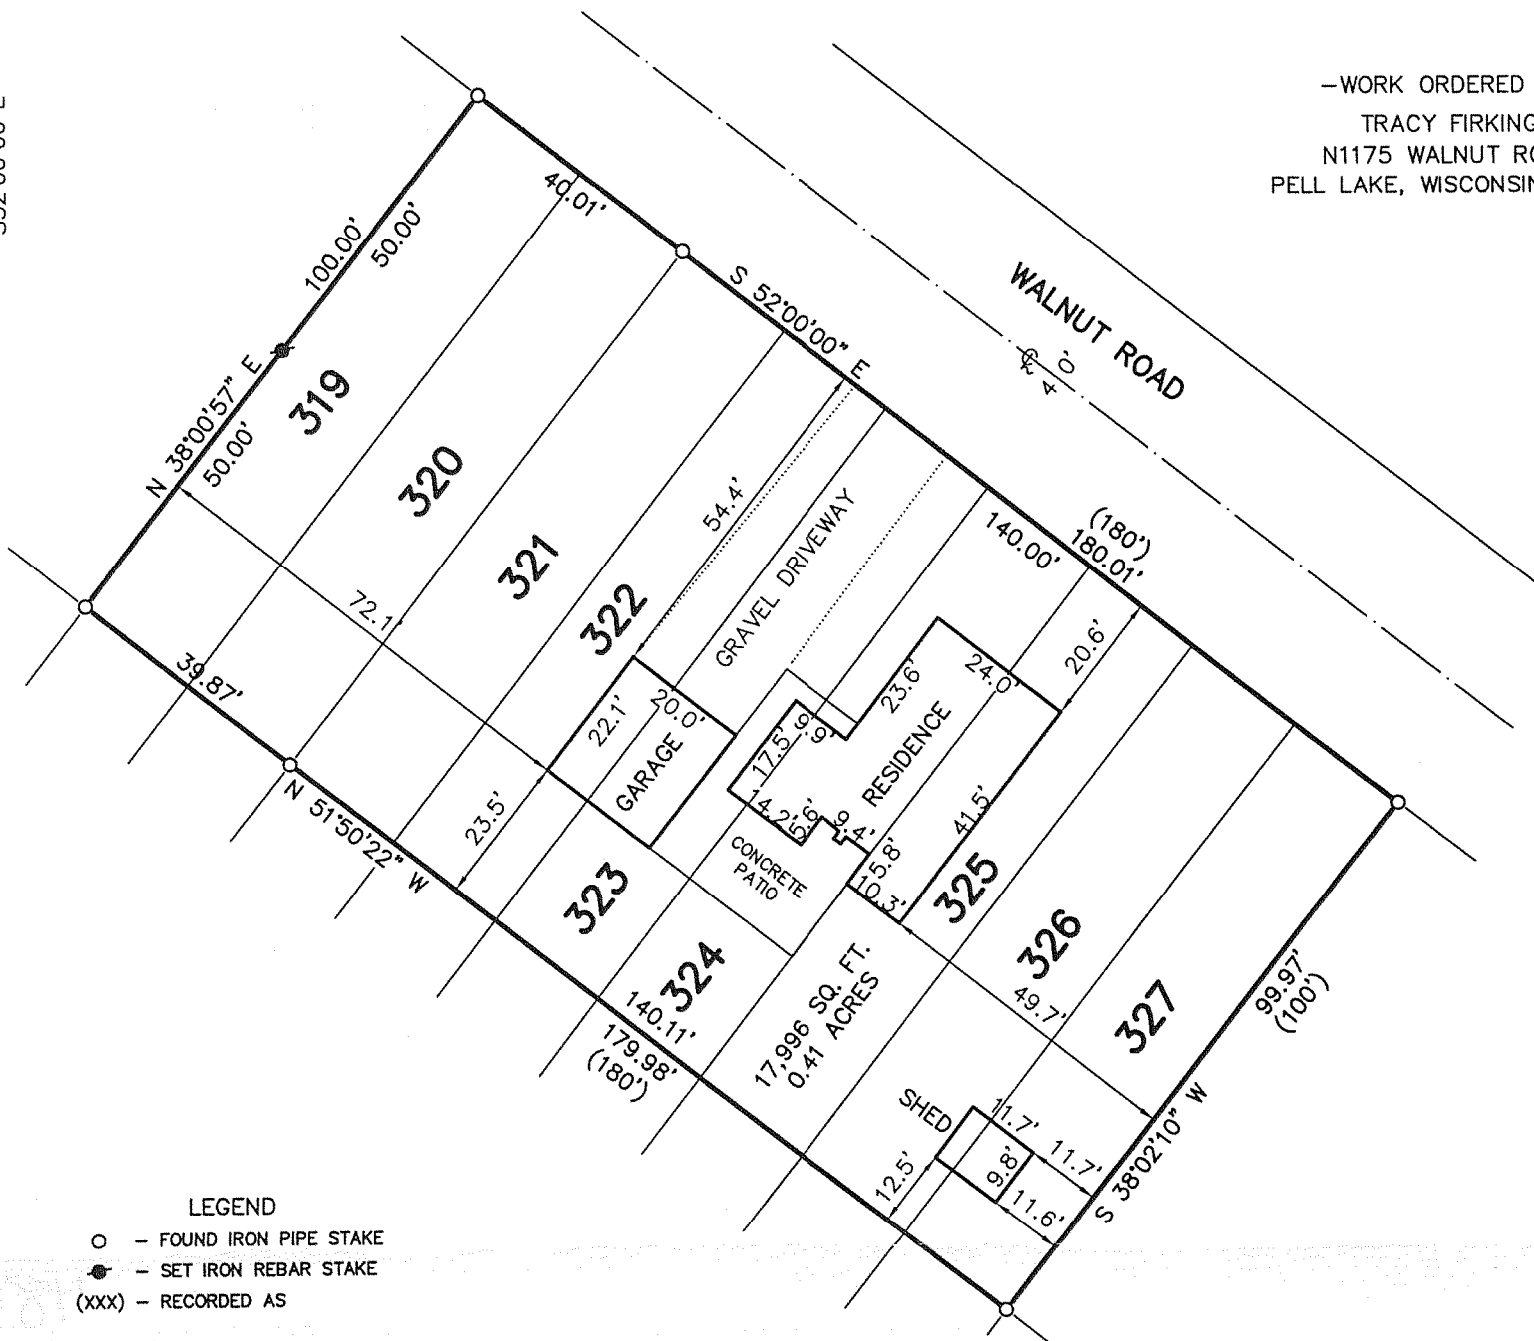

LEGEND
 ○ — FOUND IRON PIPE STAKE
 ● — SET IRON REBAR STAKE
 (XXX) — RECORDED AS

PLAT OF SURVEY OF

LOTS 319-327, BLOCK 7 OF SECTION 1 OF
 PELL LAKE SUBDIVISION, LOCATED IN THE NE 1/4
 OF SECTION 21, TOWN 1 NORTH, RANGE 18 EAST,
 WALWORTH COUNTY, WISCONSIN.

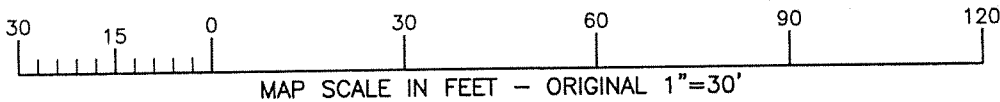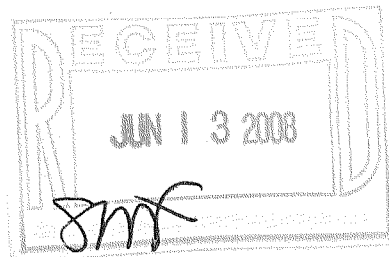

NOTE: COPIES OF THIS MAP TO WHICH THE FOLLOWING CERTIFICATE
 WILL APPLY SHOW THE SURVEYOR'S ORIGINAL SEAL AND SIGNATURE IN
 RED INK. COPIES BY ANY OTHER MEANS MAY HAVE ALTERATIONS
 WHICH DO NOT REPRESENT THE SURVEYOR'S WORK PRODUCT. I HEREBY
 CERTIFY THAT THE ABOVE DESCRIBED PROPERTY HAS BEEN SURVEYED
 UNDER MY DIRECTION AND THAT THE ABOVE MAP IS A TRUE
 REPRESENTATION THEREOF AND SHOWS THE SIZE AND LOCATION OF
 THE PROPERTY AND ITS EXTERIOR BOUNDARIES. THIS SURVEY IS MADE
 FOR THE USE OF THE PRESENT OWNERS OF THE PROPERTY, AND ALSO
 THOSE WHO PURCHASE, MORTGAGE, OR GUARANTEE THE TITLE
 THERETO WITHIN ONE YEAR FROM THE DATE HEREOF.



DATED: 5/15/2008

Peter S. Gordon
 PETER S. GORDON

PROJECT: 7633
 DATE: 05/15/2008
 SHEET 1 OF 1

MPL-70

MAY 19 2008

118-2916