

PLAT OF SURVEY -OF-


LOTS 433, 434, 435, 436, 437, 438, 458 AND 459, BLOCK 9,
"PELL LAKE SUBDIVISION", ACCORDING TO THE RECORDED PLAT
THEREOF. SAID LAND BEING IN THE TOWN OF BLOOMFIELD,
WALWORTH COUNTY, WISCONSIN.

SURVEY FOR: BEAU BRADEN
SURVEY ADDRESS: N1146 WALNUT ROAD

SCALE: 1" = 30'


"I hereby certify that I have surveyed the above described property and that the above map is a correct representation thereof and shows the size and location of the property, its exterior boundaries, the location of all visible structures and dimensions of all principal buildings thereon, boundary fences, apparent easements, roadways and encroachments, if any."

"This survey is made for the use of the present owners of the property, and those who purchase, mortgage, or guarantee the title thereto within one year from date hereof."

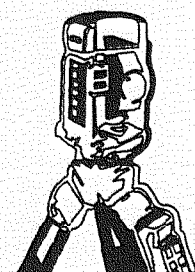


B.W. SURVEYING, INC.

LAND SURVEYS
MAPPING AND PLANNING
412 N. PINE STREET
BURLINGTON, WI 53105
(262)-767-0225

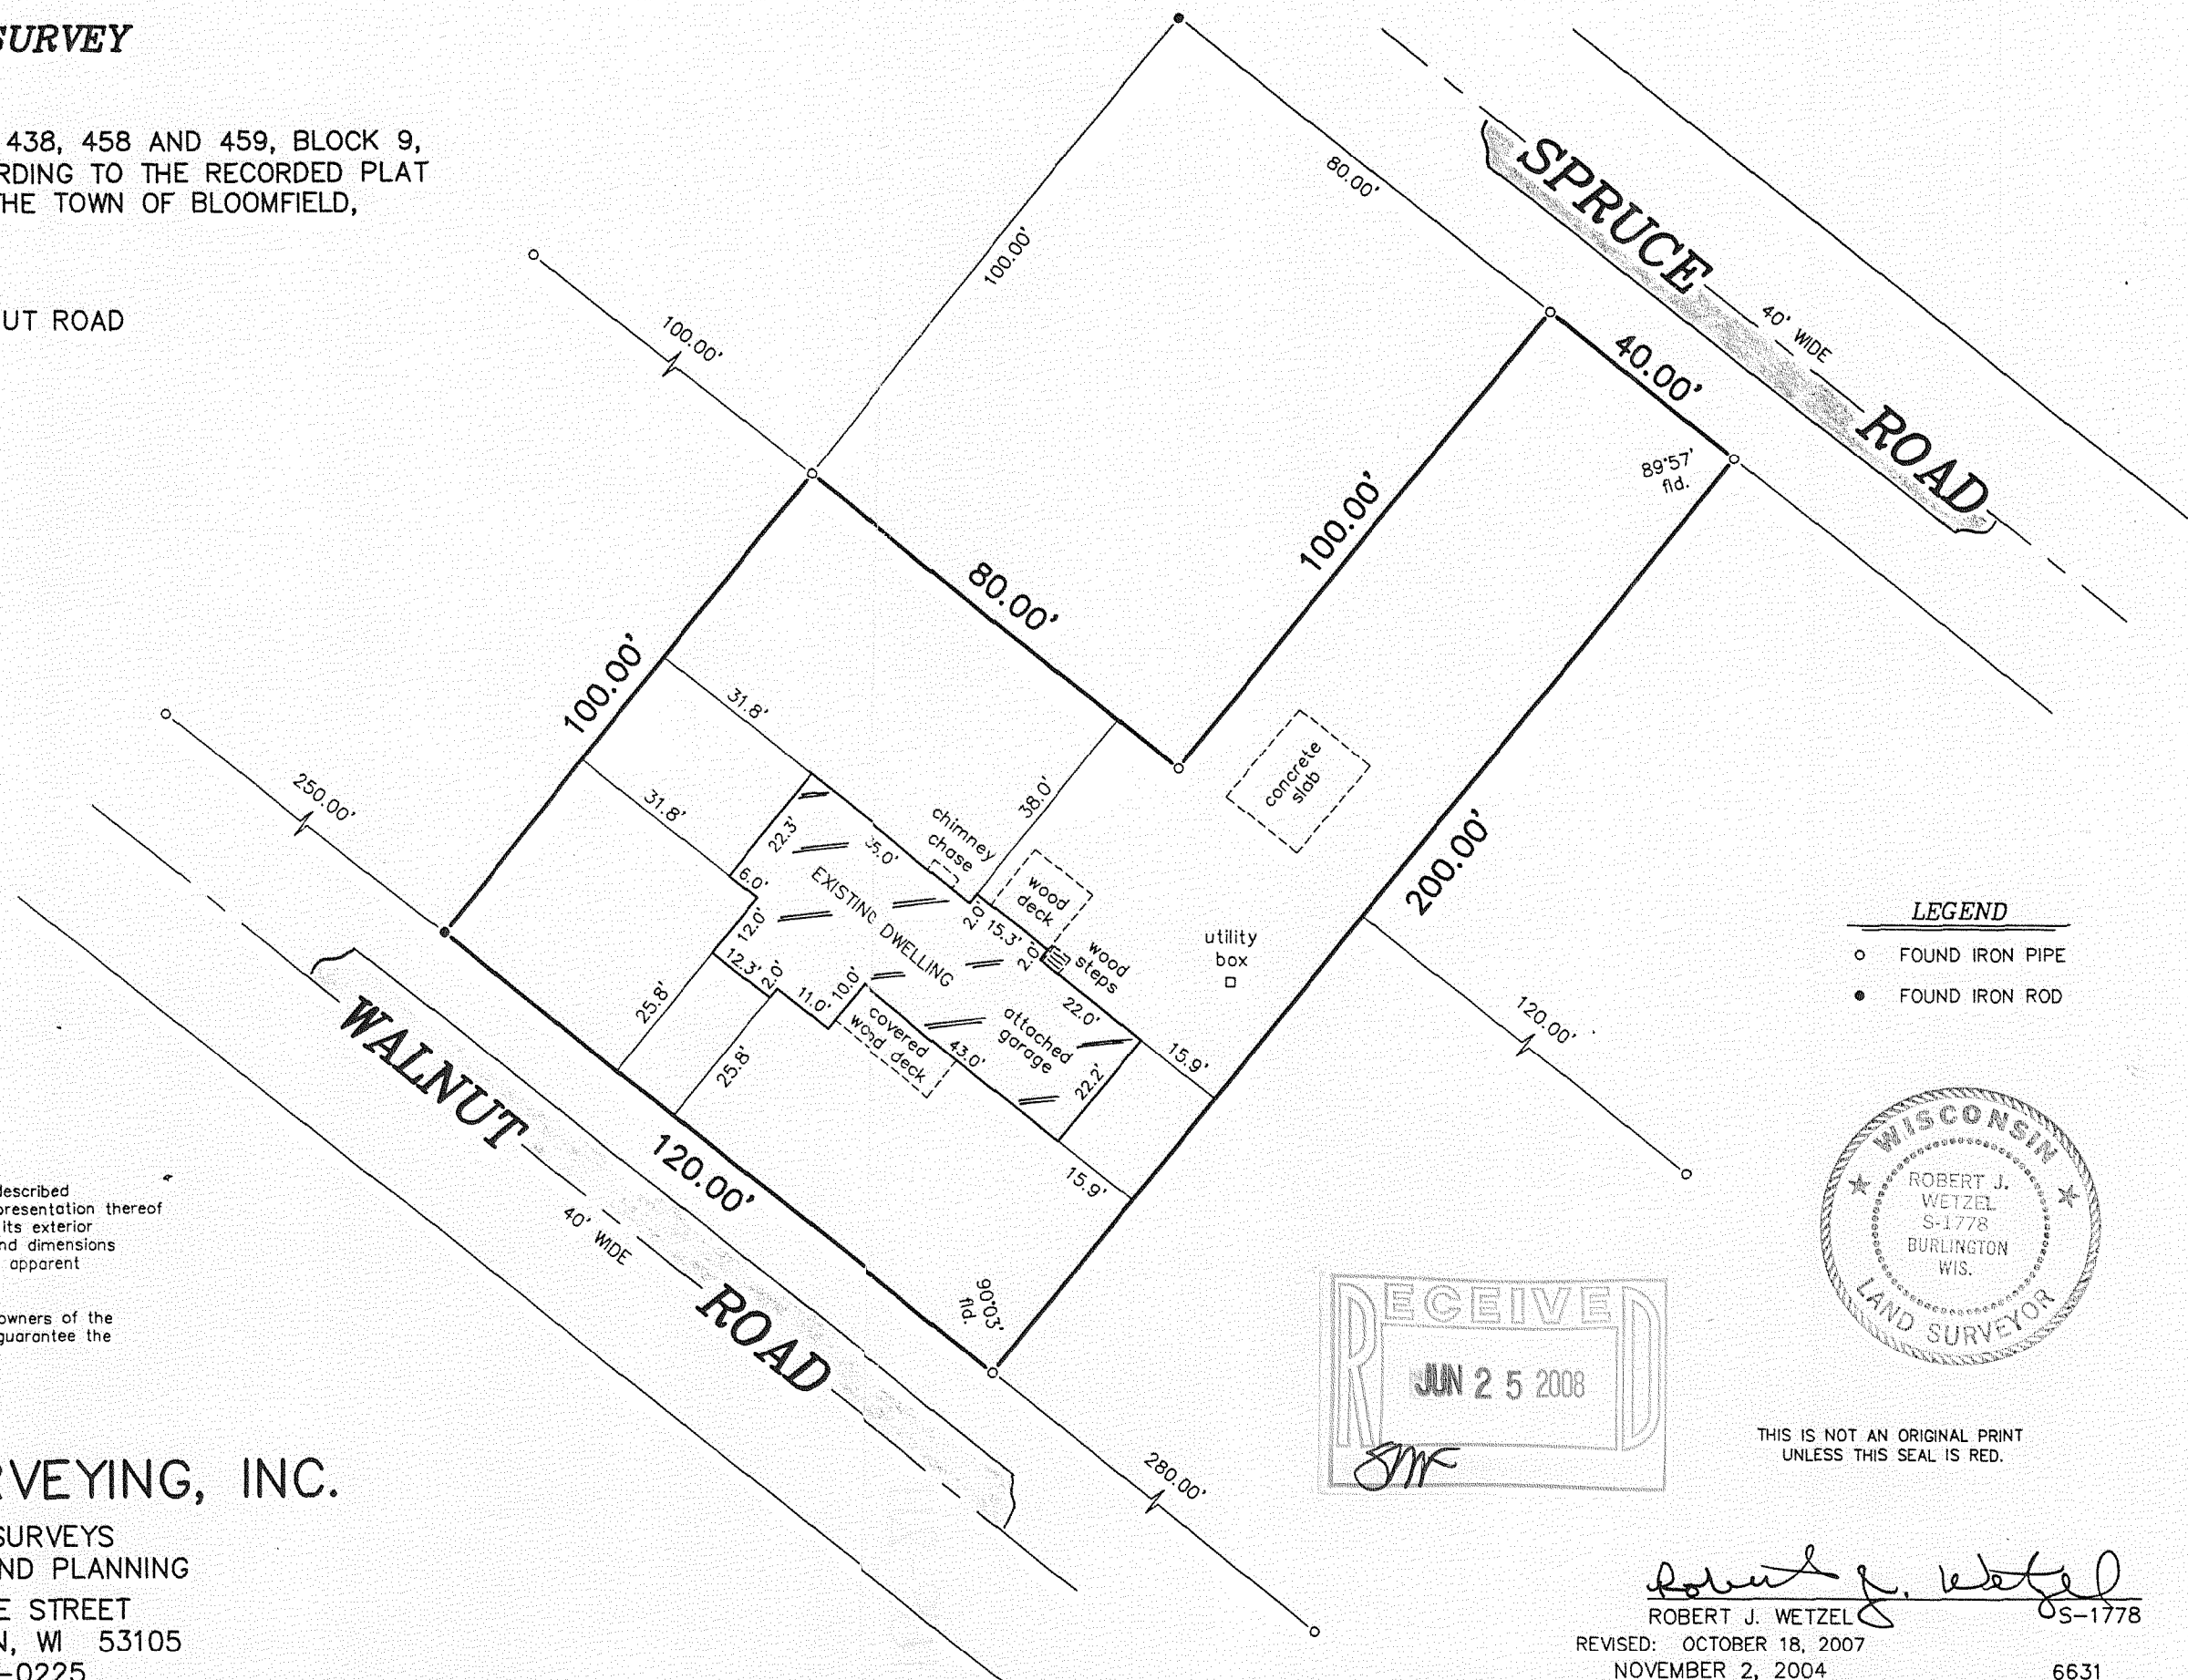

LEGEND

- FOUND IRON PIPE
- FOUND IRON ROD

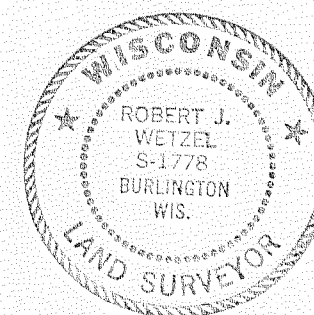

THIS IS NOT AN ORIGINAL PRINT
UNLESS THIS SEAL IS RED.

Robert J. Wetzel
ROBERT J. WETZEL S-1778

REVISED: OCTOBER 18, 2007
NOVEMBER 2, 2004
DATE

6631
JOB NUMBER

MPL-95

118-2918