

PREPARED FOR
DENNIS BORST
N 1575 ORCHID DR.
GENOA CITY WI. 53128

PLAT OF SURVEY



-OF-

LOTS 6627 THRU 6638, BLOCK 143 OF PELL LAKE SUBDIVISION, LOCATED
IN TOWN 1 NORTH, RANGE 18 EAST, WALWORTH COUNTY, WISCONSIN.

KROTT SURVEYING INC.

N3705 WILLOW BEND LANE
LAKE GENEVA WI. 53147
PHONE # (262)248-3697
FAX # (262)249-0639

ORDINARY HIGH WATER
AS FLAGED BY THE D.N.R.
AND LOCATED ON 7-22-08
ASSUMED AN ELV. OF 100.0

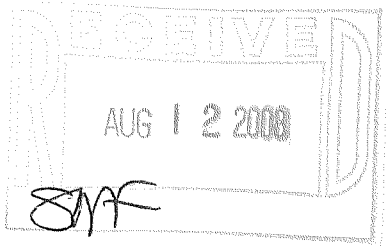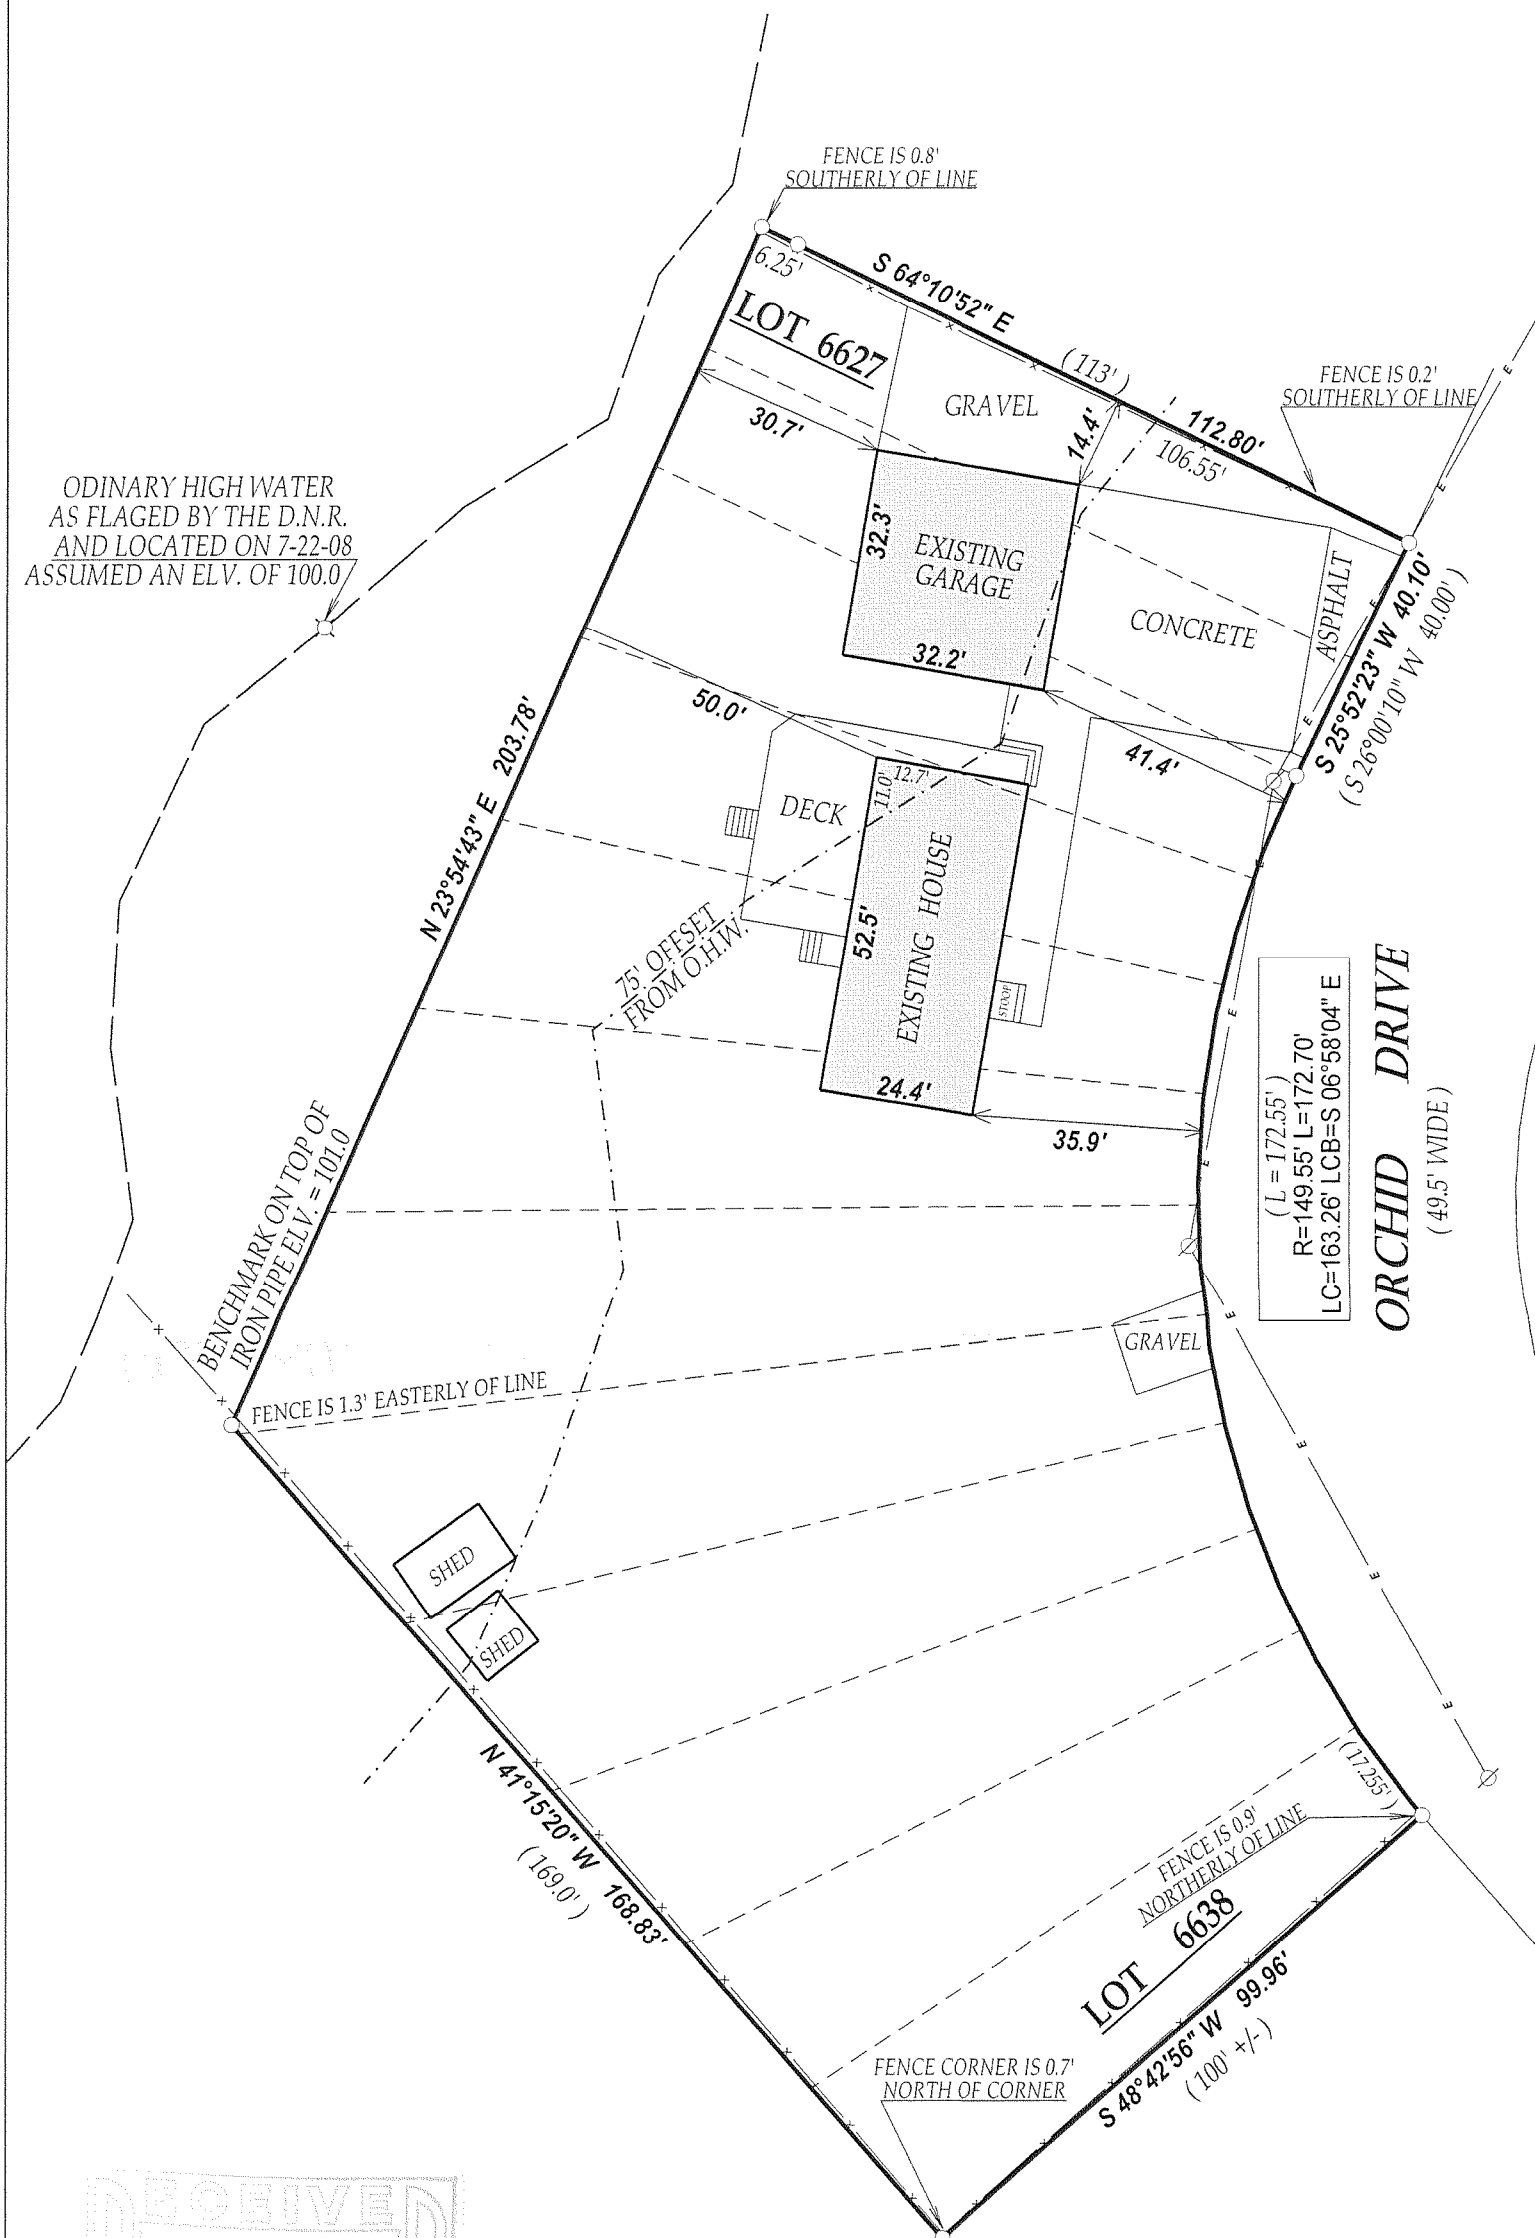

LEGEND

- FOUND IRON PIPE
- Ø POWER POLE
- E— OVERHEAD WIRES
- (XX) RECORDED AS


JOB # 08-167 TAX ID # MPL01447
DATED THIS THE 22nd DAY OF JULY 2008.



COMPARE LEGAL DESCRIPTION ABOVE AND DRAWING WITH DEED.
FOR BUILDING RESTRICTIONS AND EASEMENTS NOT SHOWN. REFER
TO DEED, ABSTRACT SOURCES AND LOCAL MUNICIPAL CODES. NOTIFY
THE SURVEYOR IMMEDIATELY OF ANY DISCREPANCY.

"I hereby certify that I have surveyed the above described property and that
the above map is a true representation thereof and shows the size and
location of all visible structures, apparent easements and encroachments
if any."

This survey is made for the present owners of the property, and those who
purchase, mortgage, or guarantee the title thereto, within one year from
the date hereof.

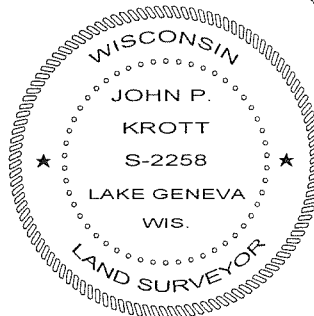

John P. Krott
JOHN KROTT S - 2258
Wisconsin Registered Land Surveyor
(original if signed in red)

118-2925