


PLAT OF SURVEY


OF
LOTS 2518, 2519, 2520, 2521, 2522, 2523, 2524 & 2525 IN SECTION 2 OF PELL
LAKE SUBDIVISION, LOCATED IN SECTION 22, T. 1 N., R. 18 E. OF THE 4TH
P.M., TOWNSHIP OF BLOOMFIELD, COUNTY OF WALWORTH, STATE OF WISCONSIN.

I HEREBY CERTIFY THAT I HAVE SURVEYED THE LAND DESCRIBED ABOVE
AND THAT THE PLAT DRAWN HEREON IS A CORRECT REPRESENTATION OF
SAID SURVEY. I FURTHER CERTIFY THAT THE BUILDINGS ON SAID LAND
ARE LOCATED AS SHOWN ON THIS PLAT.

John F. Degen 4-8-70
JOHN F. DEGEN, LAND SURVEYOR #242
589 N. PINE ST., BURLINGTON, WISCONSIN

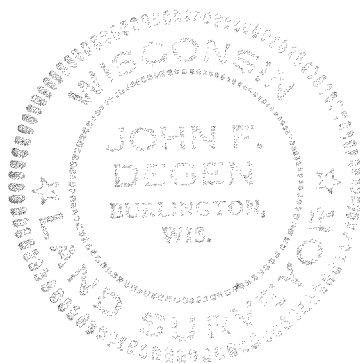

SCALE 1" EQUALS 30'
O DENOTES STAKE OF TYPE NOTED
ON PLAT.
THERE ARE NO ENCROACHMENTS OVER
LOT LINES.

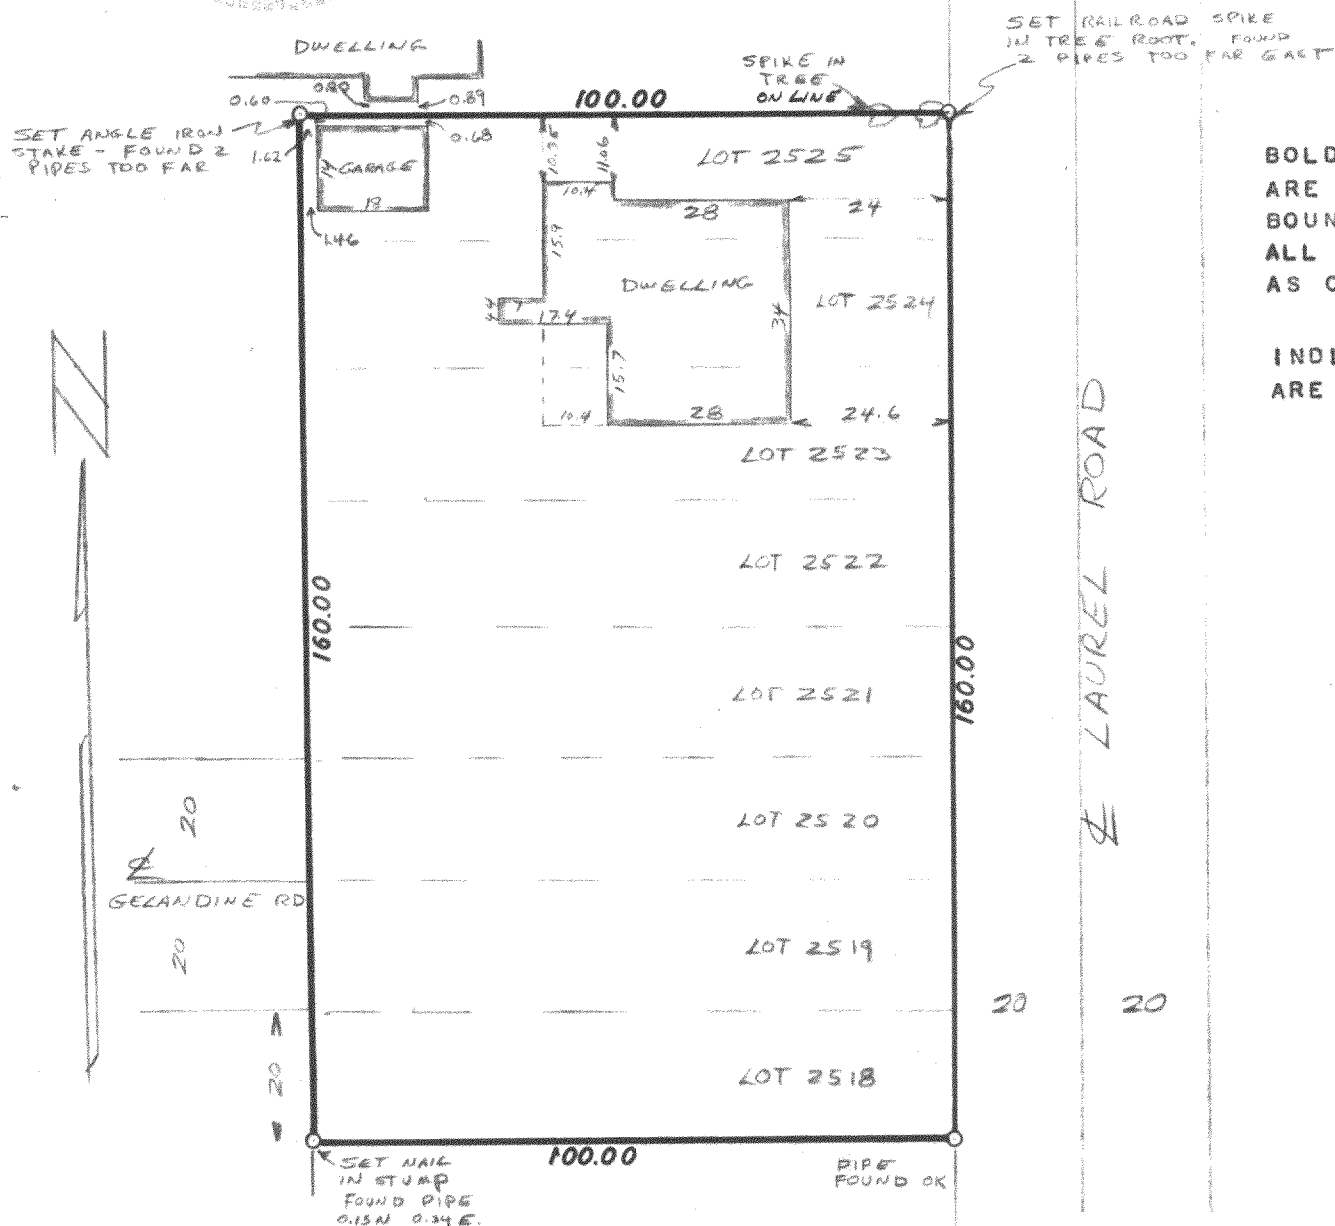

BOLD LINES
ARE OUTSIDE
BOUNDARIES OF
ALL LOTS
AS ONE PARCEL.

INDIVIDUAL LOTS
ARE 20' BY 100'

118-293

DRAWER 1-D-2

22