

HOME OFFICE
108 SOUTH SPRING STREET
BURLINGTON, WISCONSIN 53105
PHONE: 414-763-2652
414-763-7834


ROBERS & BOYD, INC.
CONSULTING ENGINEERS
LAND SURVEYORS

BRANCH OFFICE
809 - 43RD STREET
KENOSHA, WISCONSIN 53140
PHONE: 414-658-4488

PLAT OF SURVEY AND BUILDING LOCATION
For
CENTURY 21, ROBERT WOLF REALTY, INC.
Of


Lots 3809 to 3818, inclusive, as designated and delineated on the Map
entitled "Map of Section 3 of Pell Lake, Walworth County, Wisconsin"
and recorded in the office of the Register of Deeds in and for the
County of Walworth and State of Wisconsin on the 5th day of August, 1924.

JUNEAU RD. (40' WIDE)

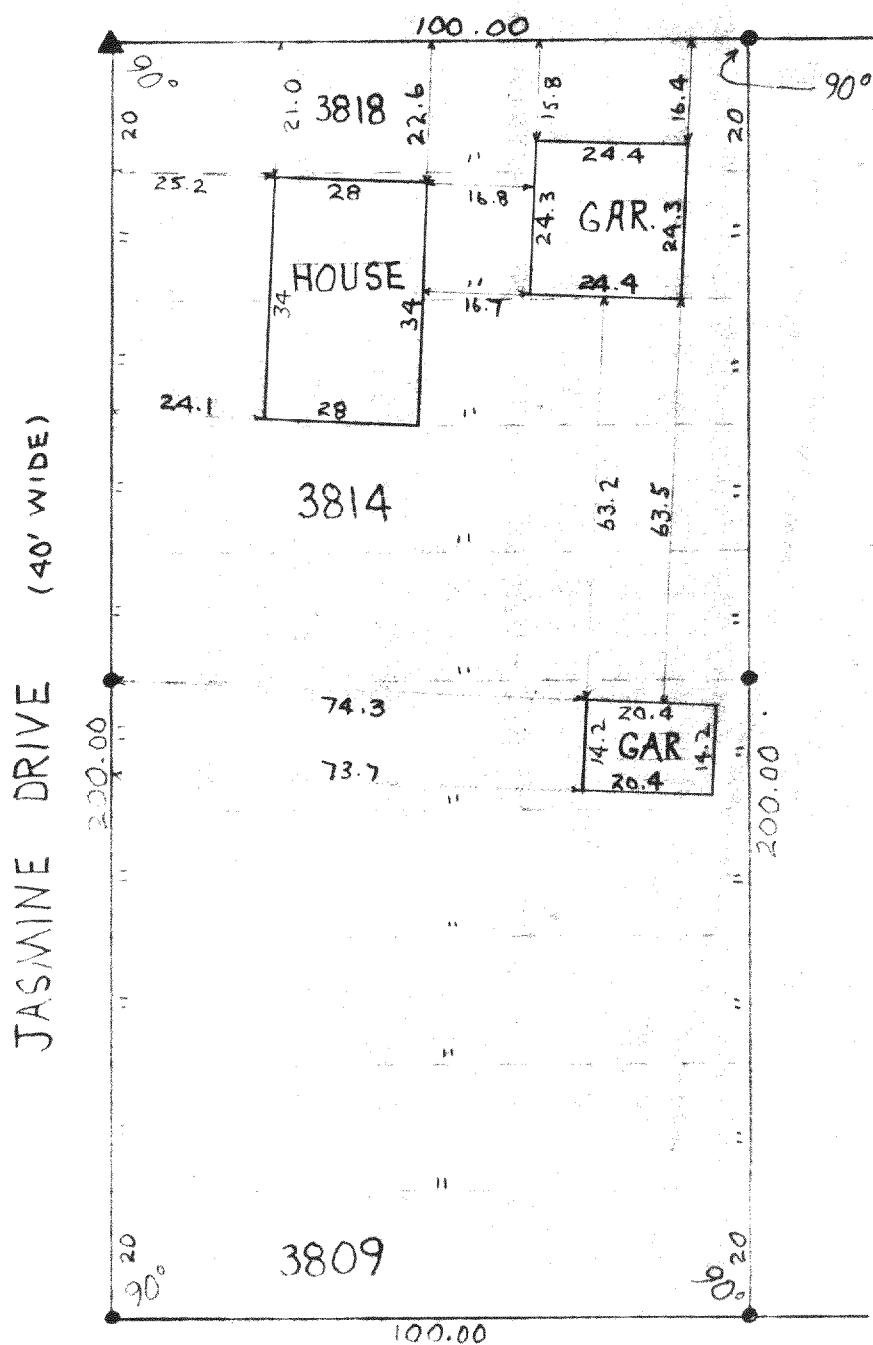

LEGEND

- FOUND IRON PIPE
 - ▲ FOUND IRON PIN
- SCALE: 1" = 30'

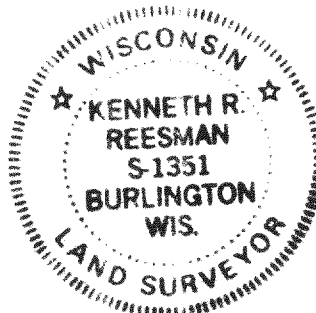

"I CERTIFY THAT I HAVE SURVEYED THE ABOVE DESCRIBED
PROPERTY AND THAT THE ABOVE PLAT IS AN ACCURATE
SURVEY AND A TRUE REPRESENTATION THEREOF AND COR-
RECTLY SHOWS THE EXTERIOR BOUNDARY LINES AND LOCA-
TION OF BUILDINGS ON SAID PROPERTY AND THE CORRECT
MEASUREMENTS THEREOF."

Kenneth R. Reesman
WISCONSIN REGISTERED LAND SURVEYOR

7/27/78
DATE

78180
JOB NUMBER