

LAND-MARK SURVEYING

Mark L. Miritz



Wisconsin Registered Land Surveyor S-2582

N9330 Knuteson Drive
Whitewater, WI 53190
Phone: (262) 495-3284
FAX: (262) 495-8421
LAND-MARKSURVEYING.COM

PLAT OF SURVEY

LOT 6 OF BLOOMFIELD BUSINESS PARK
PHASE 1 AS RECORDED IN CAB C SLIDE
4, WALWORTH COUNTY RECORDS, LOCATED
IN THE SOUTHWEST 1/4 OF THE NORTHEAST
1/4 OF SECTION 7, TOWN 1 NORTH, RANGE
18 EAST, WALWORTH COUNTY, WISCONSIN.

OWNER: SCHAUDER BUILDING, INC.
4115 HWY 51 NORTH
JANESVILLE, WI. 53545

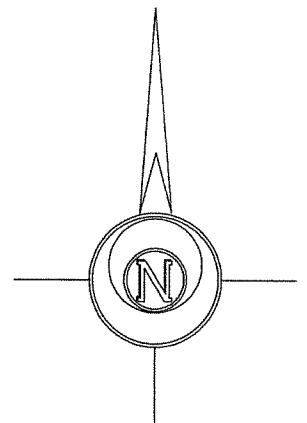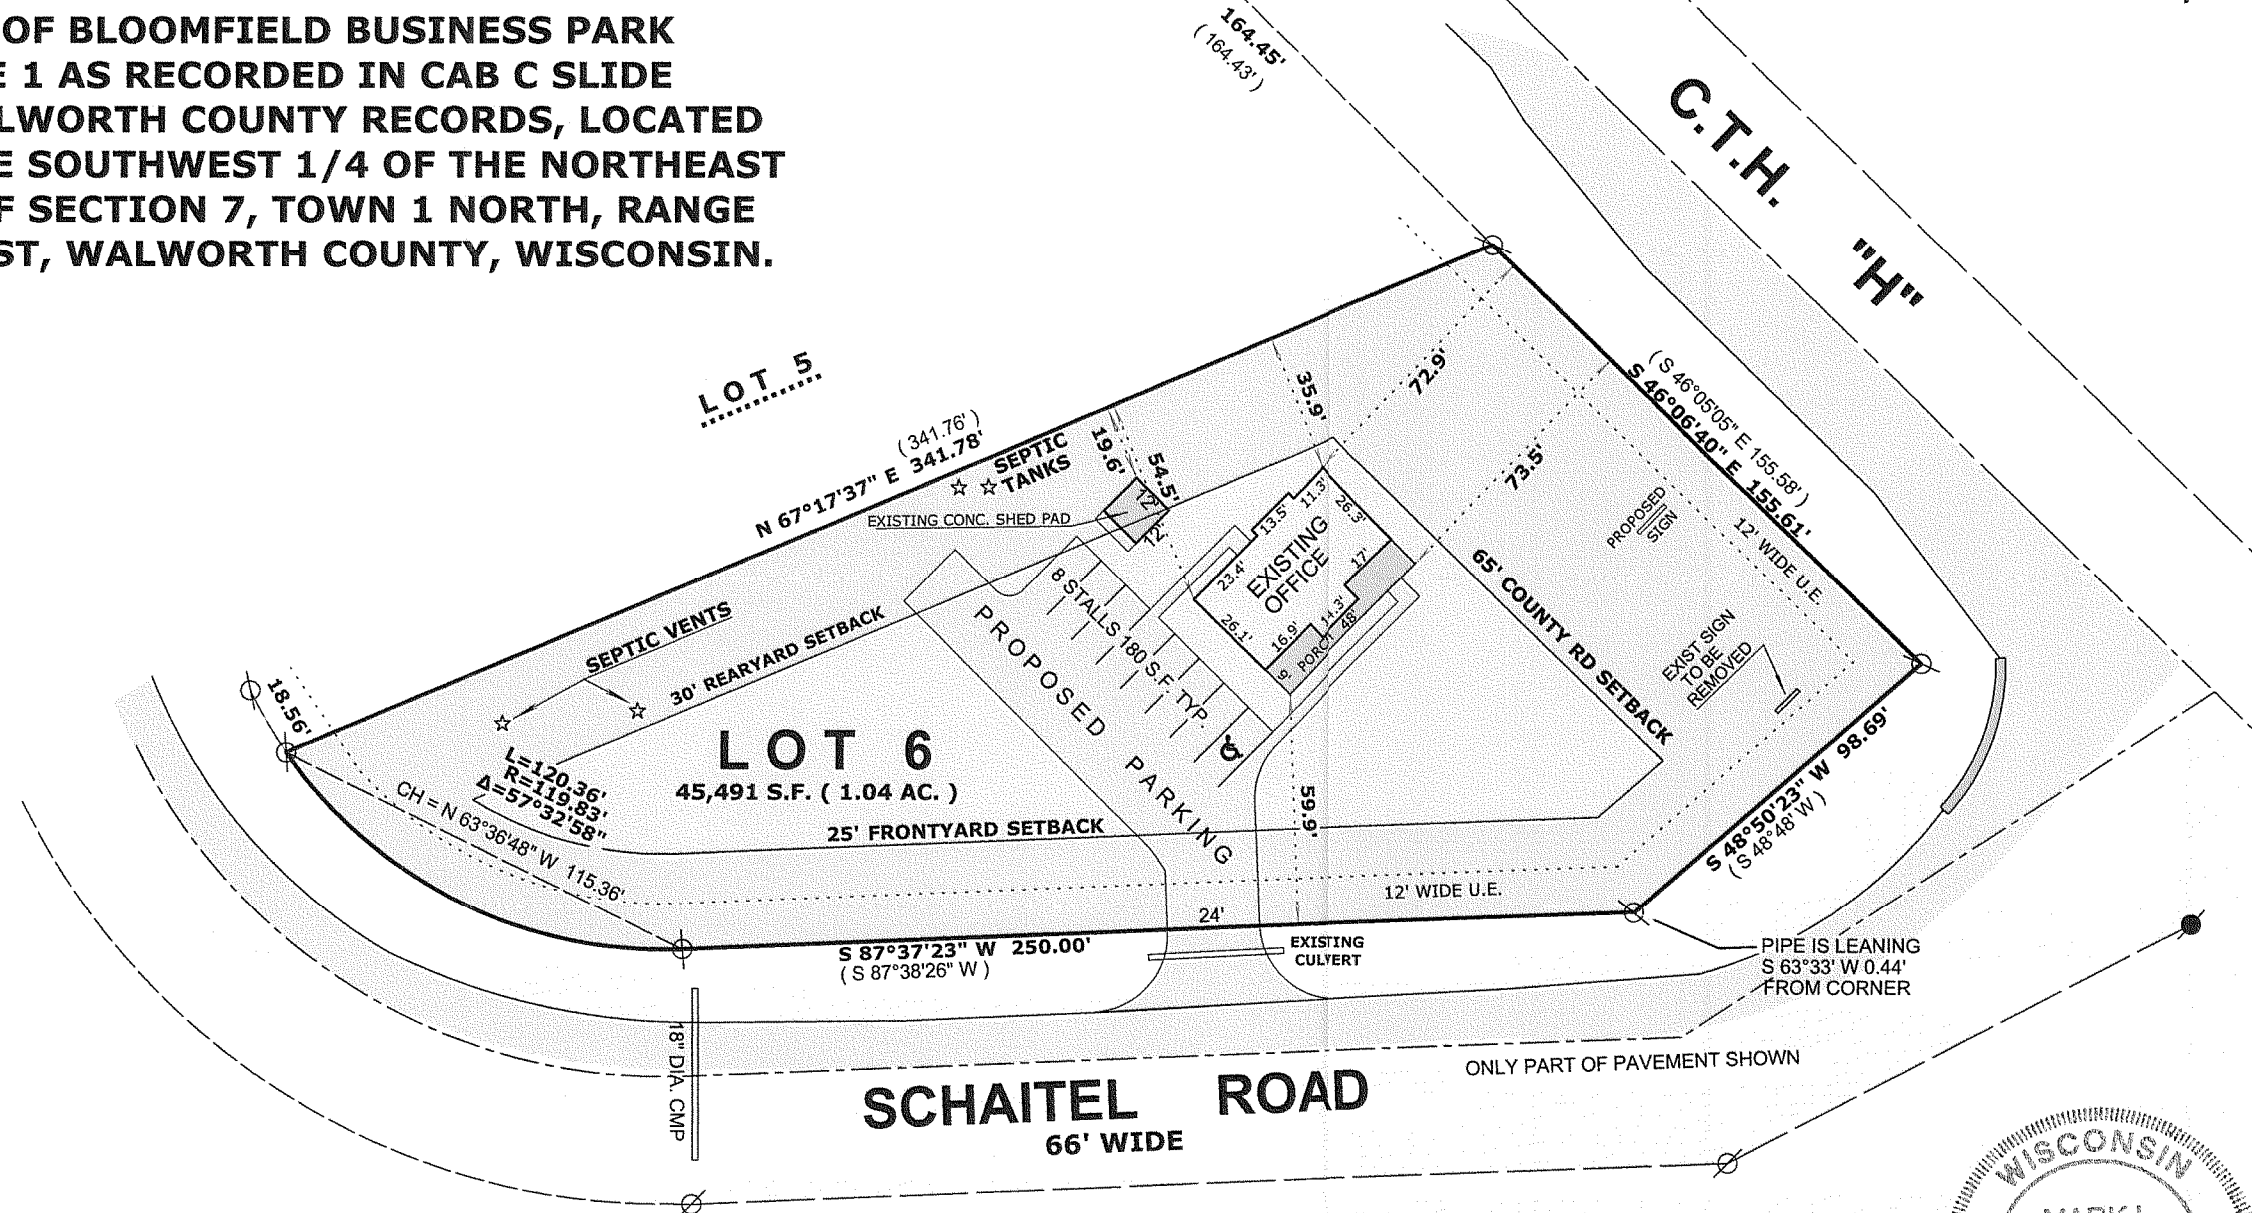


LEGEND

- FOUND IRON PIPE
- FOUND IRON ROD
- FOUND COUNTY MONUMENT
- FOUND CONCRETE MONUMENT
- CHISEL CUT IN CONCRETE
- SET IRON ROD, 24" LONG, WEIGHING 1.5 LBS./LINEAL FT., 3/4" DIA.
- RECORDED AS DIMENSION
- EXISTING FENCE

SCALE: 1" = 50 FEET


"I hereby certify that the above described property has been surveyed by me or under my direction and that the above map is a true representation thereof and shows the size and location of the property, its exterior boundaries, the location of all visible structures and dimensions of all principal buildings thereon, boundary fences, apparent easements, roadways and visible encroachments, if any."
"This survey is made for the use of the present owners of the property, and also those who purchase, mortgage, or guarantee the title thereto within one year from date hereof."

Mark L. Miritz
MARK L. MIRITZ
WISCONSIN REGISTERED
LAND SURVEYOR S-2582

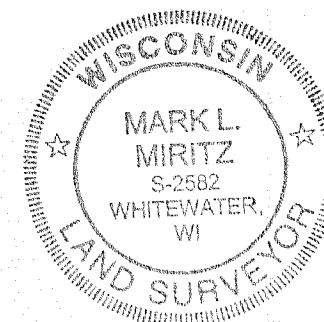

REVISED AUGUST 27, 2008 TO BUILDING "AS BUILT"

DATE: OCT. 24, 2007 JOB NO. 07.1002

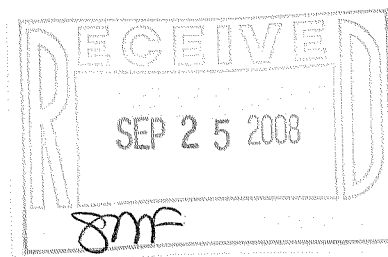

MBP-L6

118-2941