

**LAND-MARK SURVEYING**  
Mark L. Miritz  
Wisconsin Registered Land Surveyor S-2582


N9330 Knuteson Drive  
Whitewater, WI 53190  
Phone: (262) 495-3284  
FAX: (262) 495-8421  
LAND-MARKSURVEYING.COM

## PLAT OF SURVEY

LOTS 861 THROUGH 867, INCLUSIVE, BLOCK 12, PELL LAKE HIGHLANDS  
LOCATED IN SECTION 16, TOWN 1 NORTH, RANGE 18 EAST, BLOOMFIELD  
TOWNSHIP, WALWORTH COUNTY, WISCONSIN.

OWNER: JEFFREY LABONTE  
W1393 OAKWOOD ROAD  
PELL LAKE, WI 53157

THE NORTH LINE OF LOTS 861-867  
WAS ASSUMED EAST

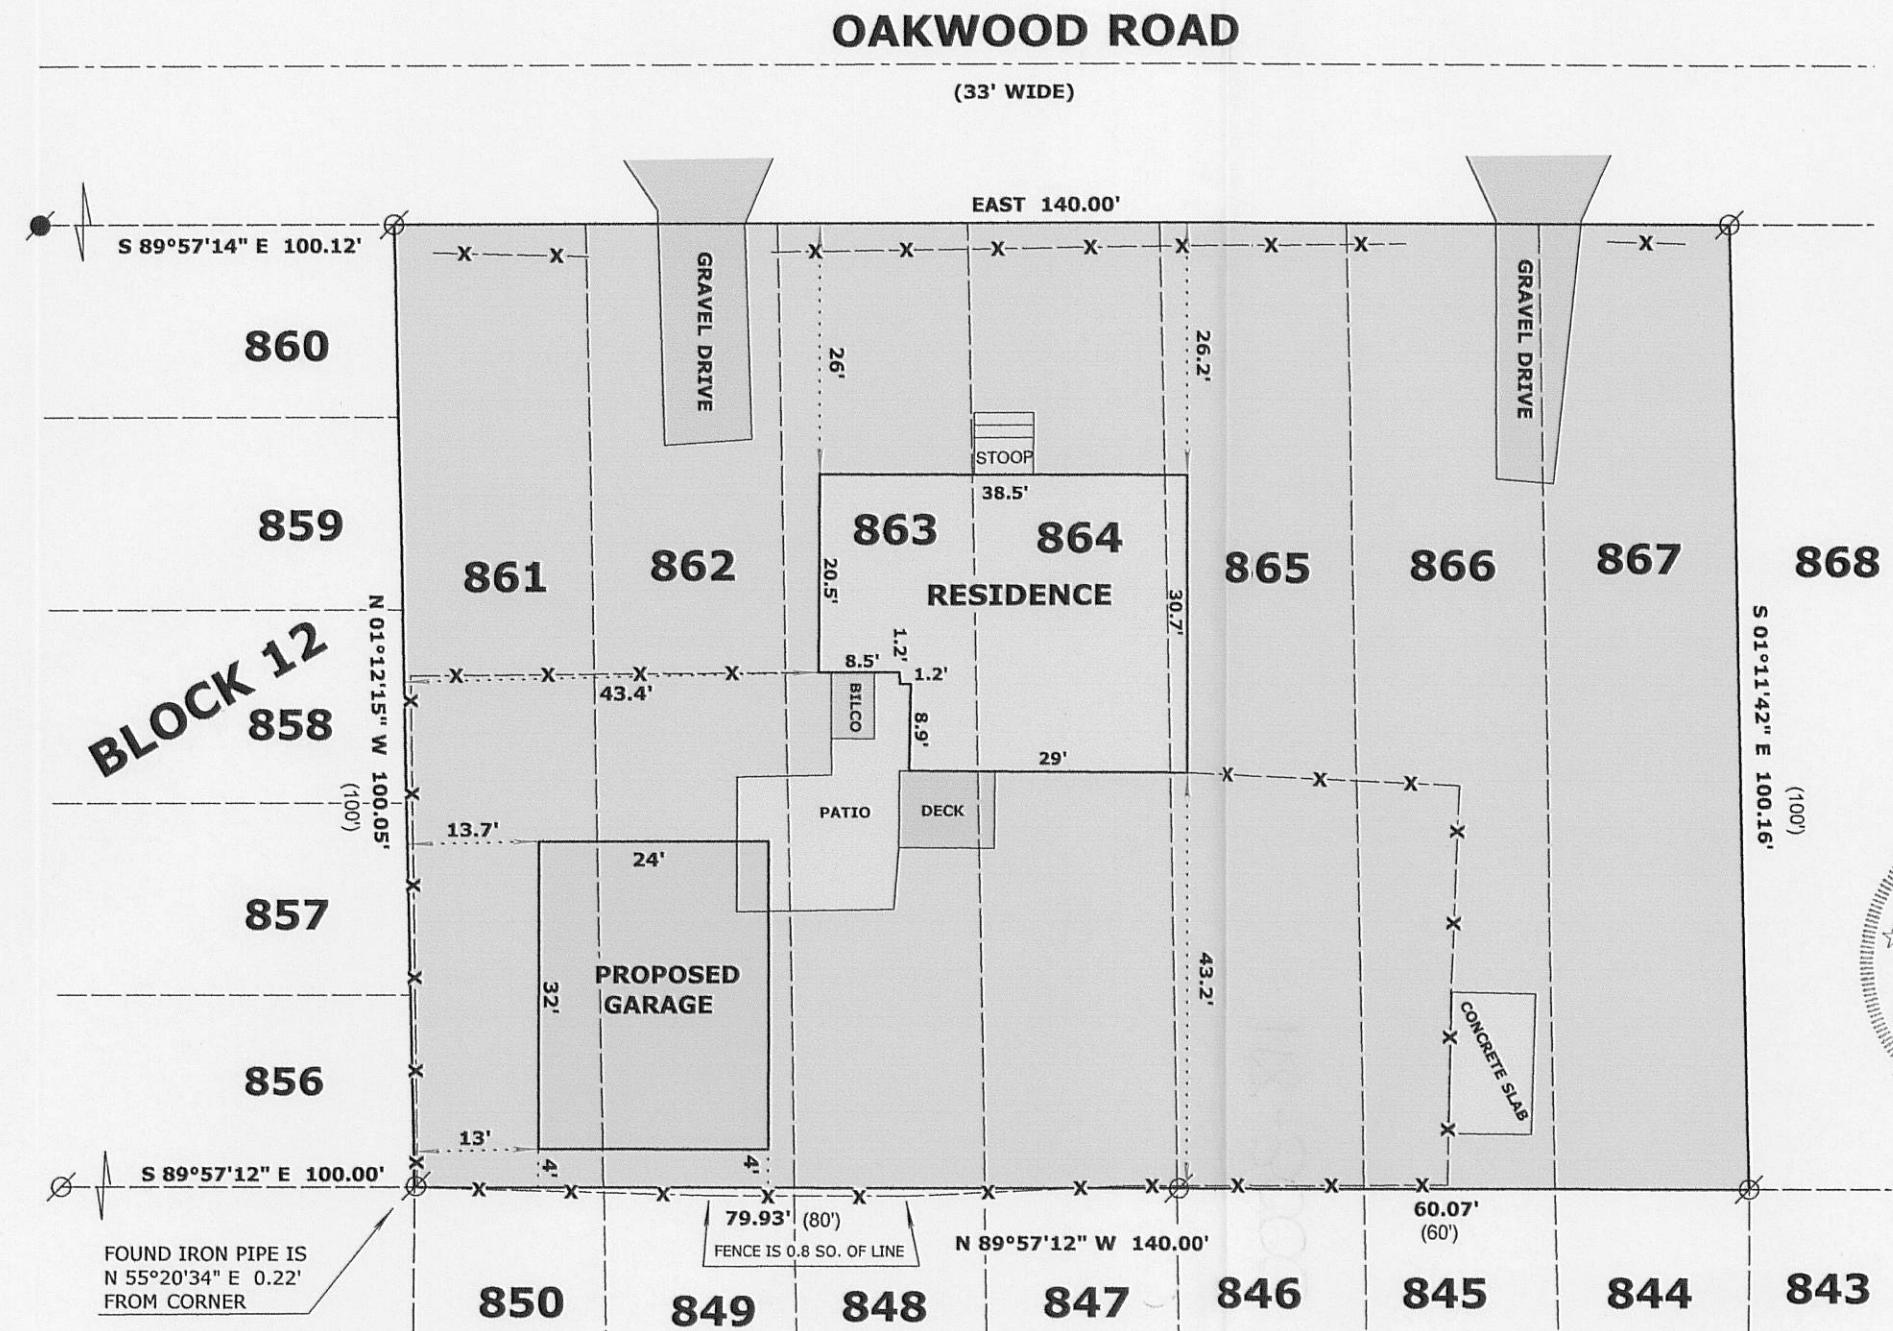

RECEIVED  
FEB 10 2010  
By *SMK*

### LEGEND

- FOUND IRON PIPE
- FOUND IRON ROD
- (xx) RECORDED AS DIMENSION
- EXISTING FENCE

SCALE: 1 INCH = 20 FEET

"I hereby certify that the above described property has been surveyed by me or under my direction and that the above map is a true representation thereof and shows the size and location of the property, its exterior boundaries, the location of all visible structures and dimensions of all principal buildings thereon, boundary fences, apparent easements, roadways and visible encroachments, if any."  
"This survey is made for the use of the present owners of the property, and also those who purchase, mortgage, or guarantee the title thereto within one year from date hereof."



*Mark L. Miritz*  
MARK L. MIRITZ  
WISCONSIN REGISTERED  
LAND SURVEYOR S-2582

DATE: NOV. 5, 2009 JOB NO. 09.1101

MPLH-183

118-3000