

PREPARED FOR:
BRIAN CLISH

ASBUILT SURVEY



-OF-

PATHFINDER SURVEYING, INC.
W2888 KRUEGER ROAD UNIT "D"
LAKE GENEVA, WI 53147
(262) 248-8303

LOTS 1632 THROUGH 1637, IN BLOCK 36 OF PELL LAKE SUBDIVISION
PLAT MAP #4, TOWN OF BLOOMFIELD, WALWORTH COUNTY, WISCONSIN

POST ROAD
(50' WIDE)

LAKE SHORE DRIVE
(50' WIDE)

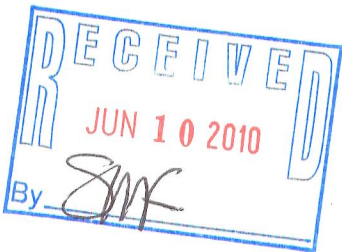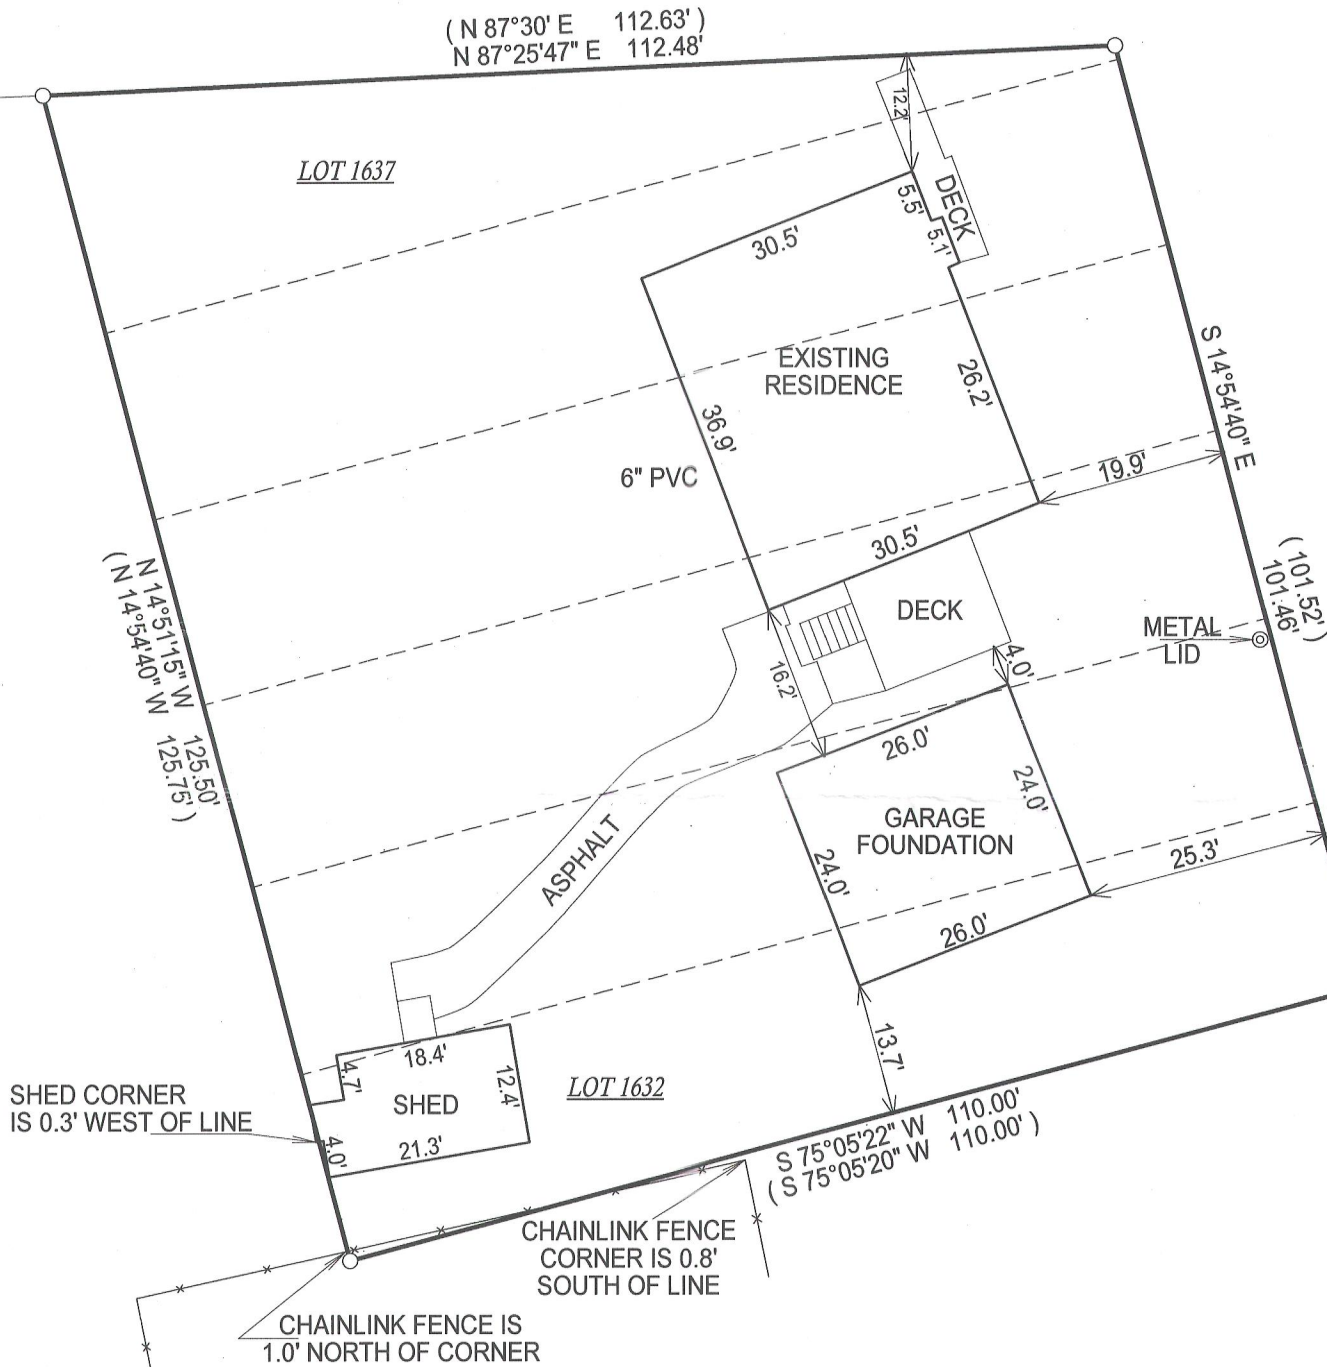

- () = RECORDED AS
□ = FOUND IRON BAR
○ = FOUND IRON PIPE
■ = SET IRON BAR
● = SET IRON PIPE

SCALE: 1" = 20'

JOB #: 09-020AB

TAXID #: MPL 00357

NOTE: BASIS OF BEARING IS RECORD
PLAT OF PELL LAKE SUBDIVISION MAP #4

COMPARE LEGAL DESCRIPTION ABOVE AND DRAWING WITH DEED. FOR BUILDING RESTRICTIONS AND
EASEMENTS NOT SHOWN, REFER TO DEED, ABSTRACT SOURCES AND LOCAL MUNICIPAL CODES. NOTIFY
THE SURVEYOR IMMEDIATELY OF ANY DISCREPANCY.

"I hereby certify that the above described property was surveyed under my
supervision and that the above map, to the best of my knowledge and
belief, is a true representation thereof and shows the size and location of all
visible structures, apparent easements and encroachments if any."
This survey is made for the present owners of the property, and those who
purchase, mortgage, or guarantee the title thereto, within one year from
the date hereof.

JEFFREY L. KIMPS S - 2436
Wisconsin Registered Land Surveyor
(original if signed in red)

REVISED 6/10/2009, ASBUILT GARAGE
REVISED 5-4-2009, CHANGED GARAGE DIMENSION
DATED THE 27th, DAY OF APRIL, 2009.

118-3021