

DEGEN - FOAT SURVEYING, INC.

100 SOUTH SECOND STREET
WATERFORD, WISCONSIN 53185
(262)534-5404 (FAX)534-2022

093121
093121S1.DWG


PLAT OF SURVEY

LOTS 3226 THROUGH 3232, IN BLOCK 47 OF SECTION 2 OF PELL LAKE SUBDIVISION, LOCATED IN THE TOWN OF BLOOMFIELD, WALWORTH COUNTY, WISCONSIN.

* REFER TO A CURRENT TITLE REPORT FOR EASEMENTS, RESTRICTIONS OR COVENANTS OF RECORD THAT MAY AFFECT THIS LAND. *

SURVEY ORDERED BY: SANDY COWAN
BEAR REALTY
565 MILWAUKEE AVE.
BURLINGTON, WI 53105

LOREN & CRYSTAL SCOTT PROPERTY

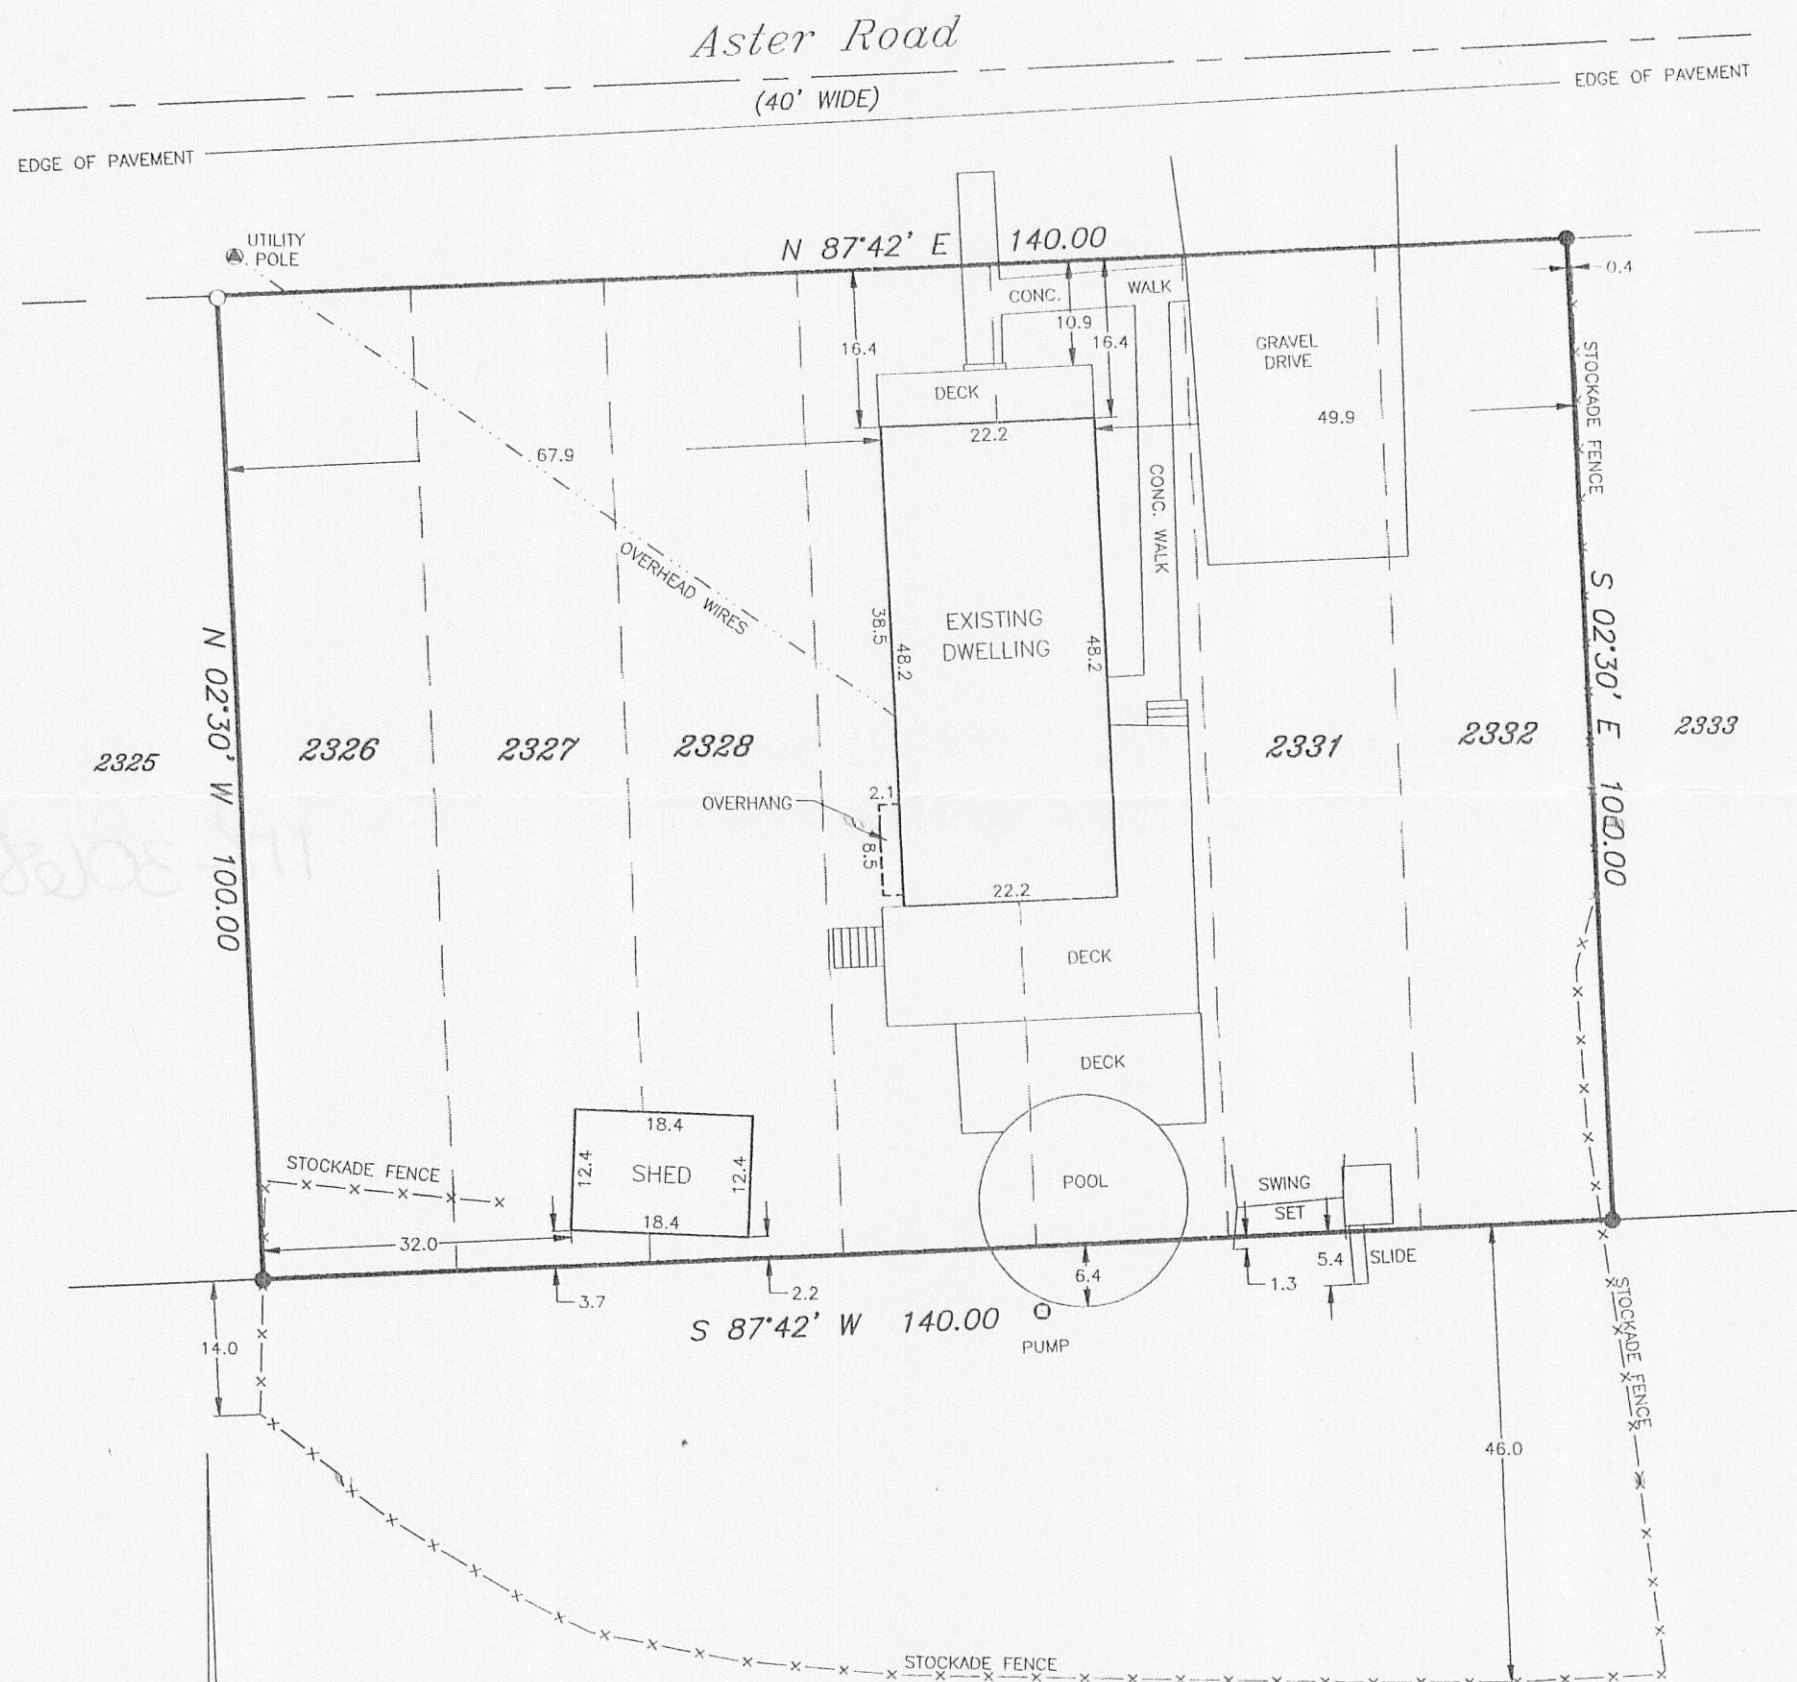


LEGEND

- - FOUND IRON PIPE
- - FOUND SOLID IRON BAR
- FENCE
- () - RECORDED AS

SCALE: 1" = 20'

BEARING BASE: AS RECORDED AS.

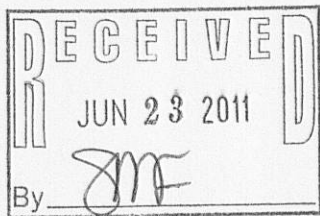


I HEREBY CERTIFY THAT I HAVE SURVEYED THE ABOVE DESCRIBED PROPERTY AND THE ABOVE MAP IS A TRUE REPRESENTATION THEREOF AND SHOWS THE SIZE AND LOCATION OF THE PROPERTY, THE LOCATION OF ALL VISIBLE STRUCTURES AND DIMENSIONS OF ALL PRINCIPAL BUILDINGS THEREON, BOUNDARY FENCES, APPARENT EASEMENTS, ROADWAY AND VISIBLE ENCROACHMENTS, IF ANY.

THIS SURVEY IS MADE FOR THE PRESENT OWNERS OF THE PROPERTY, AND ALSO THOSE WHO PURCHASE, OR GUARANTEE THE TITLE THERETO WITHIN (1) YEAR FROM THE DATE HEREOF.

DATED AT WATERFORD, WI THIS 26TH DAY OF OCTOBER 20, 09

RECERTIFIED

Gary B. Foat

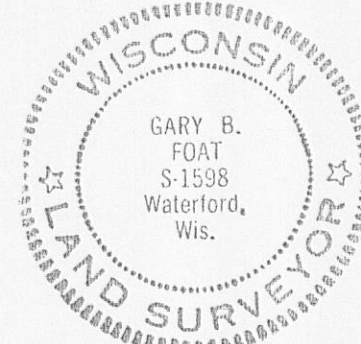

MPL-679

118-3008