

PREPARED FOR
CARLOS MIRAMONTES
W1281 CONDOR RD.
GENOA CITY WI. 53128



PLAT OF SURVEY

-OF-


KROTT SURVEYING INC.

N3705 WILLOW BEND LANE
LAKE GENEVA WI. 53147
PHONE # (262)248-3697
FAX # (262)249-0639

LOTS 8237 THRU 8241, BLOCK 172, DESIGNATED AND DELINEATED ON THE
MAP ENTITLED MAP OF SECTION 5 OF PELL LAKE, TOWN OF BLOOMFIELD,
WALWORTH COUNTY, WISCONSIN.

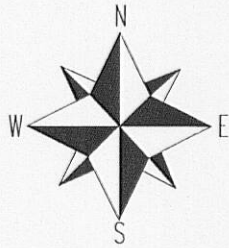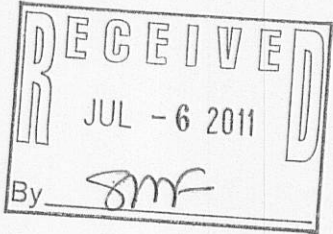

SCALE 1" = 30'

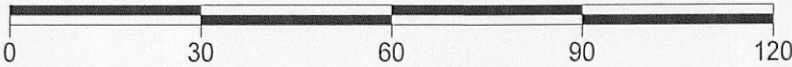

- LEGEND
- FOUND IRON PIPE
 - FOUND IRON BAR
 - SET IRON BAR

I have surveyed the above-described property and the above map is a true representation thereof and shows the size and location of the property, its exterior boundaries, the location and dimensions of all structures thereon, fences apparent easements and roadways and visible encroachments, if any.

This survey is made for the exclusive use of the present owners of the property, and also those who purchase, mortgage, or insure the title thereto within one (1) year from date hereof; and as to them I warrant the accuracy of said survey map.

NOTE: BEARINGS ARE REFERENCED TO THE RECORD PLAT.



DATED THIS 12th DAY OF MAY 2011.

John P. Krott
JOHN KROTT S - 2258
Wisconsin Registered Land Surveyor
(original if signed in red)

(XX) RECORDED AS
TAX ID # MPL01648
JOB # 11-064

118-3071