

LAND-MARK SURVEYING

Mark L. Miritz

Wisconsin Registered Land Surveyor S-2582

N9330 Knuteson Drive
Whitewater, WI 53190
Phone: (262) 495-3284
FAX : (262) 495-8421
LAND-MARKSURVEYING.COM

PLAT OF SURVEY


LEGAL DESCRIPTION AS FOUND VOL. 632, PAGE 6462 & 6463,
DOCUMENT NO. 295936, WALWORTH COUNTY, RECORDS

PARCEL 1: LOTS 2502 AND 2503 AS DESIGNATED AND DELINEATED ON THE
MAP ENTITLED "MAP OF SECTION "TWO" OF PELL LAKE, WALWORTH COUNTY,
WISCONSIN, AND RECORDED IN THE OFFICE OF THE REGISTER OF DEEDS IN
AND FOR THE COUNTY OF WALWORTH AND STATE OF WISCONSIN ON THE 16TH
DAY OF JULY, 1924.

PARCEL 2: LOTS 2504, 2505, 2506, 2507, 2508, 2509, 2510 AND 2511 AS
AS DESIGNATED AND DELINEATED ON THE MAP ENTITLED "MAP OF SECTION
'TWO' OF PELL LAKE, WALWORTH COUNTY, WISCONSIN' AND RECORDED IN
THE OFFICE OF THE REGISTER OF DEEDS IN AND FOR THE COUNTY OF
WALWORTH AND STATE OF WISCONSIN ON THE 16TH DAY OF JULY, 1924


PARCEL 3: LOTS 7816, 7817, AND 7818, LOT 7819 AND 7820, PELL LAKE

ORDERED BY: STACEY SCHULTZ
KEEFE REAL ESTATE
751 GENEVA PARKWAY
LAKE GENEVA, WI 53147

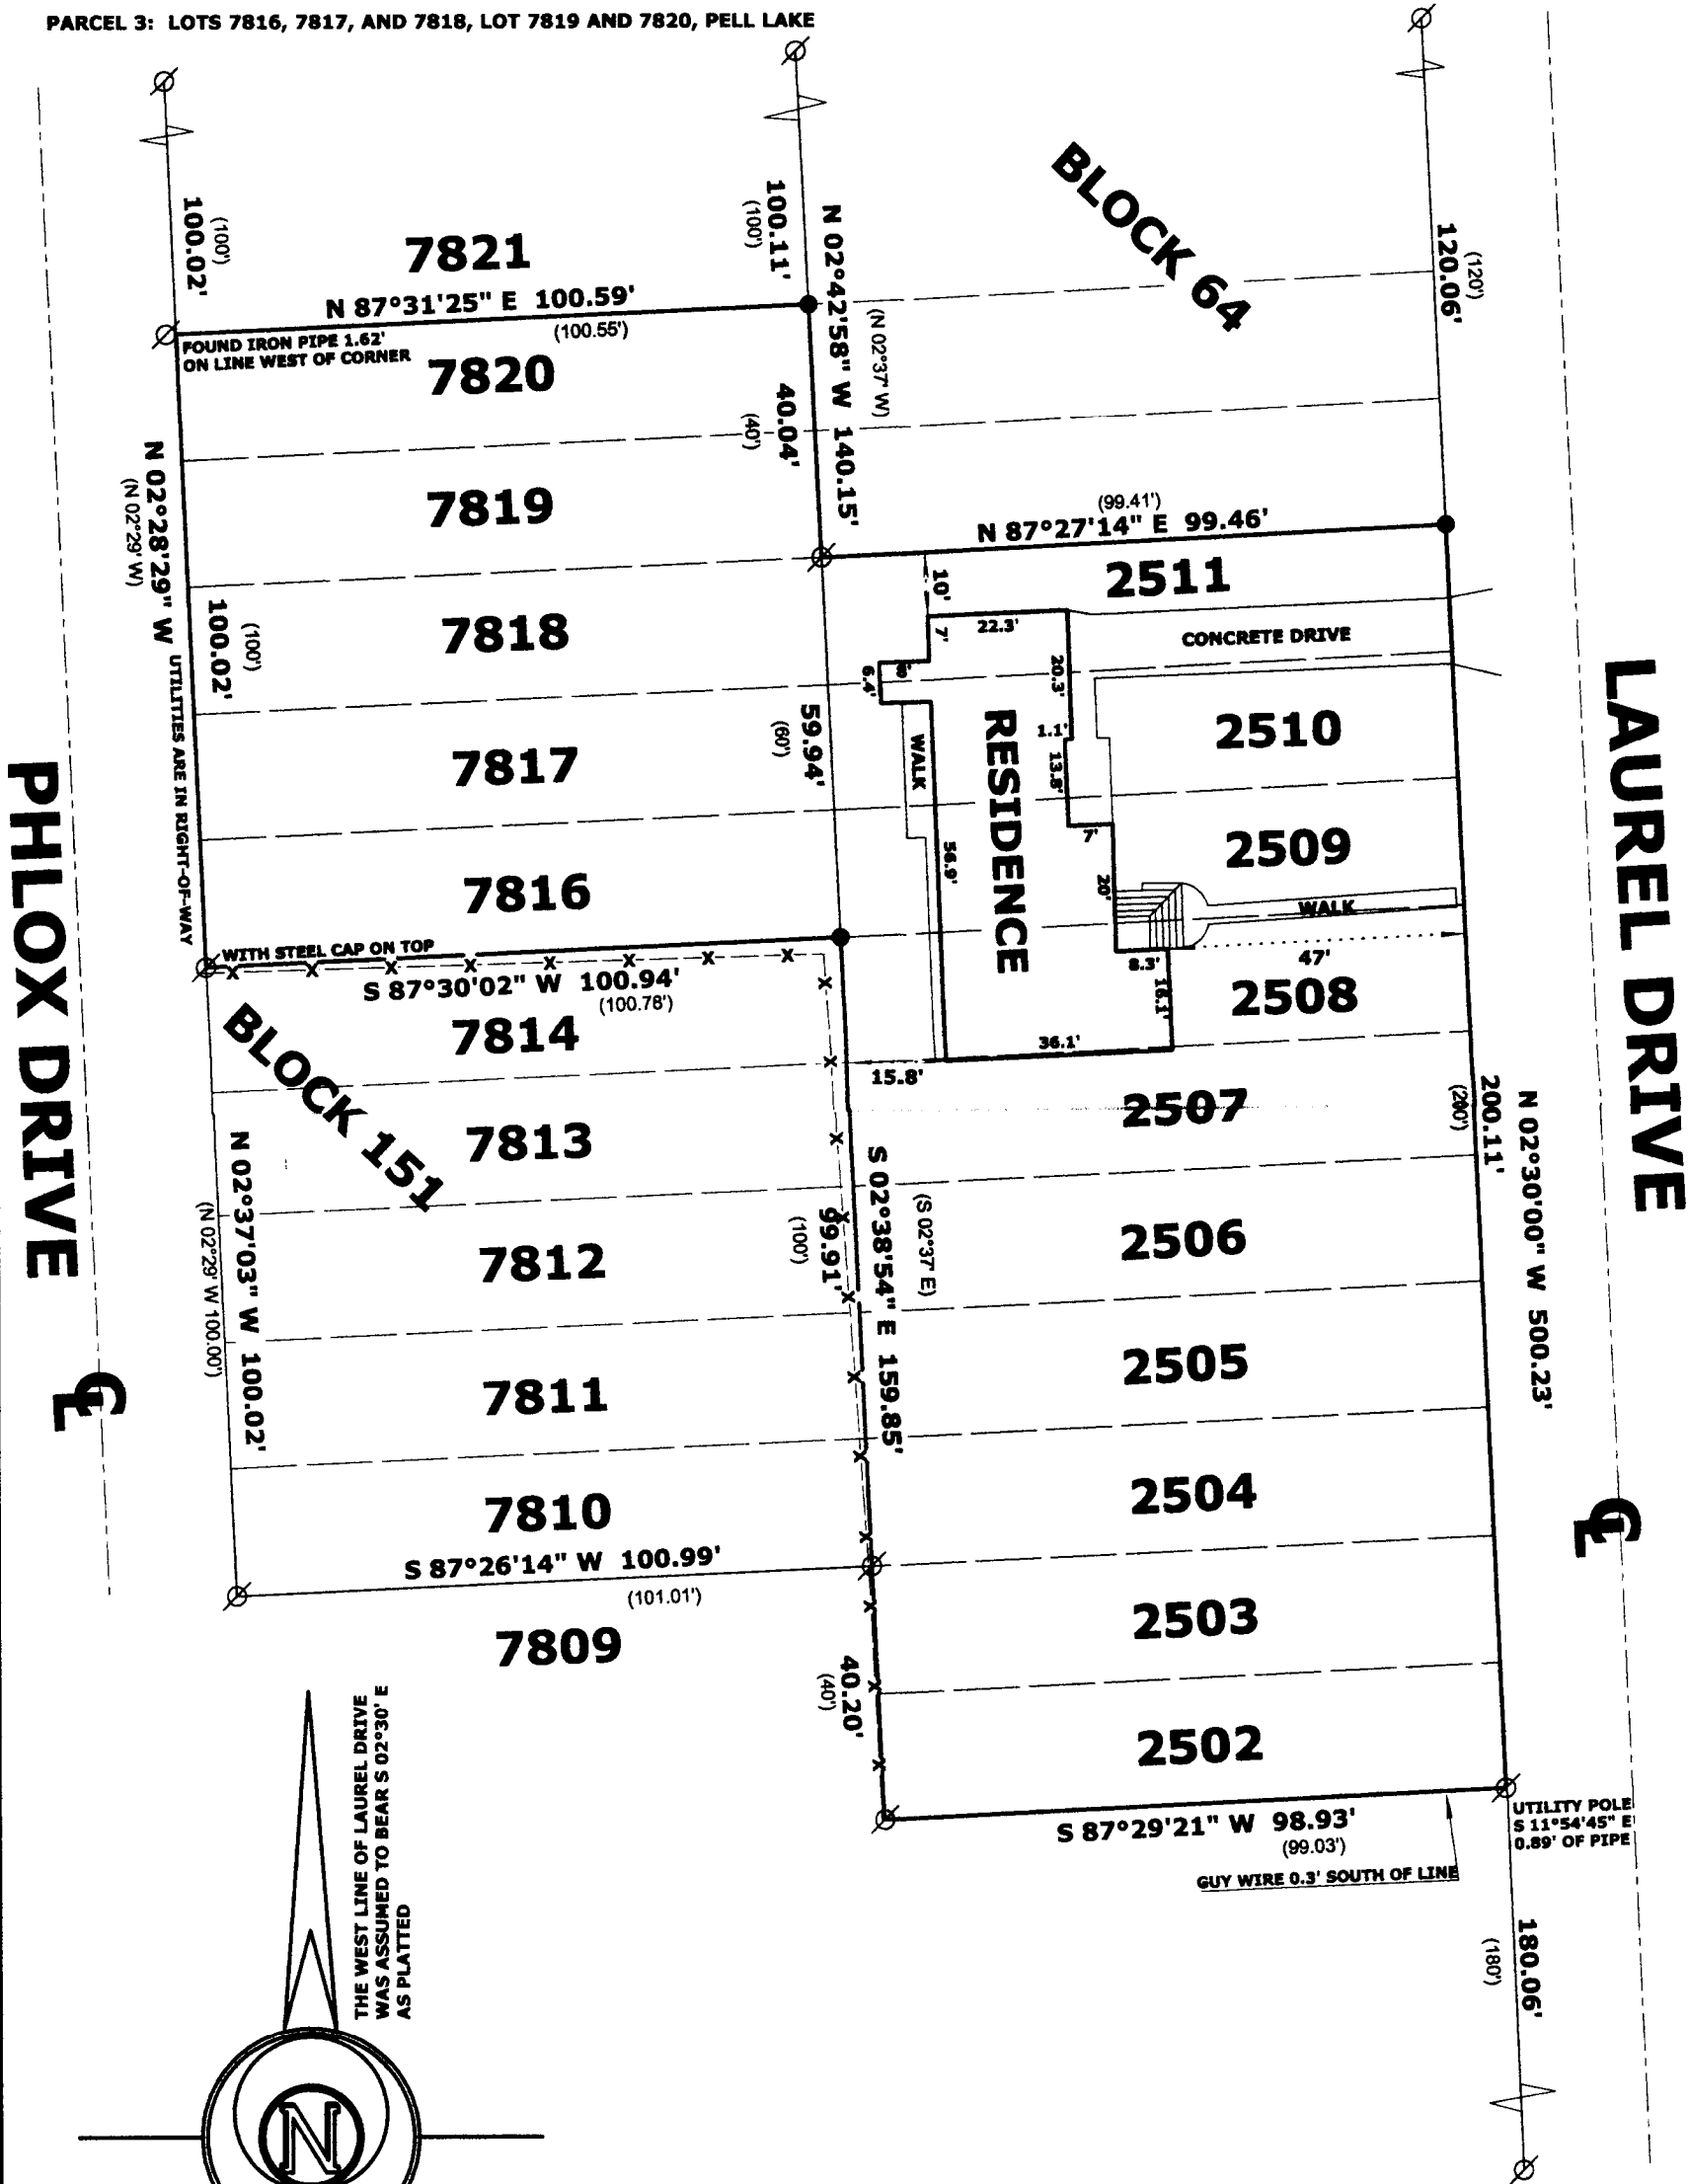

LEGEND

- FOUND IRON PIPE
- SET IRON ROD, 18" LONG, WEIGHING 1.5 LBS./LINEAL FT., 3/4" DIA.
- RECORDED AS DIMENSION
- EXISTING FENCE

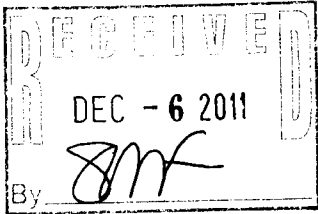

SCALE: 1 INCH = 30 FEET

"I hereby certify that the above described property has been surveyed by me or under my direction and that the above map is a true representation thereof and shows the size and location of the property, its exterior boundaries, the location of all visible structures and dimensions of all principal buildings thereon, boundary fences, apparent easements, roadways and visible encroachments, if any."
"This survey is made for the use of the present owners of the property, and also those who purchase, mortgage, or guarantee the title thereto within one year from date hereof."

Mark L. Miritz
MARK L. MIRITZ
WISCONSIN REGISTERED
LAND SURVEYOR S-2582

DATE: NOV. 10, 2011 JOB NO. 11.1002

MPL-520

118-3094