


KOLB LAND CONSULTING, INC.
LAND SURVEYING • SUBDIVIDING • LAND PLANNING

929 WILLIAMS STREET LAKE GENEVA, WISCONSIN 53147 414-248-3697

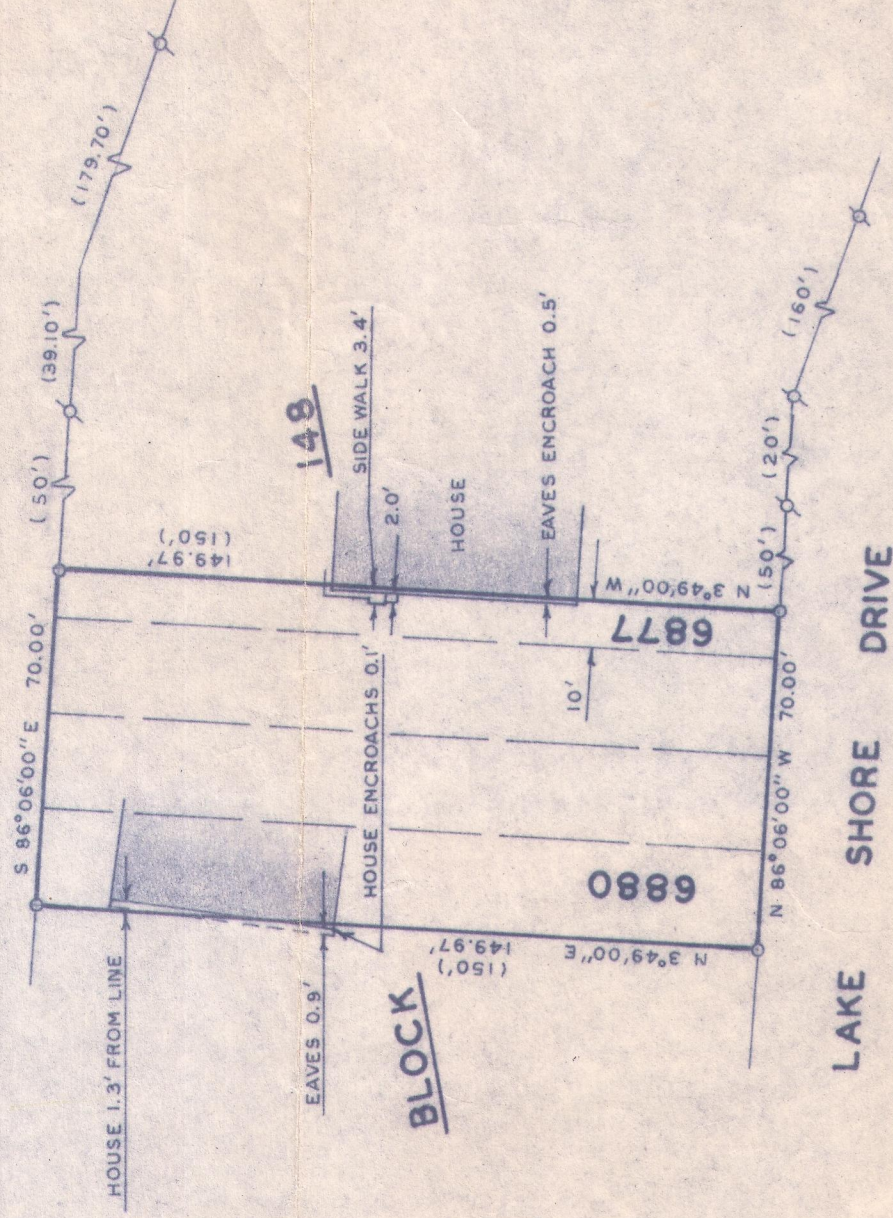

PLAT OF SURVEY OF

LOTS 6878-6880 AND THE WEST 1/2 OF LOT 6877, BLOCK 148
PELL LAKE SUBDIVISION, T 1 N, R 18 E, WALWORTH COUNTY
WISCONSIN.

OWNER: DANILE R. HAYES
P.O. BOX 625
PELL LAKE, WI 53157



I, HAROLD H. KOLB, DO HEREBY CERTIFY
THAT I HAVE SURVEYED THE PROPERTY
HEREON DESCRIBED ACCORDING TO THE
OFFICIAL RECORDS, AND THAT THE PLAT
HEREON IS A CORRECT REPRESENTATION
OF THE LOT LINES TO THE BEST OF MY
KNOWLEDGE AND BELIEF.



LEGEND

- IRON PIPE FOUND
- IRON PIPE SET
- () RECORDED AS

Harold H. Kolb
HAROLD H. KOLB

WISCONSIN REGISTERED LAND SURVEYOR, S-187

DATE MAY 10, 1985

REVISED

REVISED