


PLAT OF SURVEY

- OF -

LOTS 1351-1354 OF BLOCK 22 OF PELL LAKE ADDITION,
A SUBDIVISION LOCATED IN SECTIONS 13 AND 23, T1N, R18E,
WALWORTH COUNTY, WISCONSIN.

PREPARED FOR
RENEE DANIALS
AND
TAMMI HASSE

PATHFINDER SURVEYING INC.
(formerly)
J.K. SURVEYING INC.
P.O BOX 322
LAKE GENEVA, WI. 53147
WWW.PATHFINDERSURVEYING.NET
262-248-8303

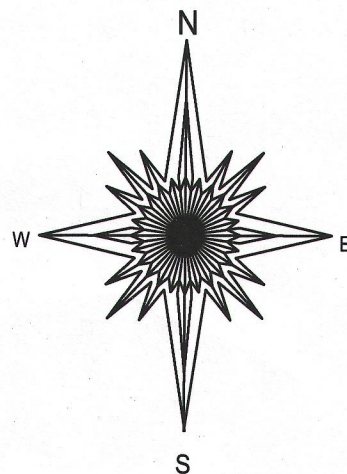


NOTE: BASIS OF BEARING, WISTERIA RD. ASSUMED EAST - WEST.

- () = recorded as
□ = found iron bar
○ = found iron pipe
● = set iron pipe
■ = set iron bar


SCALE 1" = 20'

JOB # 04-494TAB

TAX ID # MPLA00279

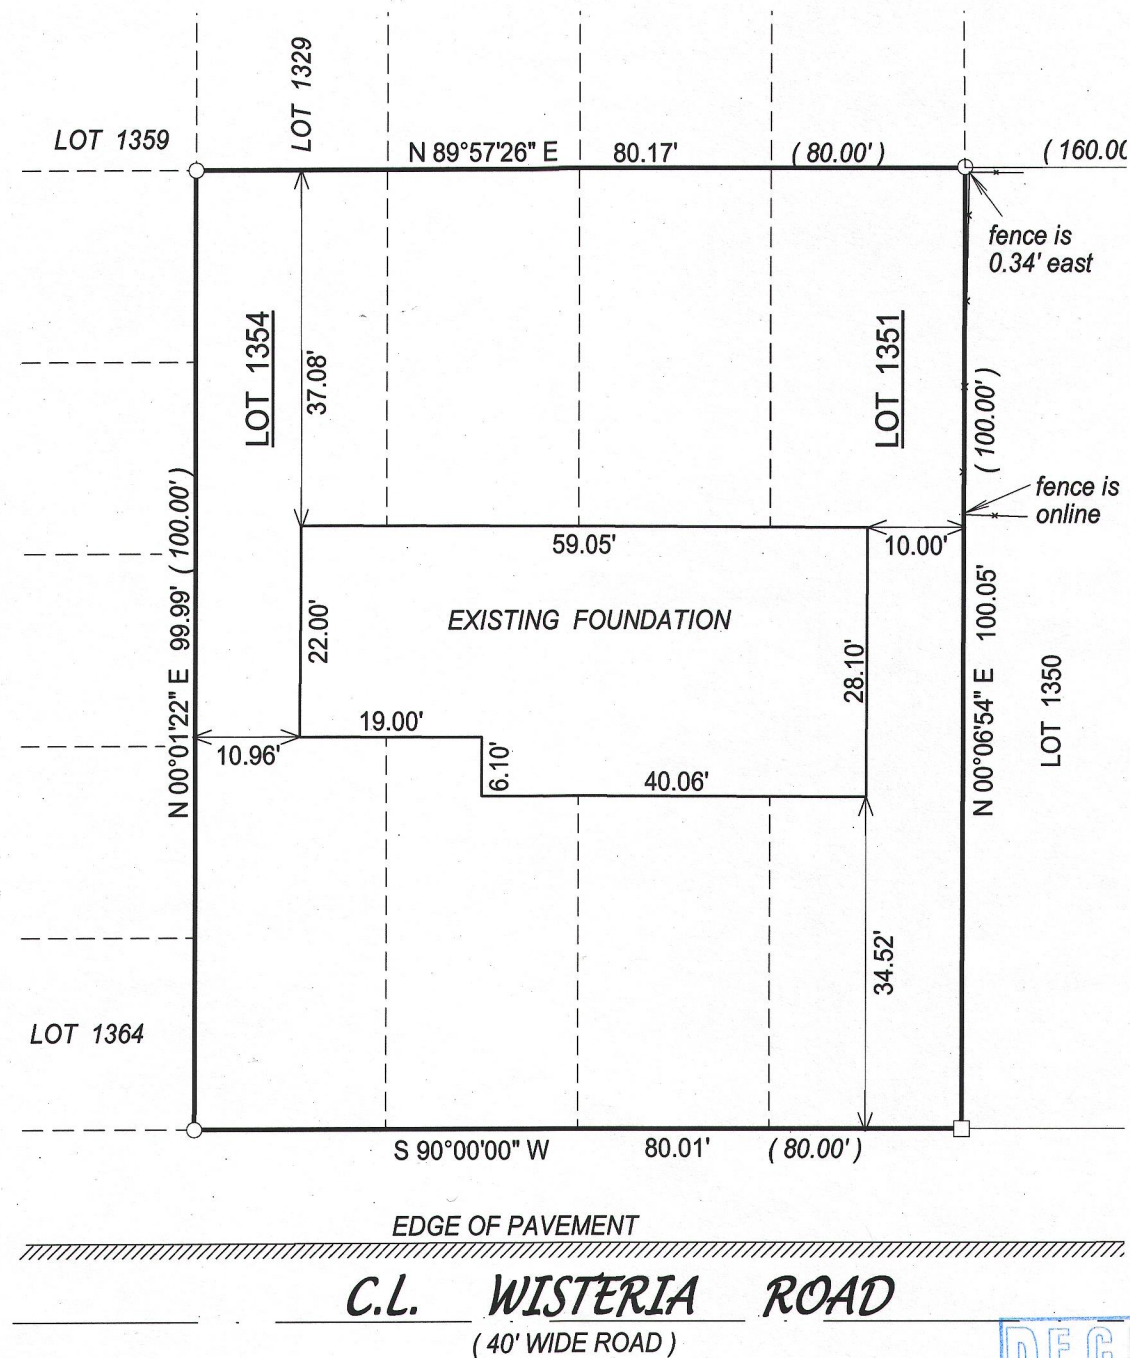


revised 2/21/2013 updated and
added fence location

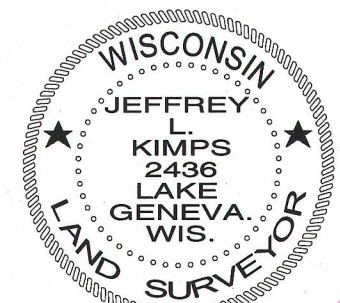

JEFFREY L. KIMPS, S-2436
Wisconsin Registered Land Surveyor
(original if signed in red)

REVISED 6-14-2006 (ASBUILT)
REVISED 2-24-2005
DATED THIS THE 28th DAY OF SEPTEMBER, 2004.

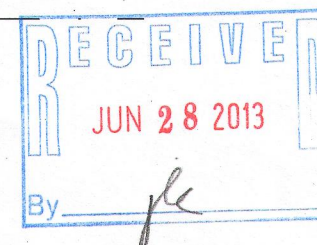

8PLA-279 118-3143