




PREPARED FOR
MARY ANN LOENNEKE
SHOREWEST REALTY
LAKE GENEVA, WI.

PLAT OF SURVEY

- OF -

PATHFINDER SURVEYING INC.
(formerly)
J.K. SURVEYING INC.
P.O BOX 322
LAKE GENEVA, WI. 53147
WWW.PATHFINDERSURVEYING.NET
262-248-8303

THE WEST 1/2 OF LOT 6877 EXCEPT THE THE EAST 3.4 FEET,
LOTS 6878, 6879 AND 6880, BLOCK 148 AND THE EAST 5.00 FEET
OF LOT 6881, BLOCK 148, PELL LAKE SUBDIVISION, TOWN 1 NORTH,
RANGE 18 EAST VILLAGE OF BLOOMFIELD, WALWORTH COUNTY,
WISCONSIN.

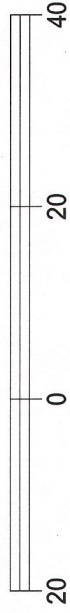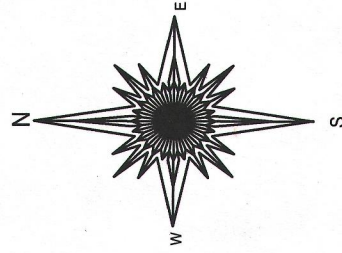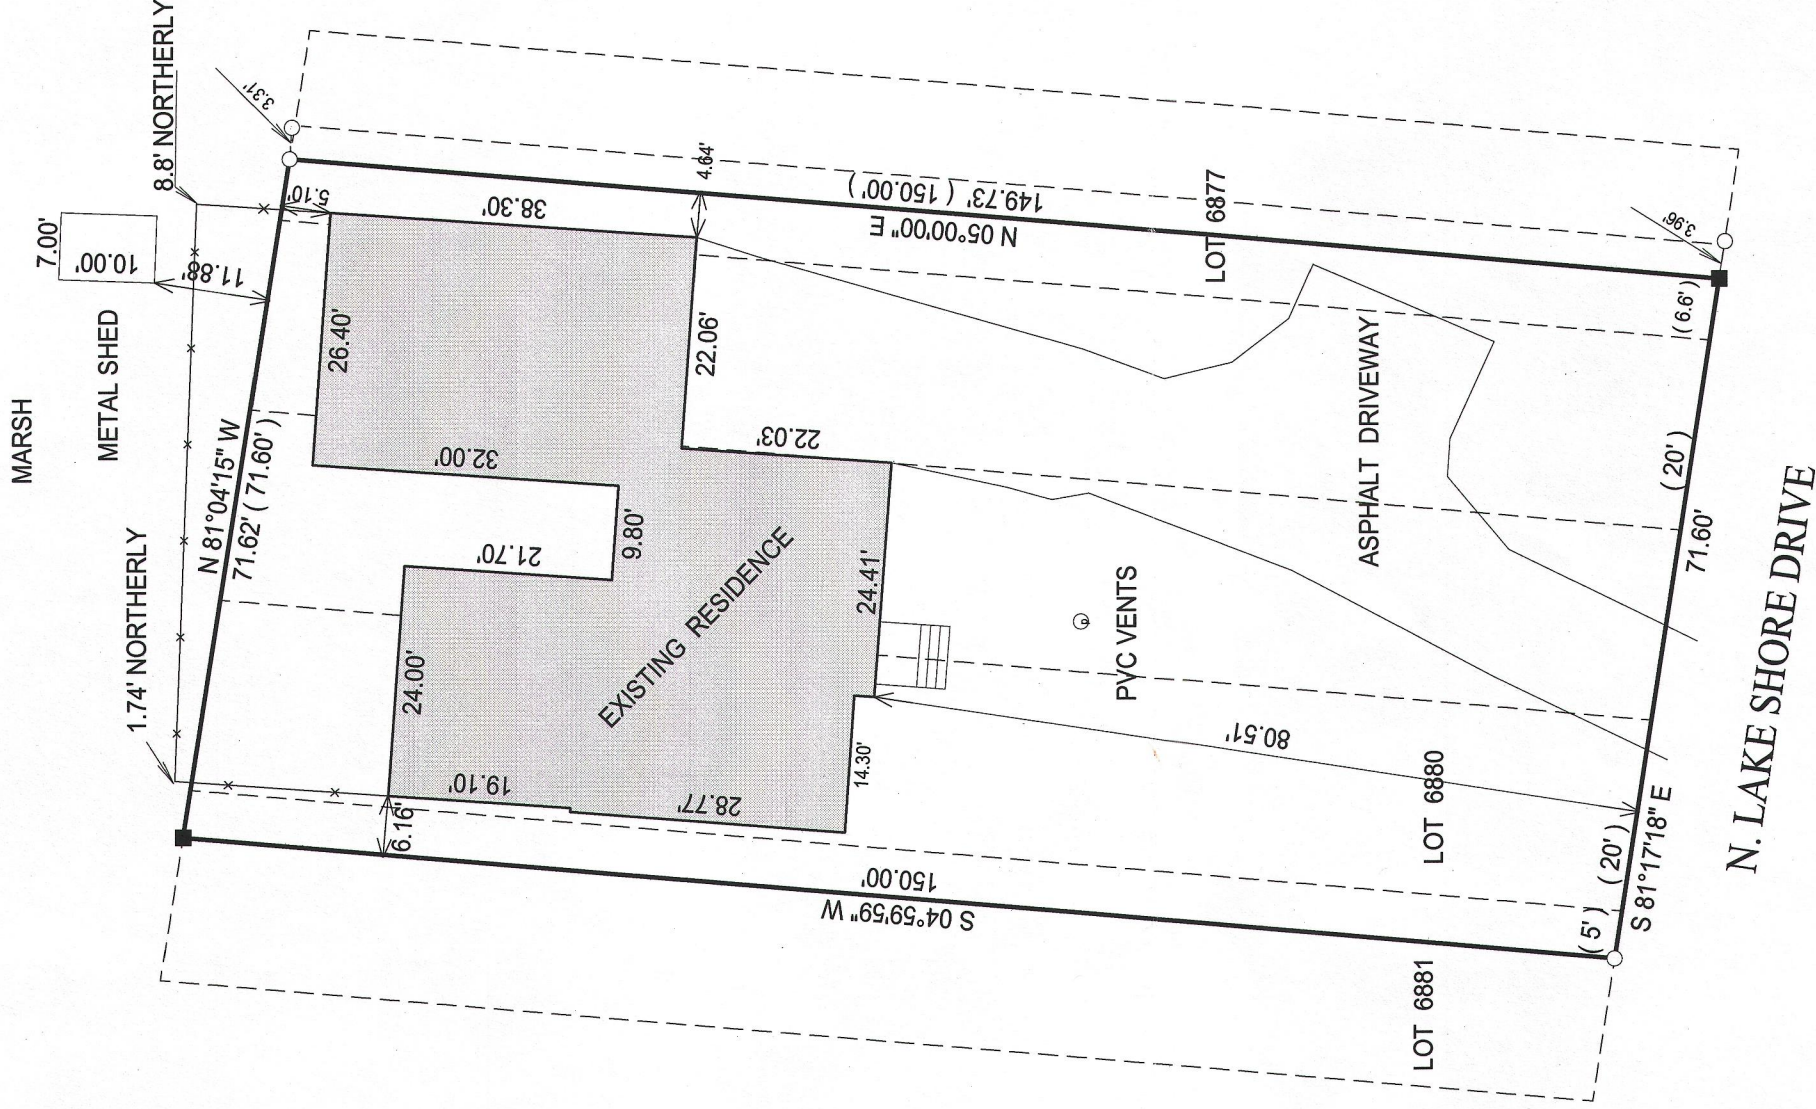

BASIS OF BEARING OF THIS PLAT: THE EAST LINE OF THE ABOVE
SURVEY WAS ASSUMED TO BEAR N 5° E.

I hereby certify that I have surveyed the above- described property and the
above map is a true representation thereof and shows the size and
location of the property, its exterior boundaries, the location and
dimensions of all structures thereon, fences, appurtenant easements and
roadways and visible encroachments if any.

This survey is made for the present owners of the property, and those who
purchase, mortgage, or guarantee the title thereto, within one year from
the date hereof.

JOB # 13-77

TAX ID #
&PL 01498



[Signature]

JEFFREY L KIMPS S - 2436
Wisconsin Registered Land Surveyor
(original if signed in red)

DATED THIS 5TH DAY OF JUNE, 2013.

&PL -1498

118-3144