





PREPARED FOR
ROBIN WALTON-PRIBBLE
P.O. BOX 234
DELAVER WI. 53115

PLAT OF SURVEY

-OF-

THE WEST 1/2 OF LOT 5864 AND LOTS 5865 THRU 5867
BLOCK 132 OF PELL LAKE SUBDIVISION, TOWN 1 NORTH,
RANGE 18 EAST, WALWORTH COUNTY, WISCONSIN.


KROTT SURVEYING INC.
N3705 WILLOW BEND LANE
LAKE GENEVA WI. 53147
PHONE # (262)248-3697
FAX # (262)249-0639

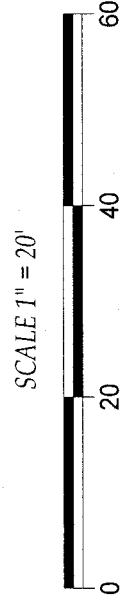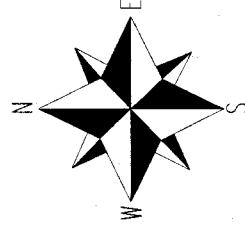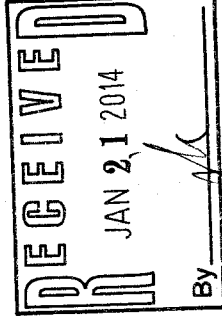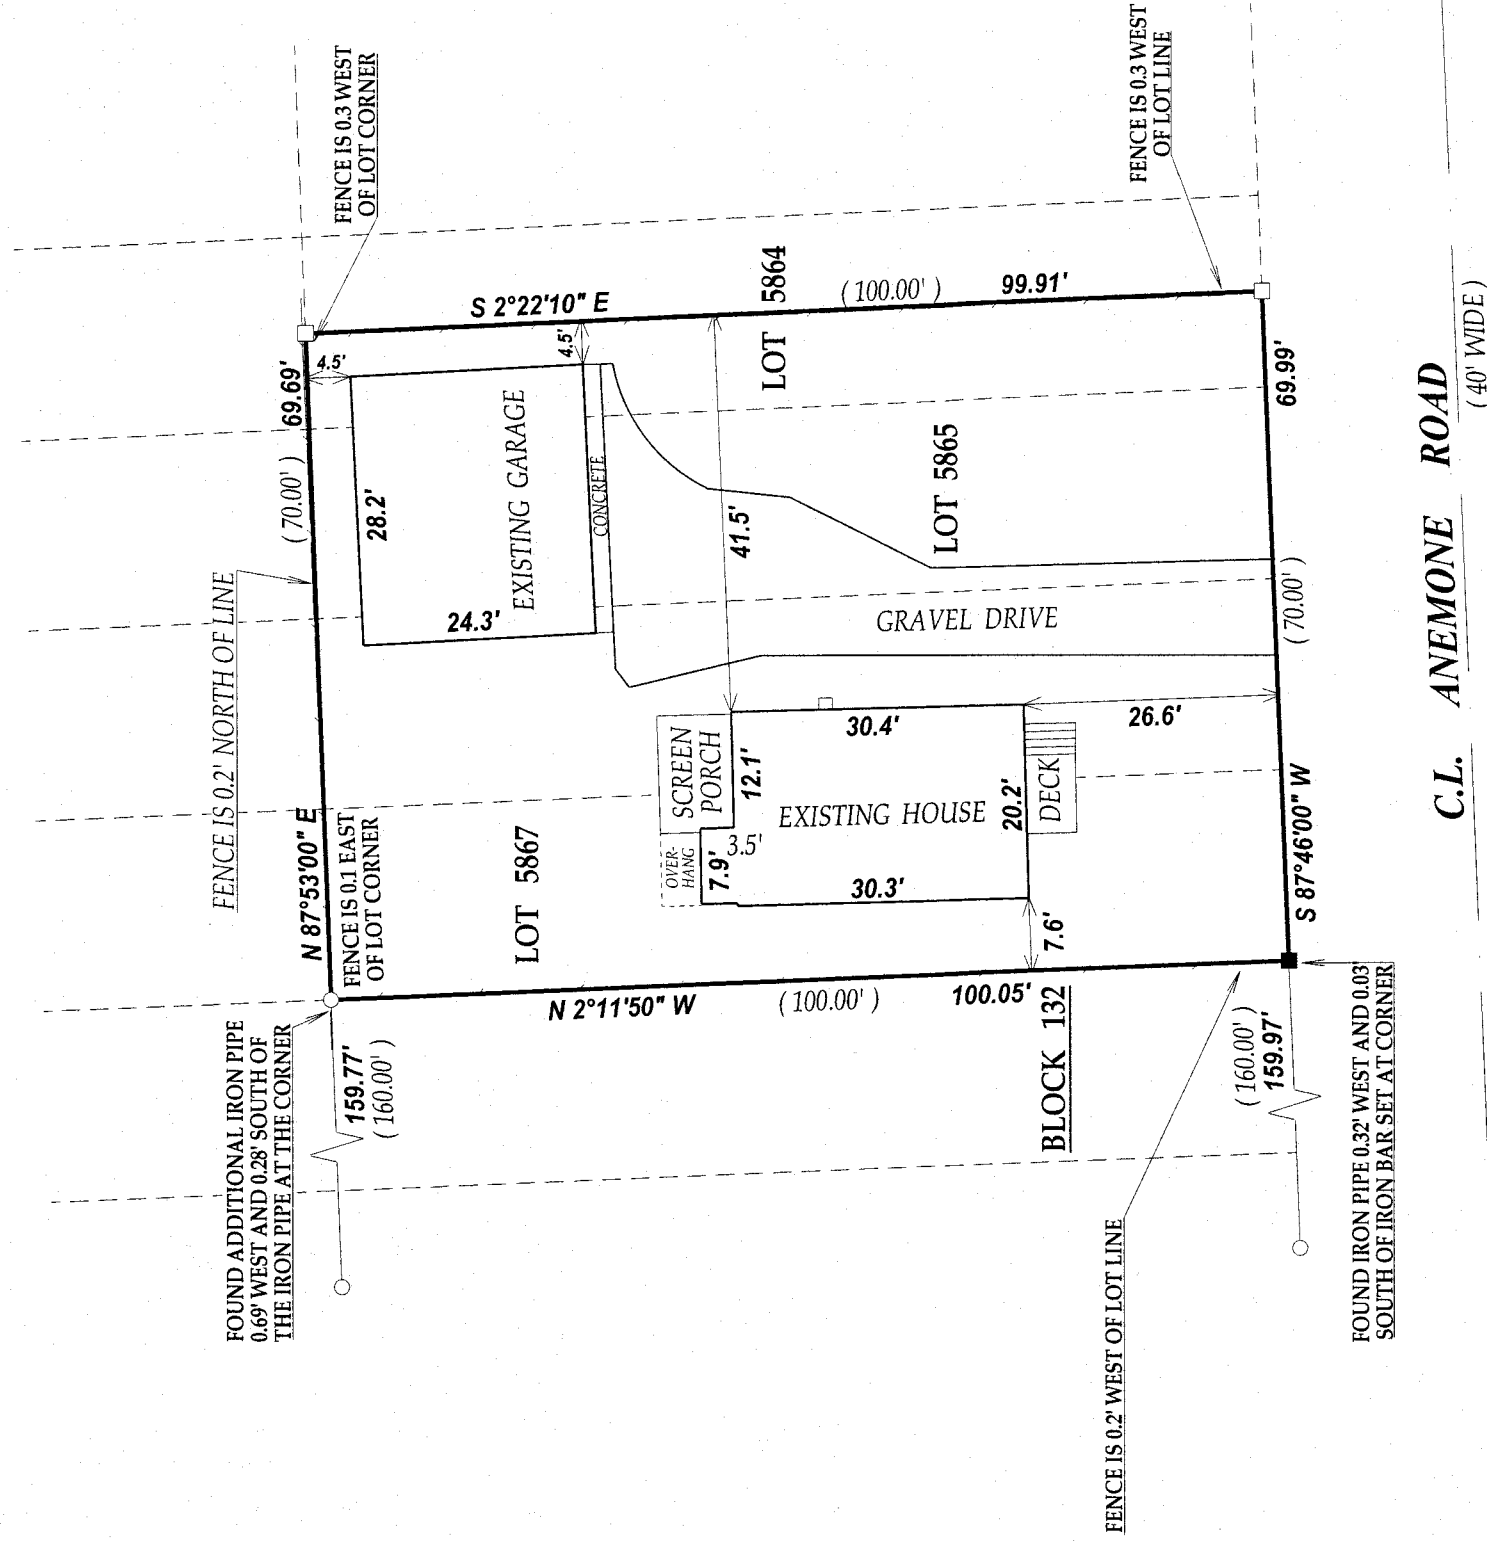

- LEGEND
- FOUND IRON PIPE
 - FOUND IRON BAR
 - SET IRON BAR
 - (xx) RECORDED AS
- TAX ID # MPL01273
JOB # 09-116UD2013

I have surveyed the above-described property and the above map is a true representation thereof and shows the size and location of the property, its exterior boundaries, the location and dimensions of all structures thereon, fences, apparent easements and roadways and visible encroachments, if any.

This survey is made for the exclusive use of the present owners of the property, and also those who purchase, mortgage, or insure the title thereto within one (1) year from date hereof, and as to them I warrant the accuracy of said survey map.

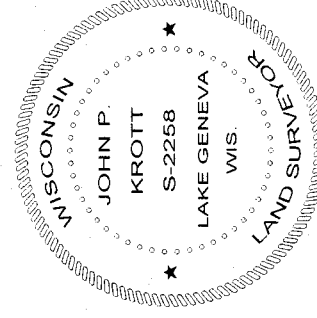

DATED THIS 24th DAY OF AUGUST 2009.
DATE OF LAST REVISION 10/16/2013

John P. Krott

JOHN KROTT S - 2258
Wisconsin Registered Land Surveyor
(original if signed in red)

8PL-1273

118-3162