



PLAT OF SURVEY
LOTS 2093 THRU 2099
PELL LAKE SUBDIVISION
TOWN OF BLOOMFIELD
WALWORTH COUNTY, WISCONSIN

Lots 2093, 2094, 2095, 2096, 2097, 2098 and 2099, Block 43, as designated and delineated on the Map entitled "Map of Section Two" of Pell Lake, Walworth County, Wisconsin," and recorded in the Office of the Register of Deeds for the County of Walworth and State of Wisconsin on the 16th day of July, 1924.



Parcel No.:
&PL 00434

WORK ORDERED BY:
FRANK GENTILE
PO BOX 826
PELL LAKE, WI. 53154


FARRIS, HANSEN & ASSOCIATES, INC.
Engineering, Architecture, Surveying
7 Ridgway Court P.O. Box 437
ELKHORN, WISCONSIN 53121
Office: (414) 723-2098
Fax: (414) 723-5886

REVISIONS
03/08/2006
TO SHOW
SIZE AND
LOCATION OF
PROPOSED
RESIDENCE
06/06/2006
TO SHOW SIZE
AND LOCATION
OF AS-BUILT
RESIDENCE

PROJECT NO.
5237
DATE:
03-22-99
SHEET NO.
1 OF 1

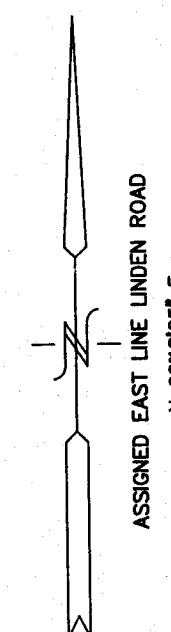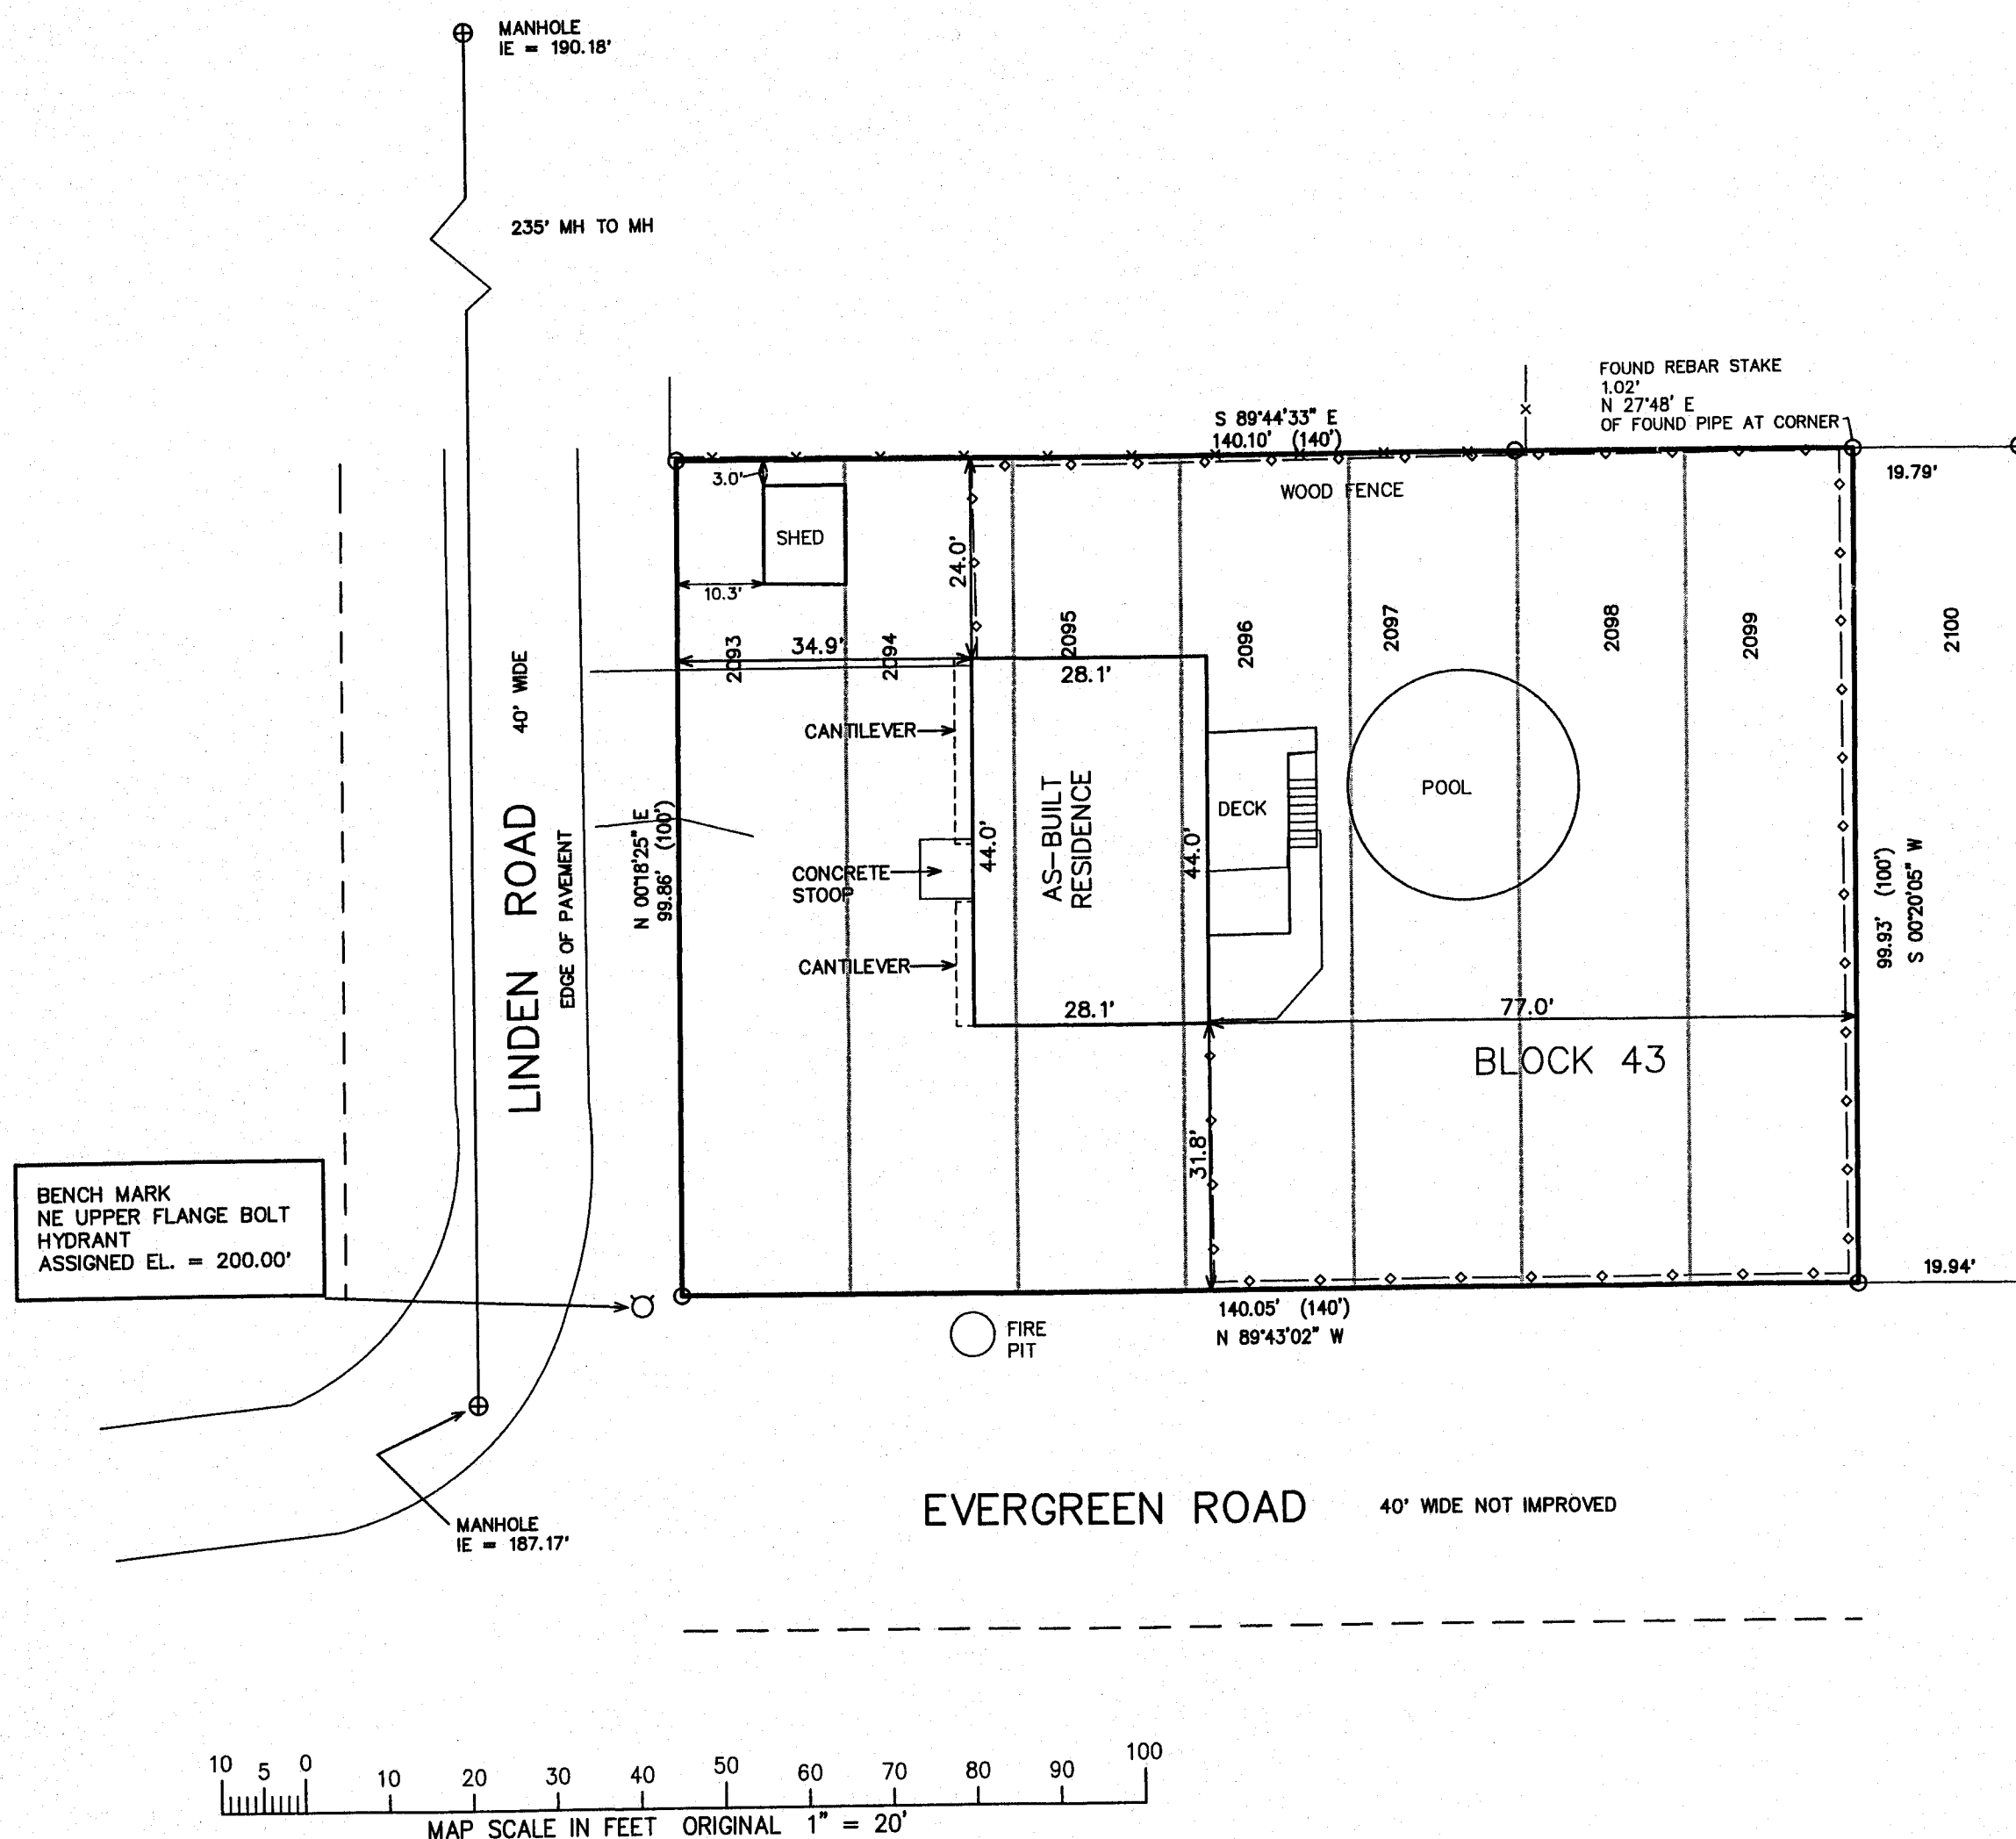

○ = FOUND IRON PIPE STAKE
(xxx) = RECORDED AS

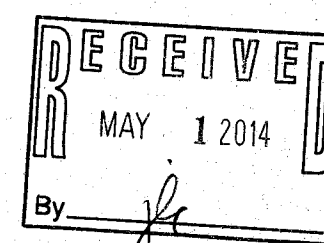

NOTE: COPIES OF THIS MAP TO WHICH THE FOLLOWING CERTIFICATE WILL APPLY SHOW THE SURVEYOR'S ORIGINAL SEAL AND SIGNATURE IN RED INK. COPIES BY ANY OTHER MEANS MAY HAVE ALTERATIONS WHICH DO NOT REPRESENT THE SURVEYOR'S WORK PRODUCT.

I HEREBY CERTIFY THAT THE ABOVE DESCRIBED PROPERTY HAS BEEN SURVEYED UNDER MY DIRECTION AND THAT THE ABOVE MAP IS A TRUE REPRESENTATION THEREOF AND SHOWS THE SIZE AND LOCATION OF THE PROPERTY, ITS EXTERIOR BOUNDARIES, THE LOCATION OF ALL VISIBLE STRUCTURES, AND DIMENSIONS OF ALL PRINCIPLE BUILDINGS THEREON, BOUNDARY FENCES, APPARENT EASEMENTS, ROADWAYS, AND VISIBLE ENCROACHMENTS, IF ANY. THIS SURVEY IS MADE FOR THE USE OF THE PRESENT OWNERS OF THE PROPERTY, AND ALSO THOSE WHO PURCHASE, MORTGAGE, OR GUARANTEE THE TITLE THERETO WITHIN ONE YEAR FROM THE DATE HEREOF.

DATED: APRIL 24, 2014

Peter S. Gordon
PETER S. GORDON

8PL -434

118-3169

APR 24 2014