



PLAT OF SURVEY

-OF-

LOT 3 IN BLOCK 1 OF PART ONE OF FIRST ADDITION TO JEFFERSON ISLAND SUBDIVISION, BEING A PART OF THE SOUTHEAST 1/4 OF SECTION 13 IN TOWN 1 NORTH OF RANGE 18 EAST OF THE FOURTH PRINCIPAL MERIDIAN, IN THE VILLAGE OF BLOOMFIELD, COUNTY OF WALWORTH AND STATE OF WISCONSIN.

SURVEY FOR: KEATING REAL ESTATE
SURVEY ADDRESS: W142 92nd STREET

PLATTED MEANDER LINE WAS USED AS THE BEARING BASE FOR THIS SURVEY.
S53°53'20"E 160.08'
(160.28')

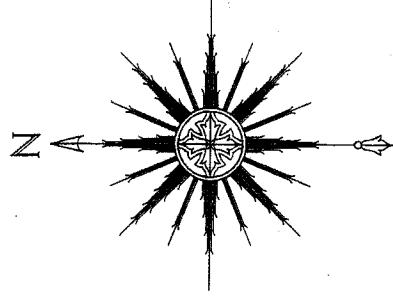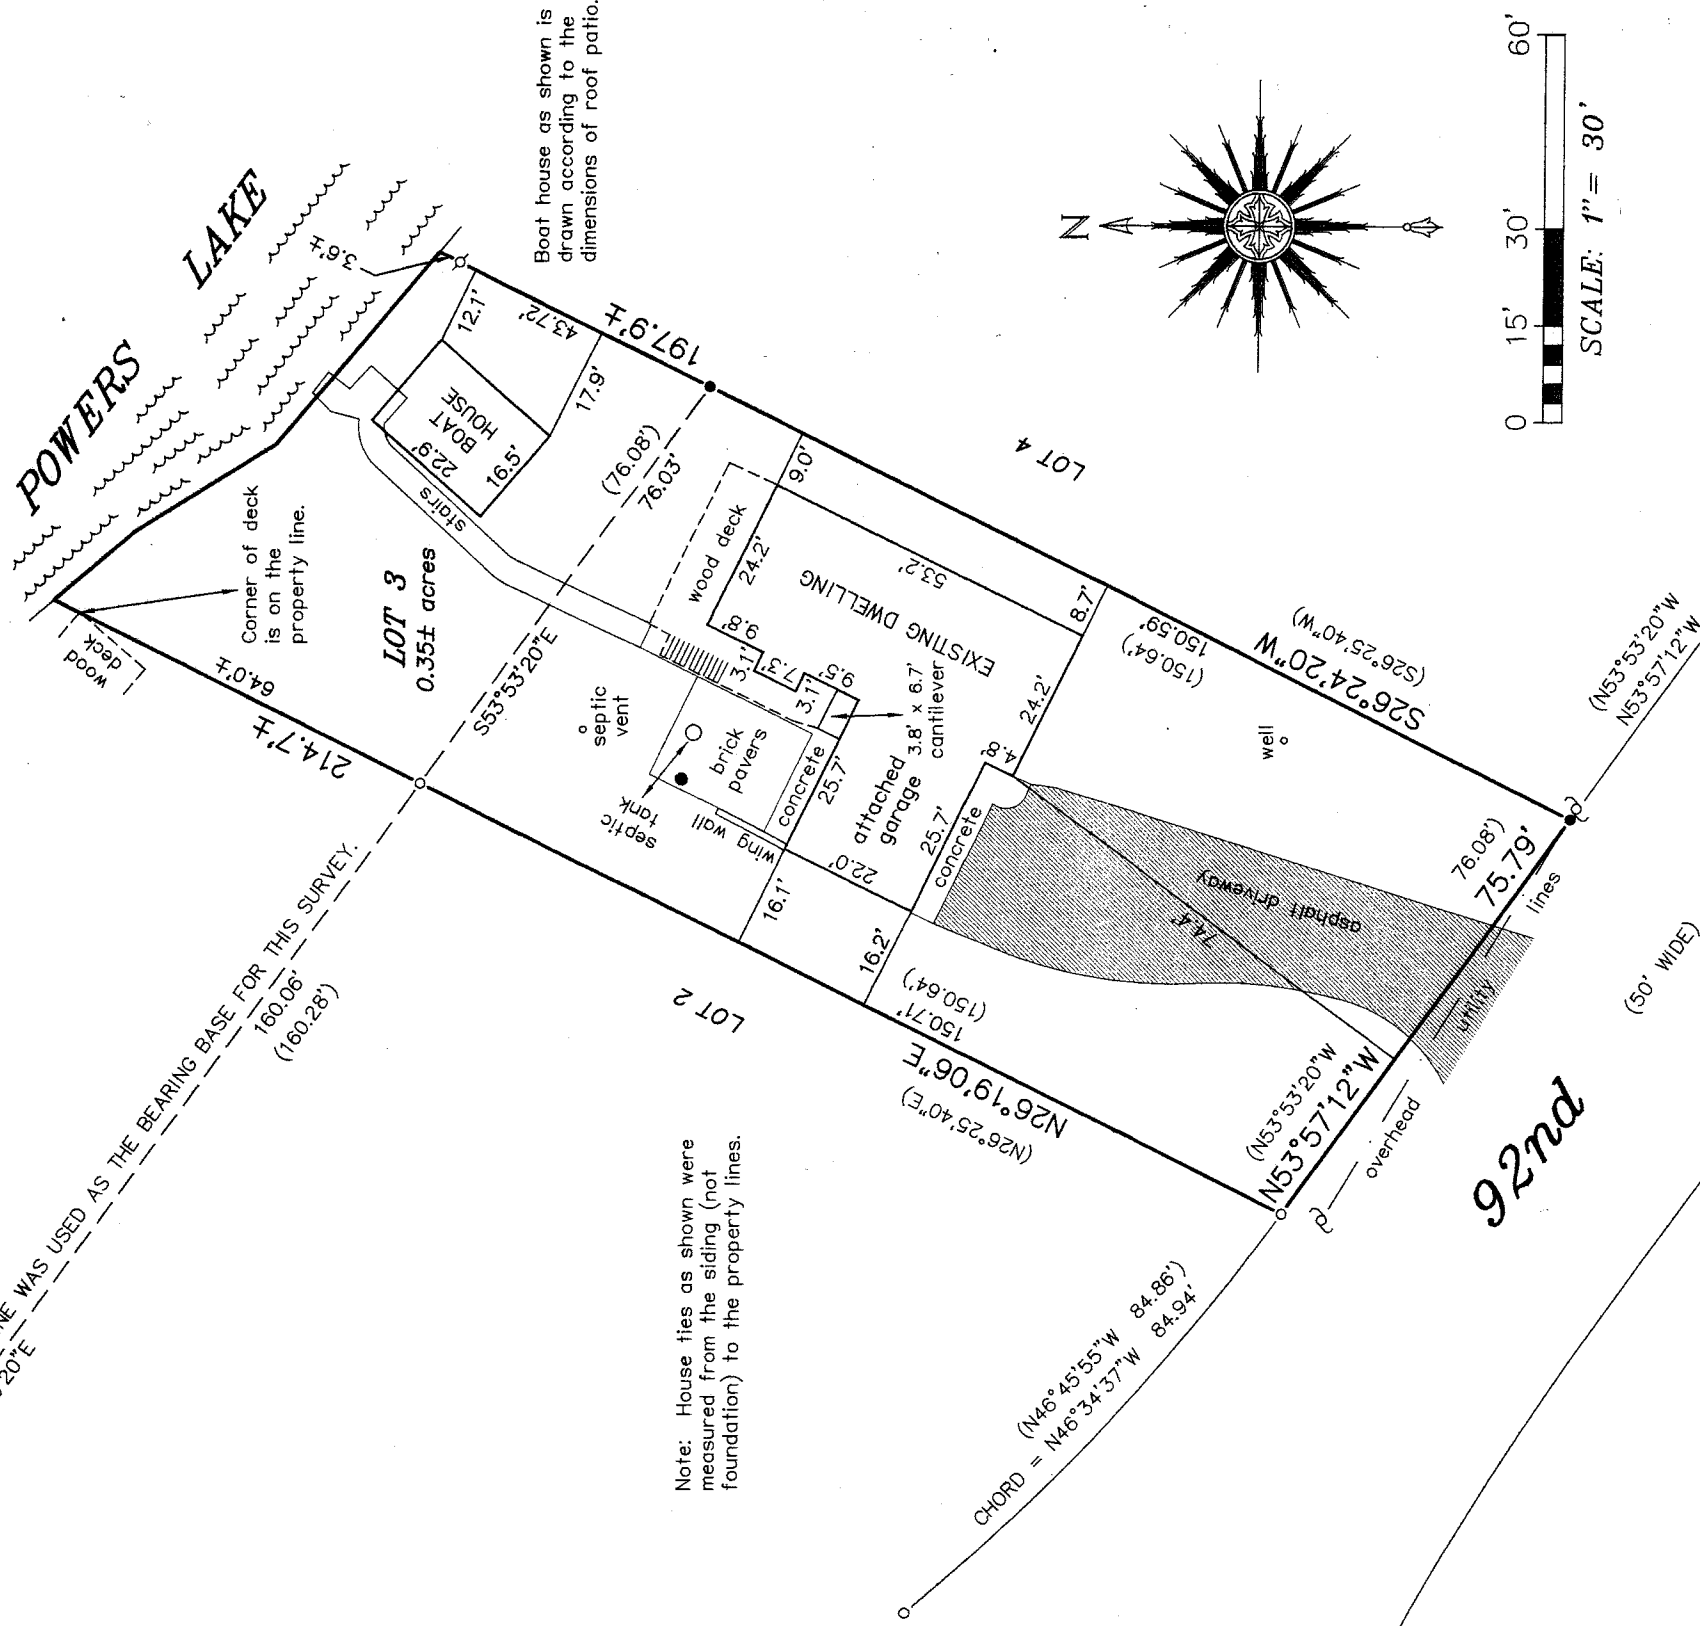

SCALE: 1" = 30'


LEGEND

- ⊕ FOUND CONCRETE MONUMENT
- FOUND IRON PIPE
- FOUND IRON ROD
- ⊗ SET IRON PIPE
- ⊙ UTILITY POLE
- () RECORDED AS

"I, HEREBY CERTIFY THAT I HAVE SURVEYED THE ABOVE DESCRIBED PROPERTY AND THAT THE ABOVE MAP IS A CORRECT REPRESENTATION THEREOF AND SHOWS THE SIZE AND LOCATION OF THE PROPERTY, ITS EXTERIOR BOUNDARIES, THE LOCATION OF ALL VISIBLE STRUCTURES AND DIMENSIONS OF ALL PRINCIPAL BUILDINGS THEREON, BOUNDARY FENCES, APPARENT EASEMENTS, ROADWAYS AND ENCROACHMENTS, IF ANY."

"THIS SURVEY IS MADE FOR THE USE OF THE PRESENT OWNERS OF THE PROPERTY, AND THOSE WHO PURCHASE, MORTGAGE, OR GUARANTEE THE TITLE THERETO WITHIN ONE YEAR FROM DATE HEREOF."

SATTER SURVEYING, LLC
LAND SURVEYS, MAPPING AND PLANNING
272 ORIGIN STREET
BURLINGTON, WI 53105
262-661-4239

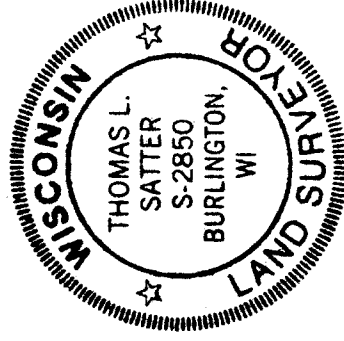

THIS IS NOT AN ORIGINAL PRINT
UNLESS THIS SEAL IS RED.

Thomas L. Satter

THOMAS L. SATTER

S-2850

APRIL 21, 2014

DATE

041411

JOB NUMBER

8118 -3 118-3172