


PLAT OF SURVEY
-OF-

LOT 5, LAKE GENEVA AIRE ESTATES, ACCORDING TO THE RECORDED PLAT THEREOF, SAID LAND BEING IN THE VILLAGE OF BLOOMFIELD, COUNTY OF WALWORTH AND STATE OF WISCONSIN.

SURVEY FOR: FRED GELDERMANN OF RE/MAX GENEVA REALTY
SURVEY ADDRESS: N2205 LYNN LANE, LAKE GENEVA, WI 53147

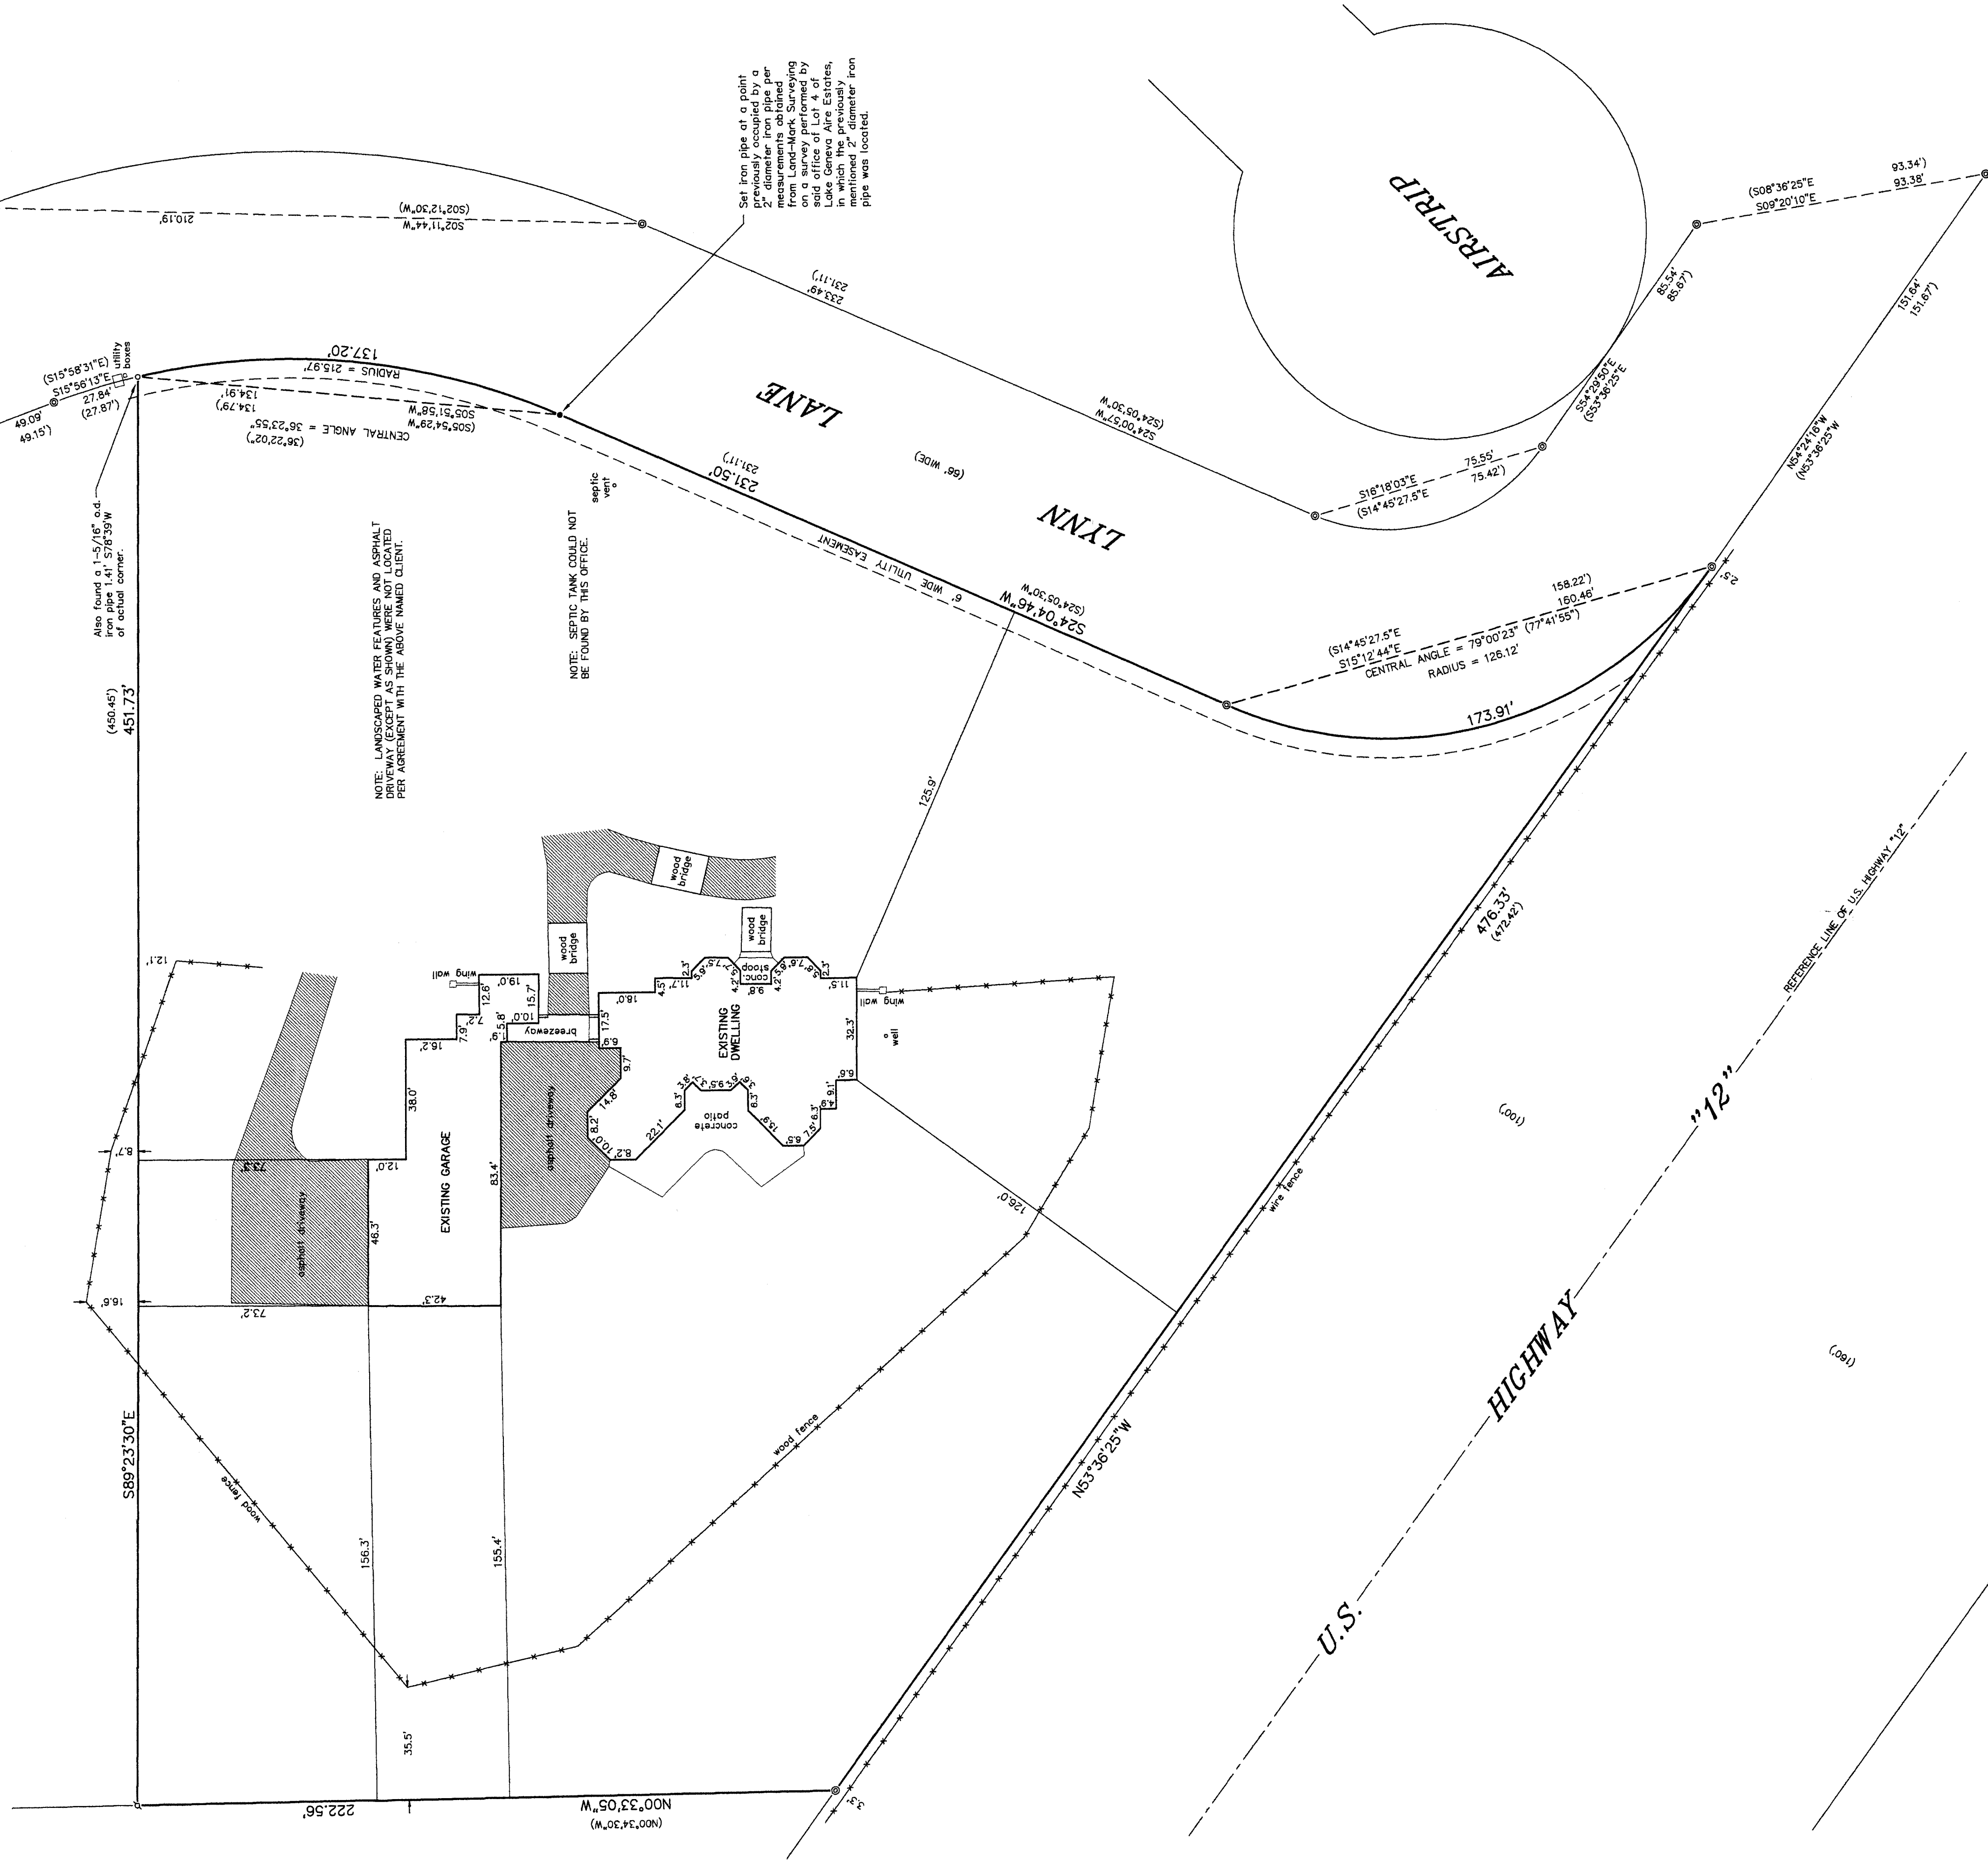



"I HEREBY CERTIFY THAT I HAVE SURVEYED THE ABOVE DESCRIBED PROPERTY AND THAT THE ABOVE MAP IS A CORRECT REPRESENTATION THEREOF AND IS EXHIBIT TO THE RECORDED PLAT THEREOF. I HAVE ALSO EXAMINED THE RECORDS OF THE COUNTY CLERK AND HAVE FOUND NO OTHER PLATS OF SURVEY OF THE SAME PROPERTY. I HAVE ALSO EXAMINED THE RECORDS OF THE COUNTY CLERK AND HAVE FOUND NO OTHER PLATS OF SURVEY OF THE SAME PROPERTY. I HAVE ALSO EXAMINED THE RECORDS OF THE COUNTY CLERK AND HAVE FOUND NO OTHER PLATS OF SURVEY OF THE SAME PROPERTY."

"THIS SURVEY IS MADE FOR THE USE OF THE PRESENT OWNER AND HIS HEIRS AND assigns, and is subject to any mortgage, or guarantee, the title thereto within one year from date hereof."

SATER SURVEYING, LLC


LAND SURVEYS, MAPPING AND PLANNING
272 ORIGIN STREET
BURLINGTON, WI 53105
262-601-4239

- LEGEND
- FOUND 2" I.D. OR O.D. IRON PIPE
 - ⌀ FOUND 1-1/2" O.D. IRON PIPE
 - FOUND 1-1/4" DIA. PINCHED PIPE
 - SET 1-5/16" O.D. IRON PIPE
 - () RECORDED AS

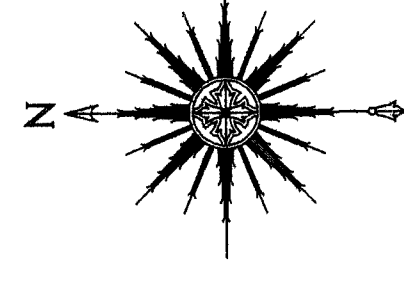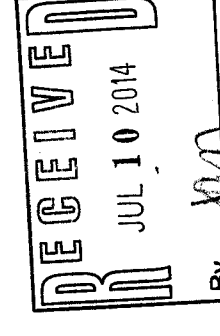

0 15' 30' 60'
SCALE: 1" = 30'

BEARINGS HEREON RELATE TO THE NORTH LINE OF LOT 5 OF LAKE GENEVA AIRE ESTATES, ASSUMED BEARING OF SOUTH 89°23'30" EAST AS PLATED.

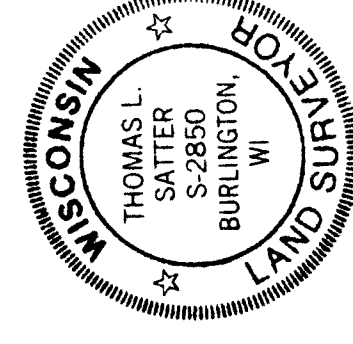

THIS IS NOT AN ORIGINAL PRINT
UNLESS THIS SEAL IS RED.

Thomas L. Satter
THOMAS L. SATER

JUNE 30, 2014
DATE

061408
JOB NUMBER

SLA -S

118-3179