



NOTE: THIS MAP IS BEING REVISED THIS 11TH DAY OF OCTOBER TO SHOW THE LOCATION OF THE FORMER DWELLING AND DECK BEFORE THEY WERE RAZED. THE DWELLING LOCATION WAS DEPICTED ON THE PROPERTY USING MEASUREMENTS TAKEN FROM A PREVIOUS SURVEY BY THIS OFFICE OF THE ADJOINING PROPERTY TO THE NORTH DATED MAY 15, 2011, AS WELL AS MEASUREMENTS SHOWN ON A PREVIOUS SURVEY OF THE SUBJECT PROPERTY BY JENSEN SURVEYING AND MAPPING DATED AUGUST 26, 1986. THE DECK LOCATION WAS DEPICTED USING MEASUREMENTS TAKEN FROM THE WALWORTH COUNTY GIS WEBSITE AND IS AN APPROXIMATE LOCATION.

**PLAT OF SURVEY  
-OF-**

PART OF LOT 14 IN WILLIAM ELLIOTTS POWERS LAKE SUBDIVISION, LOCATED IN THE NORTHEAST 1/4 OF SECTION 13, TOWN 1 NORTH, RANGE 18 EAST, WALWORTH COUNTY, WISCONSIN, DESCRIBED AS FOLLOWS, TO-WIT: BEGINNING AT THE SOUTHWEST CORNER OF SAID LOT 14; THENCE SOUTHEASTERLY ALONG THE SOUTHERLY LINE OF SAID LOT 121.60 FEET, WHICH POINT IS THE NORTHWEST CORNER OF LOT 17; THENCE NORTH 29°50' EAST 6 FEET TO A POINT; THENCE SOUTH 70°10' EAST 149.20 FEET, MORE OR LESS, TO A PUBLIC ROAD; THENCE NORTH 29°50' EAST ALONG SAID ROAD 76.82 FEET, MORE OR LESS, TO THE SHORE OF POWERS LAKE; THENCE NORTHWESTERLY ALONG THE SHORE OF POWERS LAKE 36 FEET, MORE OR LESS, TO A POINT; THENCE NORTH 76°53' WEST 254.27 FEET TO A PUBLIC ROAD; THENCE SOUTH 24°45' WEST 57.13 FEET ALONG SAID ROAD TO THE PLACE OF BEGINNING.

SURVEY FOR: KEATING REAL ESTATE  
SURVEY ADDRESS: N1576 POWERS LAKE ROAD

NOTE: THIS PROPERTY LIES WITHIN A FEMA ZONE "A" AREA, IN WHICH A BASE FLOOD ELEVATION HAS NOT BEEN DETERMINED DUE TO THE FLOODING EFFECTS OF THE EAST BRANCH OF NIPPERSINK CREEK. FEMA MAPS SHOW THE BASE FLOOD ELEVATION FOR POWERS LAKE TO BE 833.0'.

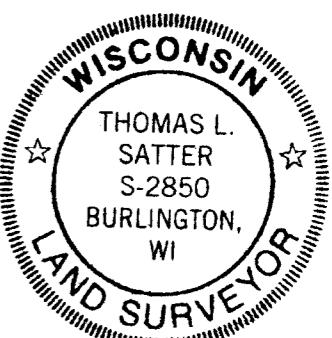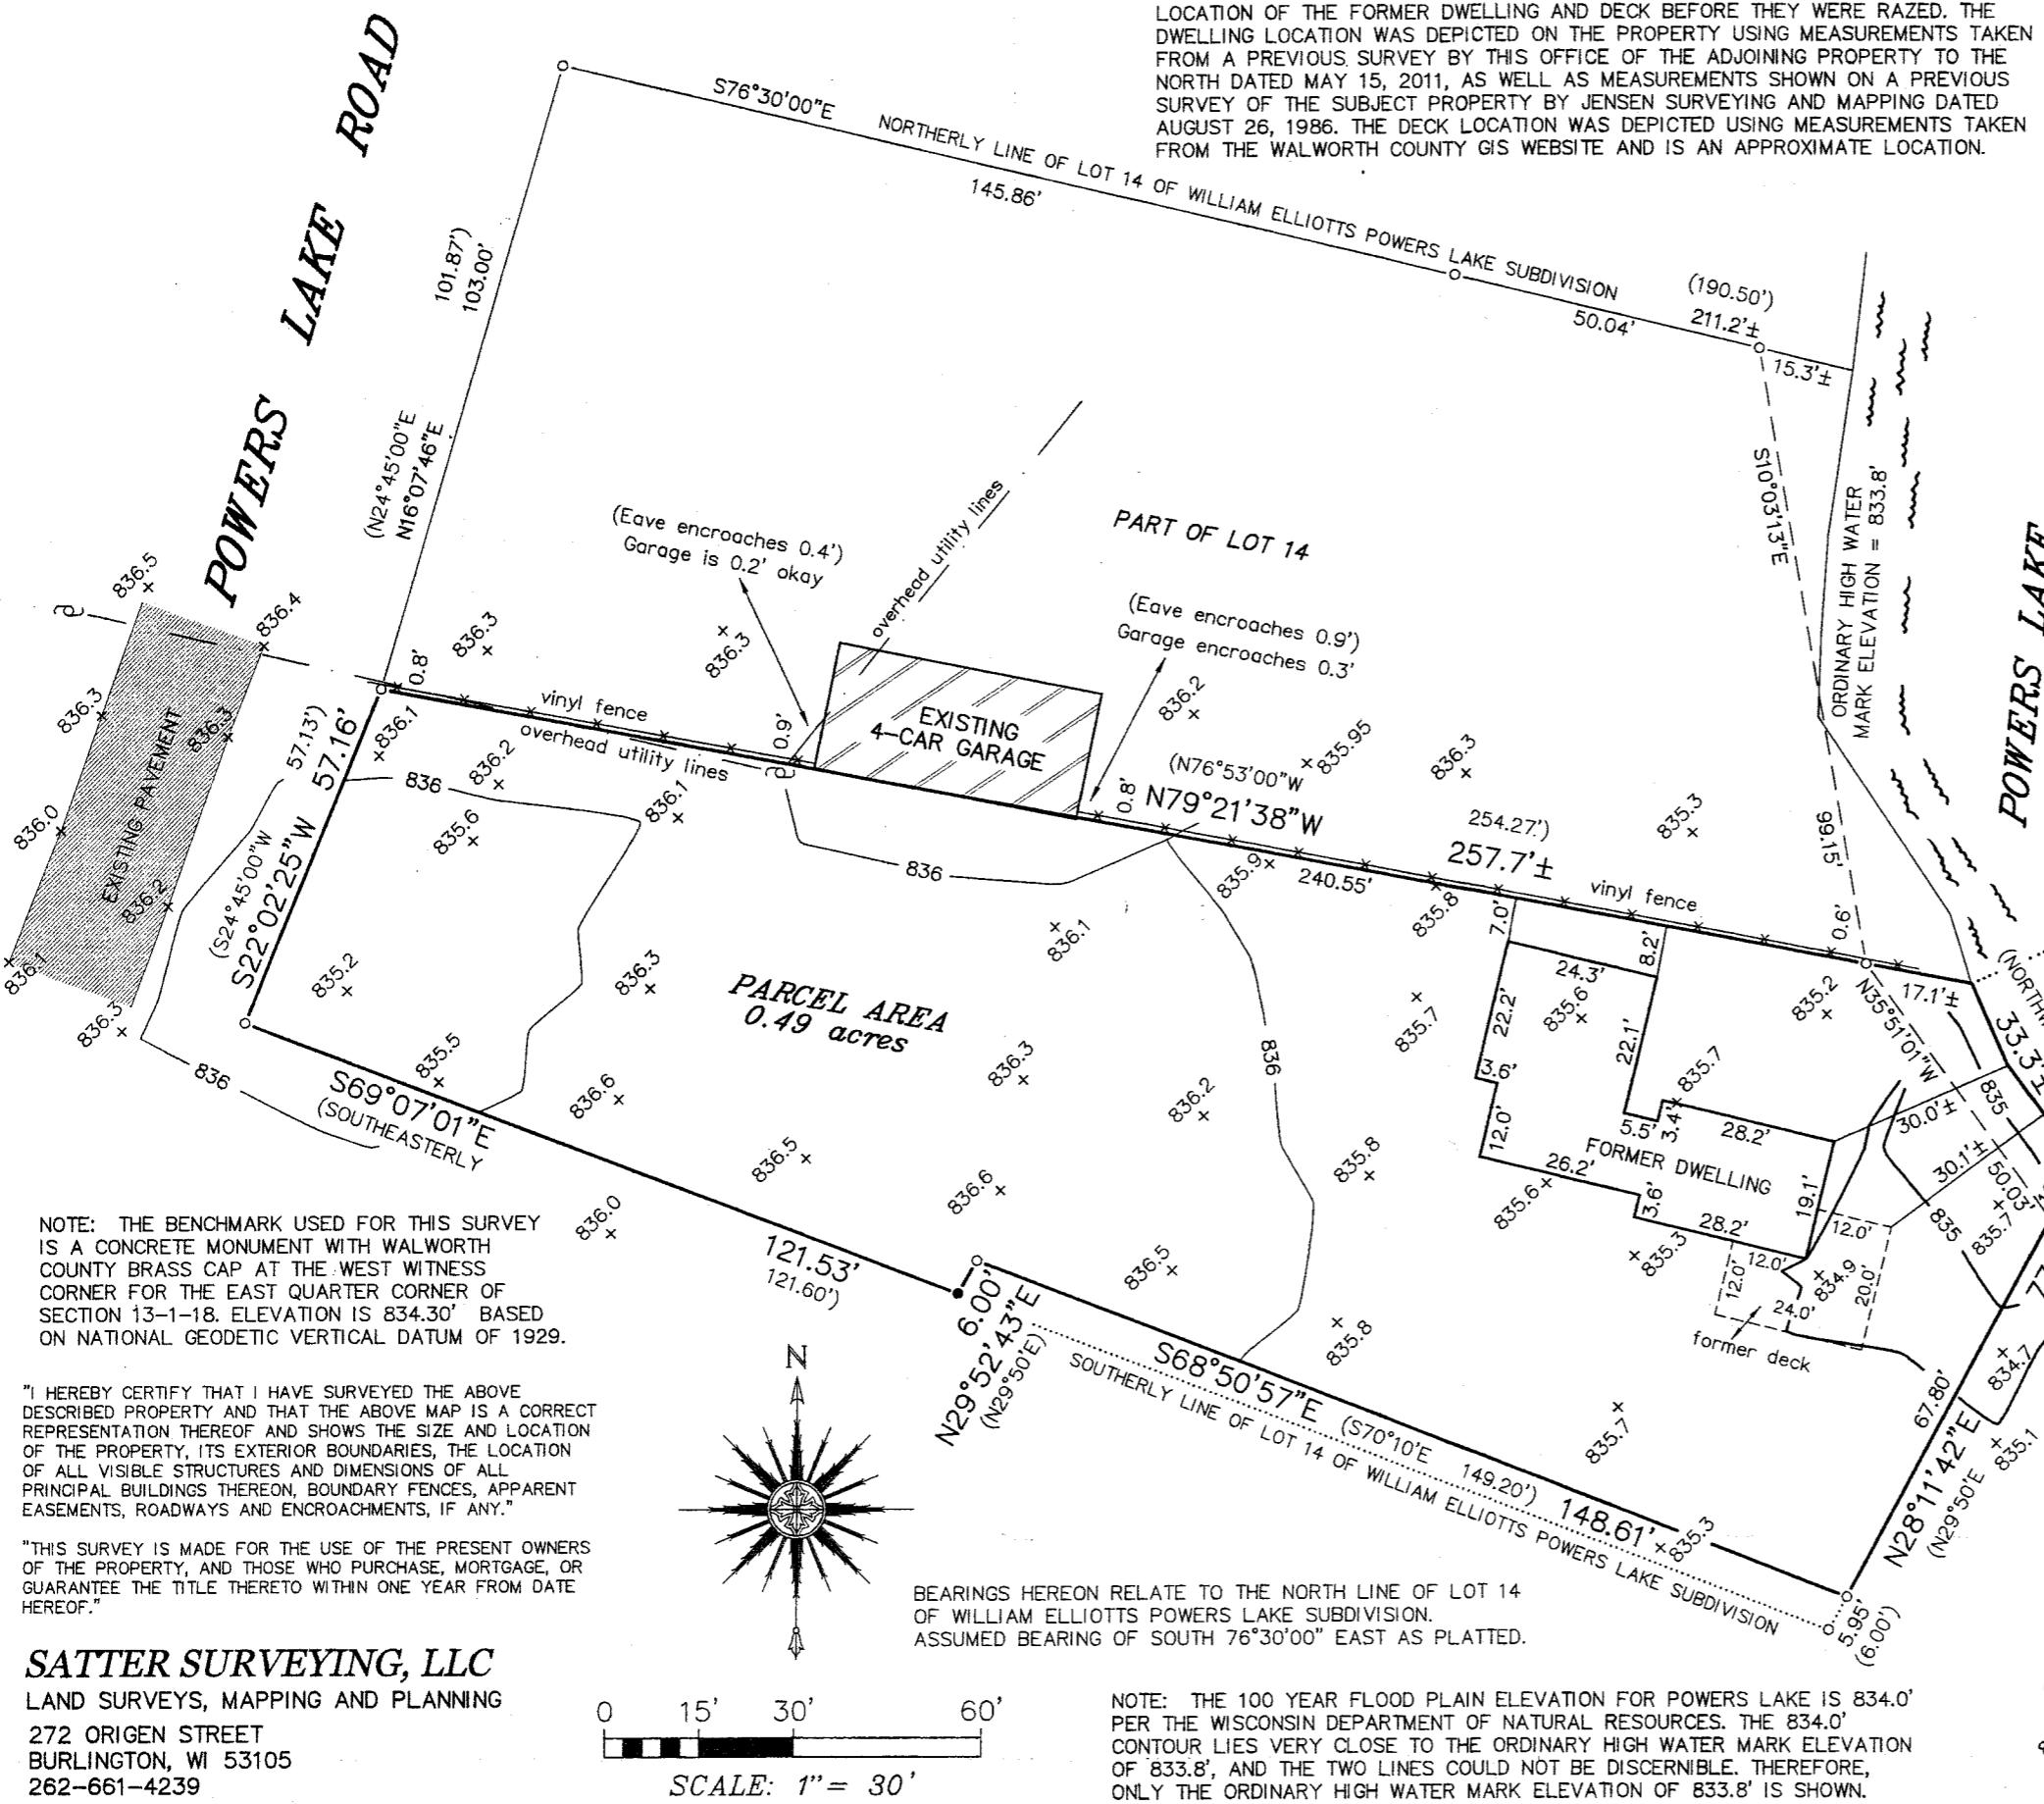

THIS IS NOT AN ORIGINAL PRINT  
UNLESS THIS SEAL IS RED.

*Thomas L. Satter*  
THOMAS L. SATTER  
S-2850  
revised: 10/11/14  
AUGUST 12, 2014  
DATE  
071416  
JOB NUMBER