




HAROLD H. KOLB
REGISTERED PROFESSIONAL LAND SURVEYOR
LAKE GENEVA, WISCONSIN

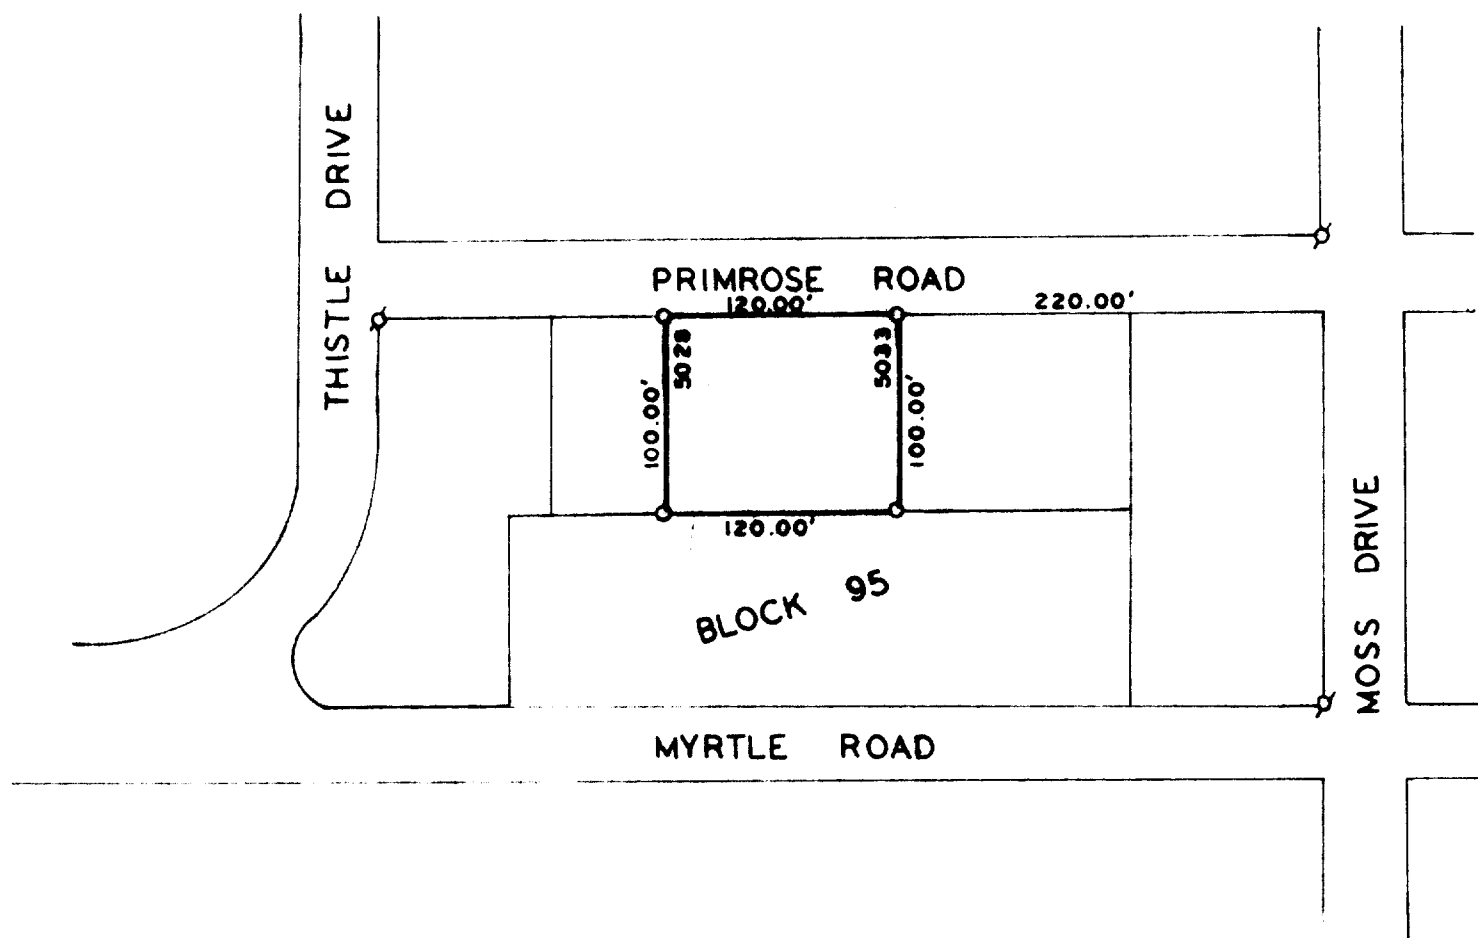

PLAT OF SURVEY OF
Lots 5028-5033, Block 95, Pell Lake Subdivision, T 1 N,
R 18 E, Walworth County, Wisconsin.

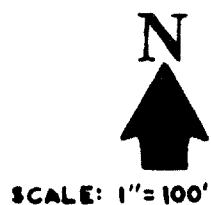

- LEGEND**
- -- IRON PIPE FOUND
 - -- IRON PIPE PLACED
 - -- CONCRETE MONUMENT
 - x -- SPIKE

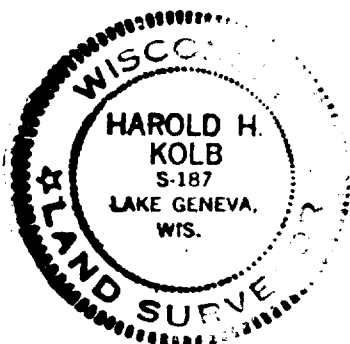

I, HAROLD H. KOLB, DO HEREBY CERTIFY THAT I HAVE
SURVEYED THE PROPERTY HEREON DESCRIBED ACCORDING
TO THE OFFICIAL RECORDS, AND THAT THE PLAT HEREON
IS A CORRECT REPRESENTATION OF THE LOT LINES.

Harold H. Kolb
HAROLD H. KOLB
WISCONSIN REGISTERED LAND SURVEYOR, S-187
DATE JULY 7, 1971

118-323