

LAND SURVEYING

2th Avenue
nd, WI. 53105-8934
d Professionals in
linois & Wisconsin

PLAT OF SURVEY
OF


Lots 3216 through 3225 and 3238, Block 47 of Section 2 of PELL LAKE SUBDIVISION, said block being located in the Northeast Quarter of Section 21, Town 1 North, Range 18 East of the 4th Principal Meridian, Village of Bloomfield, Walworth County, Wisconsin.

PARCEL IDENTIFICATION NO: &PL 00671

PHONE: 262-537-4874

FAX: 262-537-4221

EMAIL: ambit@tds.net

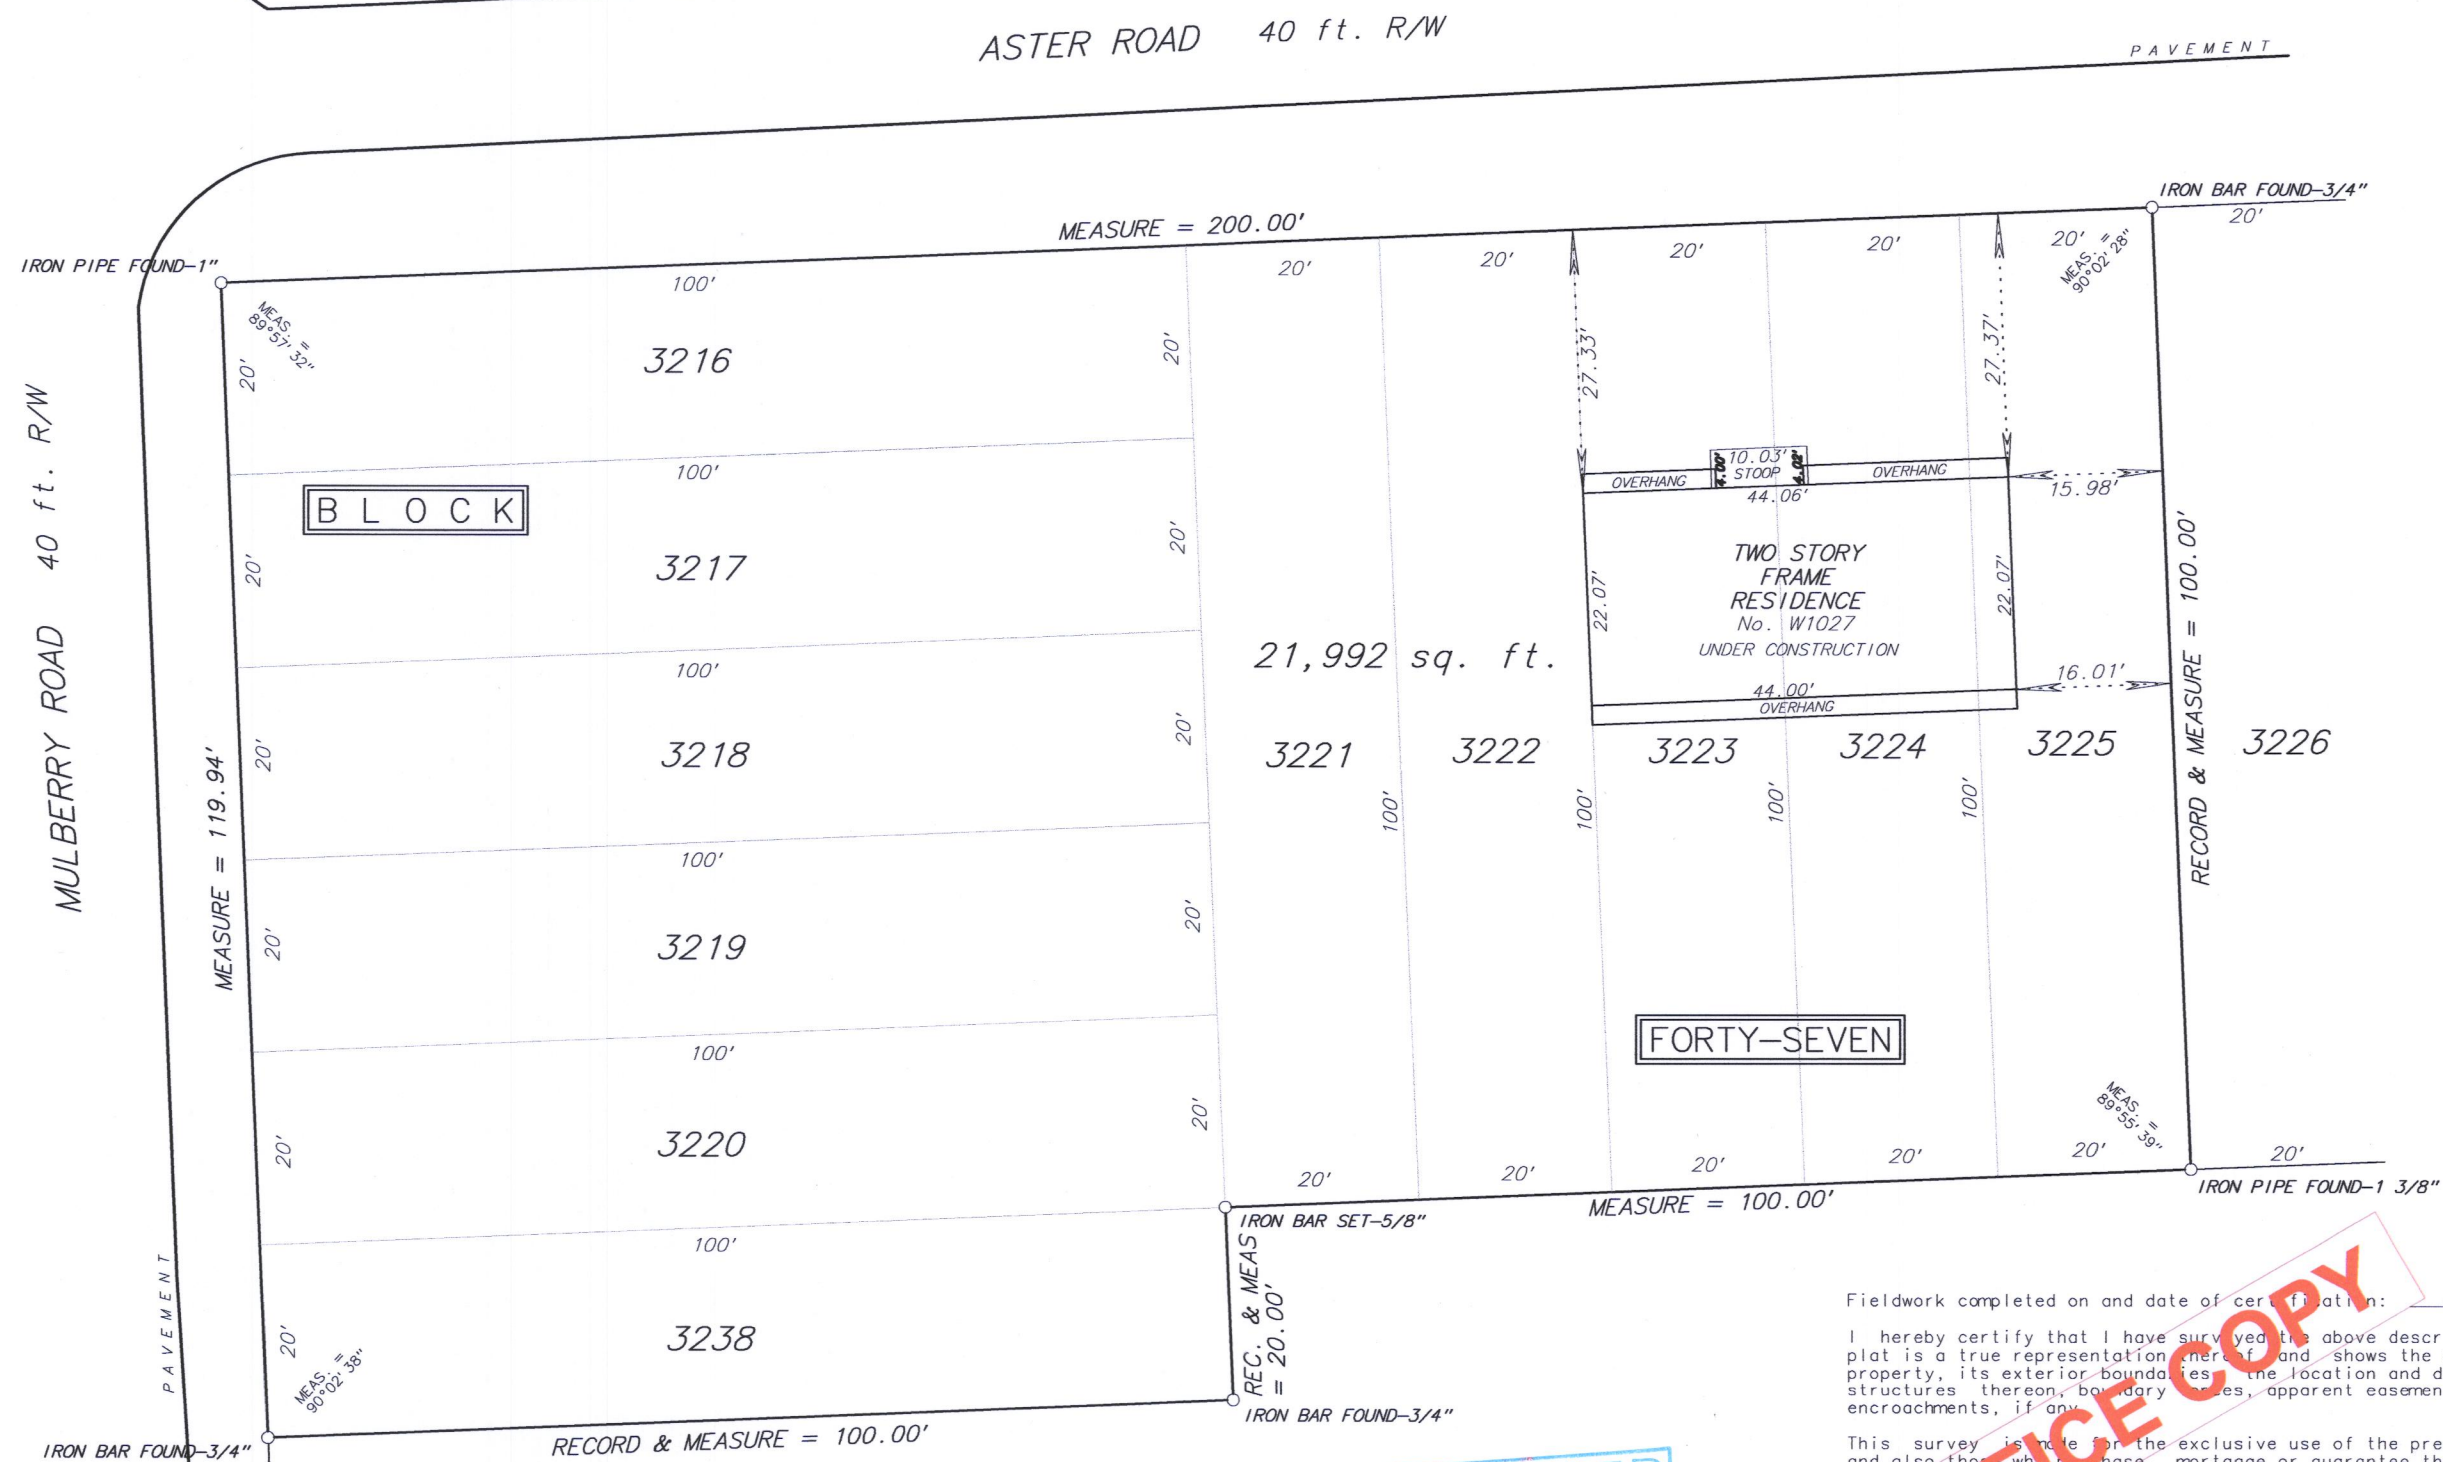

$\overline{PQ}$. $1 \text{ inch} = 20 \text{ feet}$

RED BY: L. Mendoza

NO. : 17069

DL-671

Fieldwork completed on and date of certification: August 3, 2017

I hereby certify that I have surveyed the above described property and the above plat is a true representation thereof and shows the size and location of the property, its exterior boundaries, the location and dimensions of all visible structures thereon, boundary lines, apparent easements and roadways and visible encroachments, if any.

This survey is made for the exclusive use of the present owners of the property and also those who purchase, mortgage or guarantee the title thereto within ONE YEAR from the date hereof.

Date at Cassett, Wisconsin this _____ day of _____ 2017.

Mark A. Bolender
Wisconsin Professional Land Surveyor – 1784

118-3373