


PLAT OF SURVEY
OF

Lots 1121, 1122, 1123 and 1124 in Block 19 of PELL LAKE ADDITION, according to the recorded plat thereof. Said land being in the Village of Bloomfield, County of Walworth, State of Wisconsin.

PARCEL IDENTIFICATION NO. : &PLA 00230A

PAVEMENT

MYRTLE ROAD 40 ft. R/W

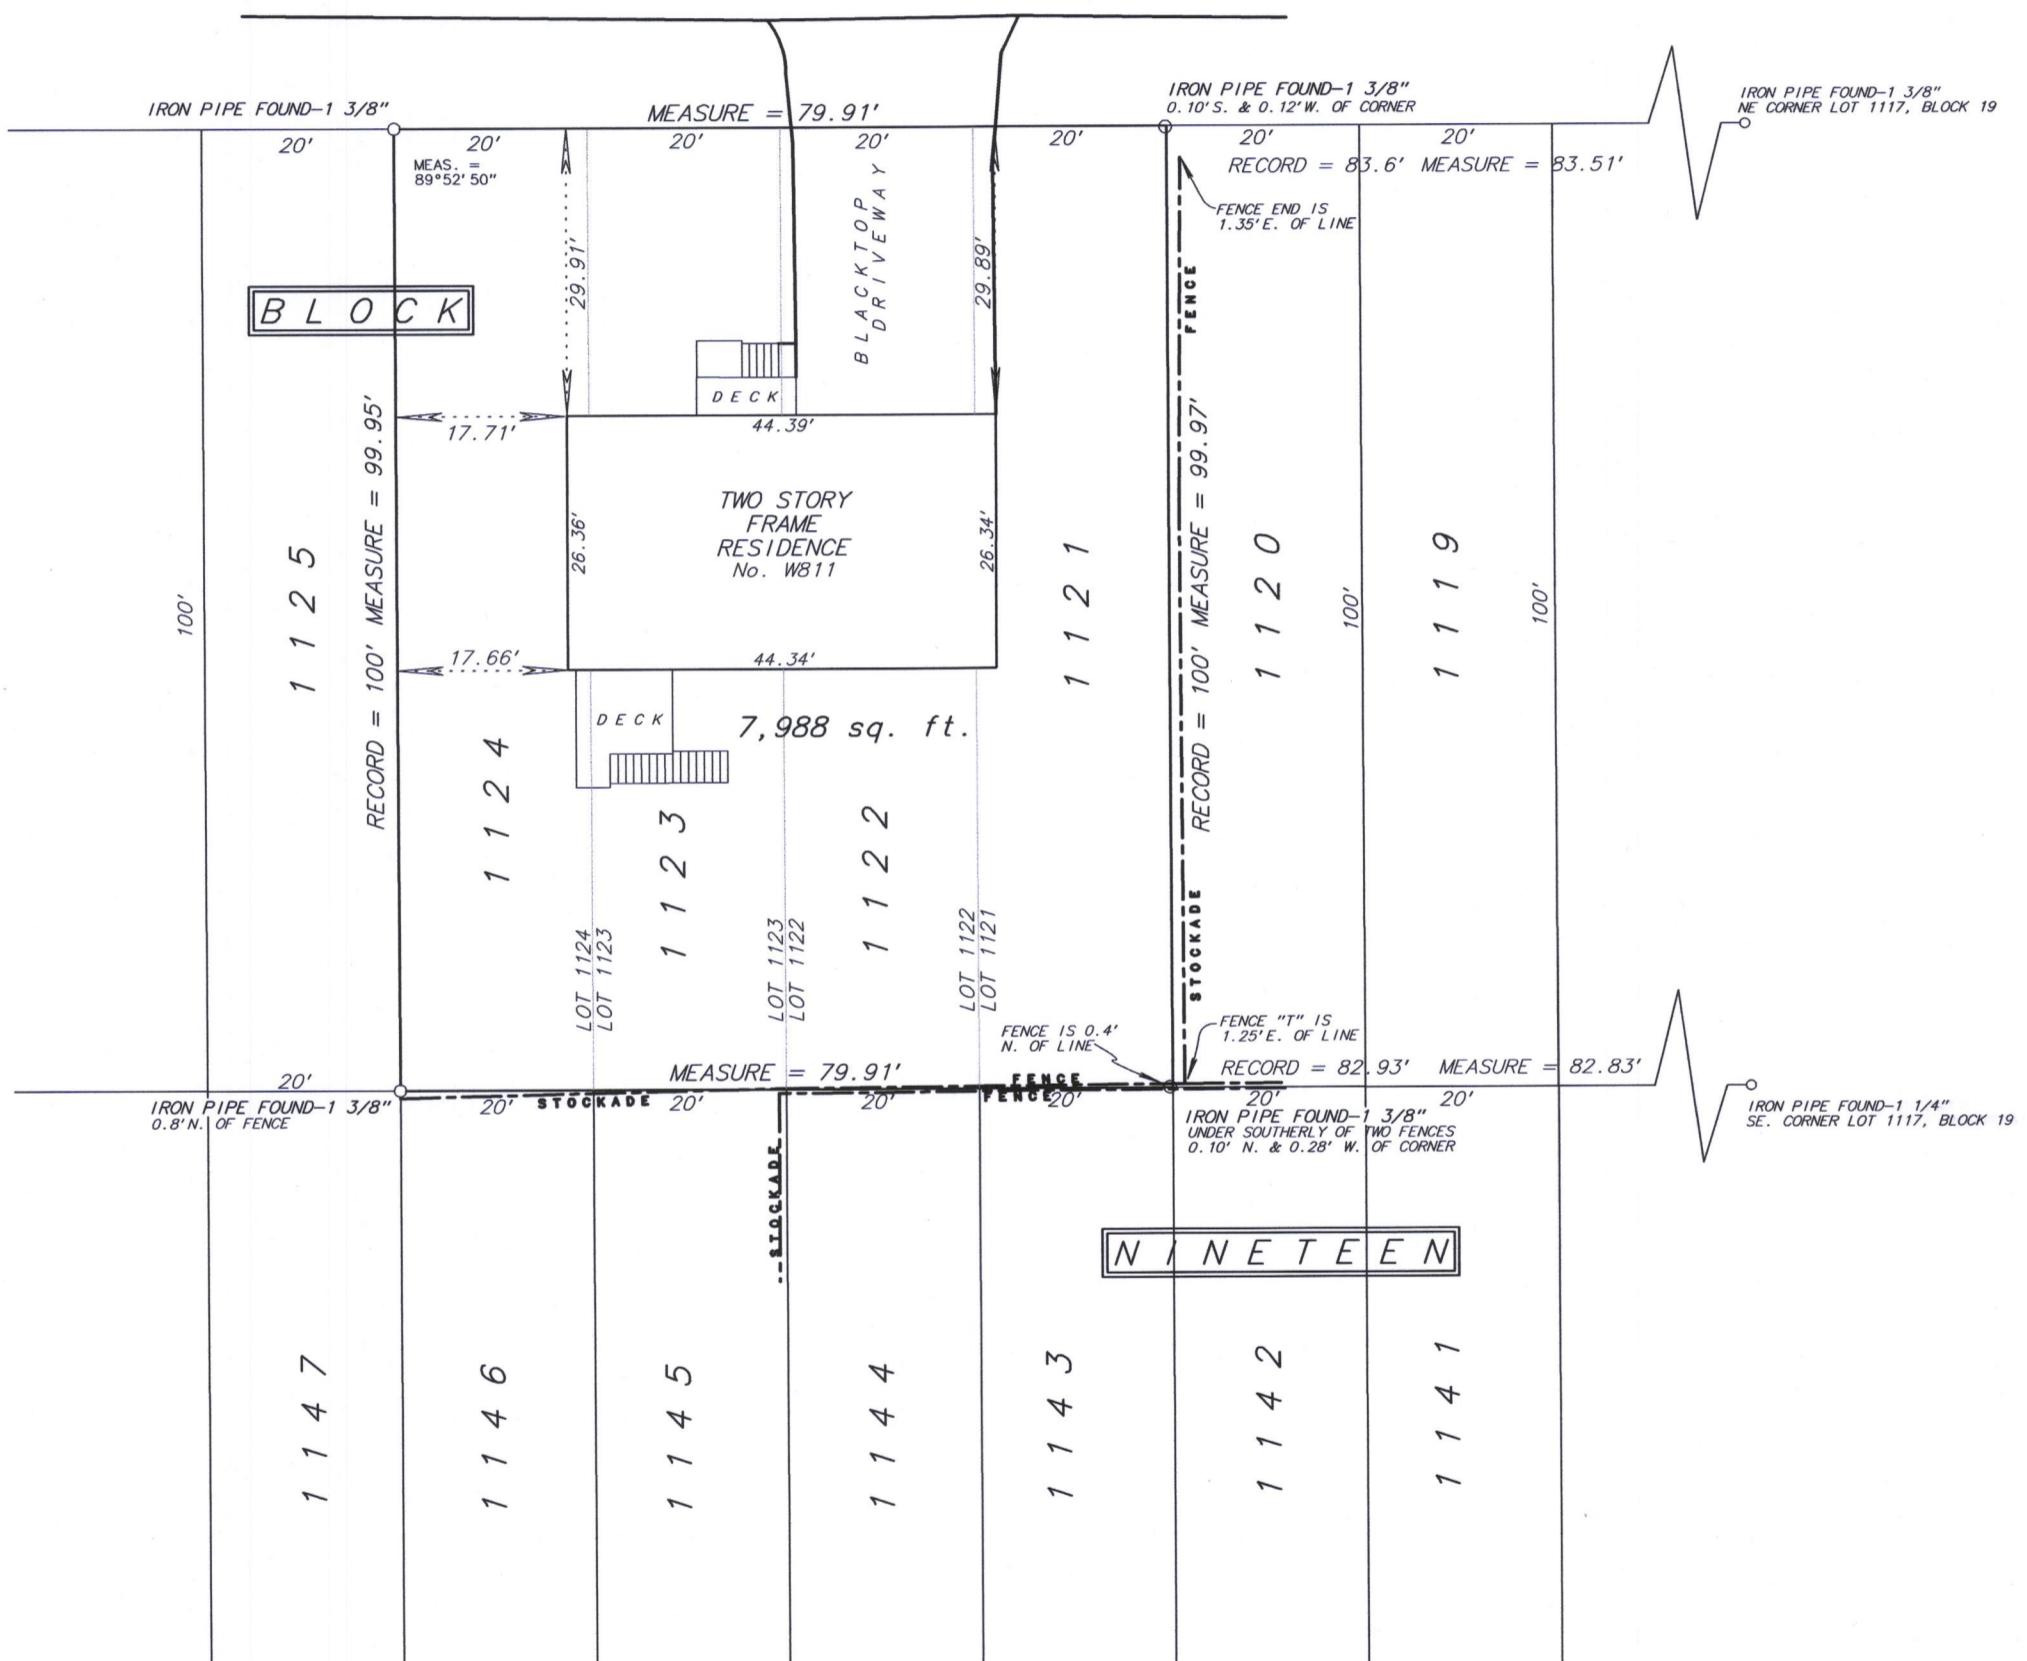

SCALE: 1 inch = 20 feet
ORDERED BY: R. Murin/ Re/Max Advantage
JOB NO : 17265

A rectangular blue stamp with the word "RECEIVED" in large, bold, capital letters. Below the stamp, the date "JUN 27 2018" is printed in red. Handwritten in black ink below the date is "8MF".

Fieldwork completed on and date of certification: December 6, 2017

I hereby certify that I have surveyed the above described property and the above plat is a true representation thereof and shows the size and location of the property, its exterior boundaries, the location and dimensions of all visible structures thereon, boundary fences, appurtenances and roadways and visible encroachments, if any.

This survey is made for the exclusive use of the present owners of the property and also those who purchase, mortgage or guarantee the title thereto within ONE YEAR from the date hereof.

Dated at Bassett, Wisconsin this _____ day of _____ 2017.

Mark A. Bolender
Wisconsin Professional Land Surveyor - 1784

118-3375

6PLA - 230A