


BLOCK 72 OF PELL LAKE SUBDIVISION SECTION 3

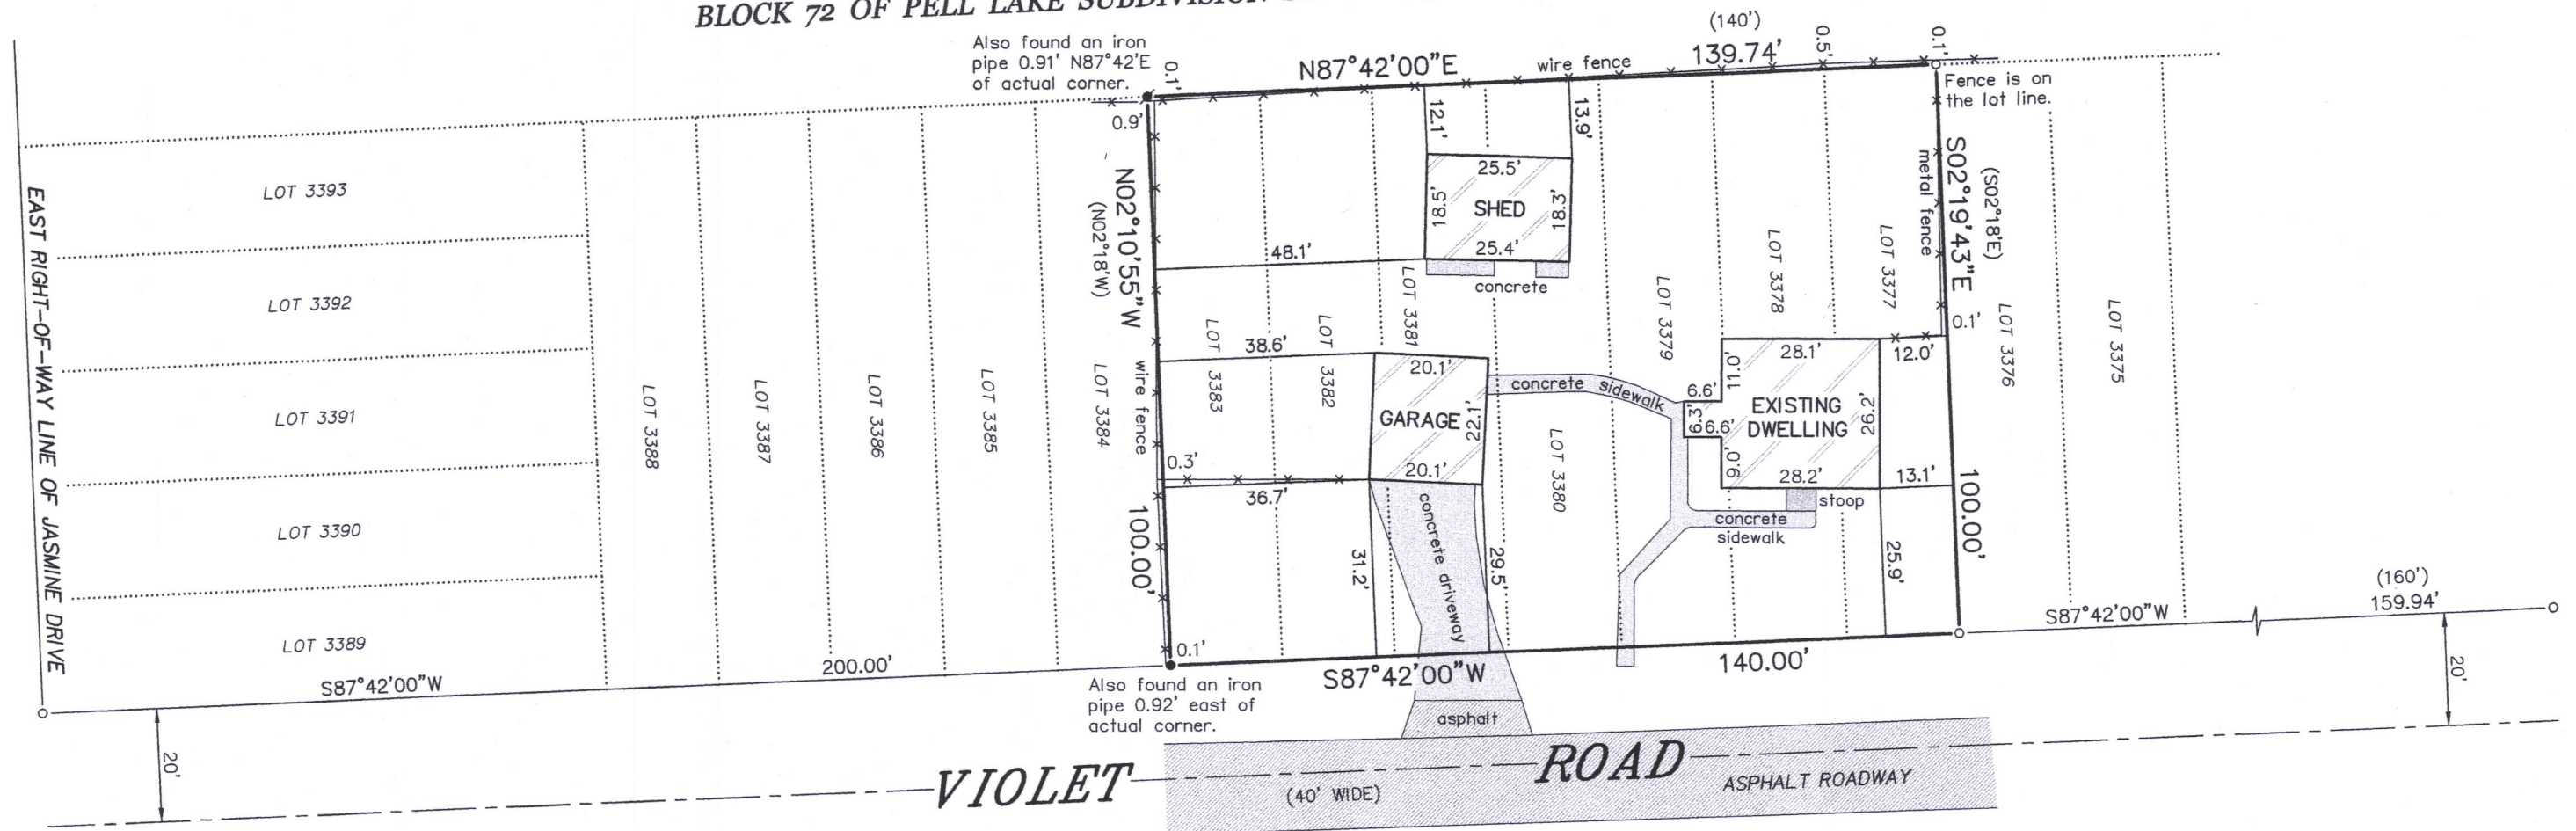

LEGEND

- FOUND IRON PIPE
- ✱ FOUND MASONRY NAIL
- SET MASONRY NAIL
- () RECORDED AS



PLAT OF SURVEY -OF-

LOTS 3377-3383 IN BLOCK 72 OF PELL LAKE SUBDIVISION SECTION 3,
ACCORDING TO THE RECORDED PLAT THEREOF. SAID LAND BEING IN THE
VILLAGE OF BLOOMFIELD, COUNTY OF WALWORTH AND STATE OF WISCONSIN.

SURVEY FOR: KRISTIN STAHLAK OF KEEFE REAL ESTATE
SURVEY ADDRESS: W932 VIOLET ROAD, GENOA CITY, WI 53128

NOTE: REFER TO A CURRENT TITLE REPORT FOR EASEMENTS,
RESTRICTIONS OR COVENANTS WHICH MAY AFFECT THIS PROPERTY.

BEARINGS HEREON RELATE TO THE SOUTH
LINE OF BLOCK 72 OF PELL LAKE
SUBDIVISION SECTION 3. ASSUMED BEARING
OF SOUTH 87°42'00" WEST AS PLATTED.

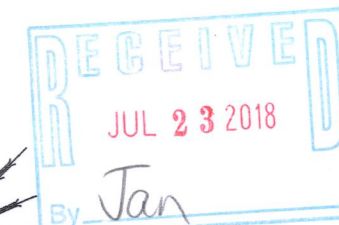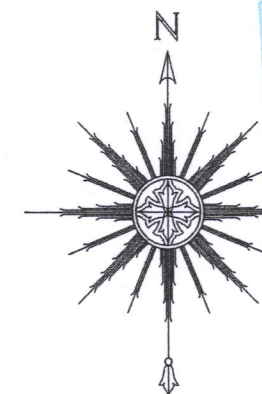

THIS IS NOT AN ORIGINAL PRINT
UNLESS THIS SEAL IS RED.

Thomas L. Satter
THOMAS L. SATTER S-2850

0 15' 30' 60'
SCALE: 1" = 30'

JUNE 23, 2018
DATE

051822
JOB NUMBER

"I HEREBY CERTIFY THAT I HAVE SURVEYED THE ABOVE
DESCRIBED PROPERTY AND THAT THE ABOVE MAP IS A CORRECT
REPRESENTATION THEREOF AND SHOWS THE SIZE AND LOCATION
OF THE PROPERTY, ITS EXTERIOR BOUNDARIES, THE LOCATION
OF ALL VISIBLE STRUCTURES AND DIMENSIONS OF ALL
PRINCIPAL BUILDINGS THEREON, BOUNDARY FENCES, APPARENT
EASEMENTS, ROADWAYS AND ENCROACHMENTS, IF ANY."

"THIS SURVEY IS MADE FOR THE USE OF THE PRESENT OWNERS
OF THE PROPERTY, AND THOSE WHO PURCHASE, MORTGAGE, OR
GUARANTEE THE TITLE THERETO WITHIN ONE YEAR FROM DATE
HEREOF."

SATTER SURVEYING, LLC
LAND SURVEYS, MAPPING AND PLANNING
272 ORIGIN STREET
BURLINGTON, WI 53105
262-661-4239

&PL-702

118-3389