
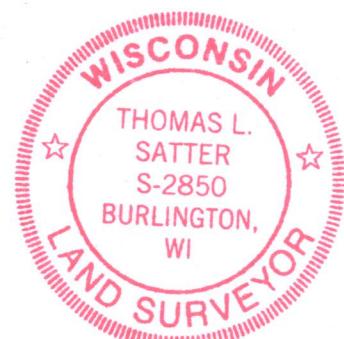


*PLAT OF SURVEY*  
-OF-

PART OF LOT 14 IN WILLIAM ELLIOTTS POWERS LAKE  
SUBDIVISION, LOCATED IN THE NORTHEAST 1/4 OF  
SECTION 13, TOWN 1 NORTH, RANGE 18 EAST, WALWORTH  
COUNTY, WISCONSIN, DESCRIBED AS FOLLOWS, TO-WIT:  
BEGINNING AT THE SOUTHWEST CORNER OF SAID LOT 14;  
THENCE SOUTHEASTERLY ALONG THE SOUTHERLY LINE  
OF SAID LOT 121.60 FEET, WHICH POINT IS THE  
NORTHWEST CORNER OF LOT 17; THENCE NORTH 29°50'  
EAST 6 FEET TO A POINT; THENCE SOUTH 70°10' EAST  
149.20 FEET, MORE OR LESS, TO A PUBLIC ROAD;  
THENCE NORTH 29°50' EAST ALONG SAID ROAD 76.82  
FEET, MORE OR LESS, TO THE SHORE OF POWERS LAKE;  
THENCE NORTHWESTERLY ALONG THE SHORE OF POWERS  
LAKE 36 FEET, MORE OR LESS, TO A POINT; THENCE  
NORTH 76°53' WEST 254.27 FEET TO A PUBLIC ROAD;  
THENCE SOUTH 24°45' WEST 57.13 FEET ALONG SAID  
ROAD TO THE PLACE OF BEGINNING.

SURVEY FOR: DAVID AND NOREEN RAMINSKI  
SURVEY ADDRESS: N1576 POWERS LAKE ROAD

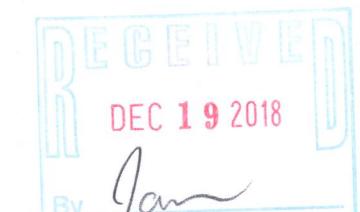

THIS IS NOT AN ORIGINAL PRINT  
UNLESS THIS SEAL IS READ

Thomas L. Satter

THOMAS L. SATTER

S-2850


NOVEMBER 15, 2018  
DATE

071416-d2

"I HEREBY CERTIFY THAT I HAVE SURVEYED THE ABOVE DESCRIBED PROPERTY AND THAT THE ABOVE MAP IS A CORRECT REPRESENTATION THEREOF AND SHOWS THE SIZE AND LOCATION OF THE PROPERTY, ITS EXTERIOR BOUNDARIES, THE LOCATION OF ALL VISIBLE STRUCTURES AND DIMENSIONS OF ALL PRINCIPAL BUILDINGS THEREON, BOUNDARY FENCES, APPARENT EASEMENTS, ROADWAYS, AND ENCROACHMENTS, IF ANY."

"THIS SURVEY IS MADE FOR THE USE OF THE PRESENT OWNERS OF THE PROPERTY, AND THOSE WHO PURCHASE, MORTGAGE, OR GUARANTEE THE TITLE THERETO WITHIN ONE YEAR FROM DATE HEREOF".

**SATTER SURVEYING, LLC**  
LAND SURVEYS, MAPPING AND PLANNING  
272 ORIGEN STREET  
BURLINGTON, WI 53105  
262-661-4239

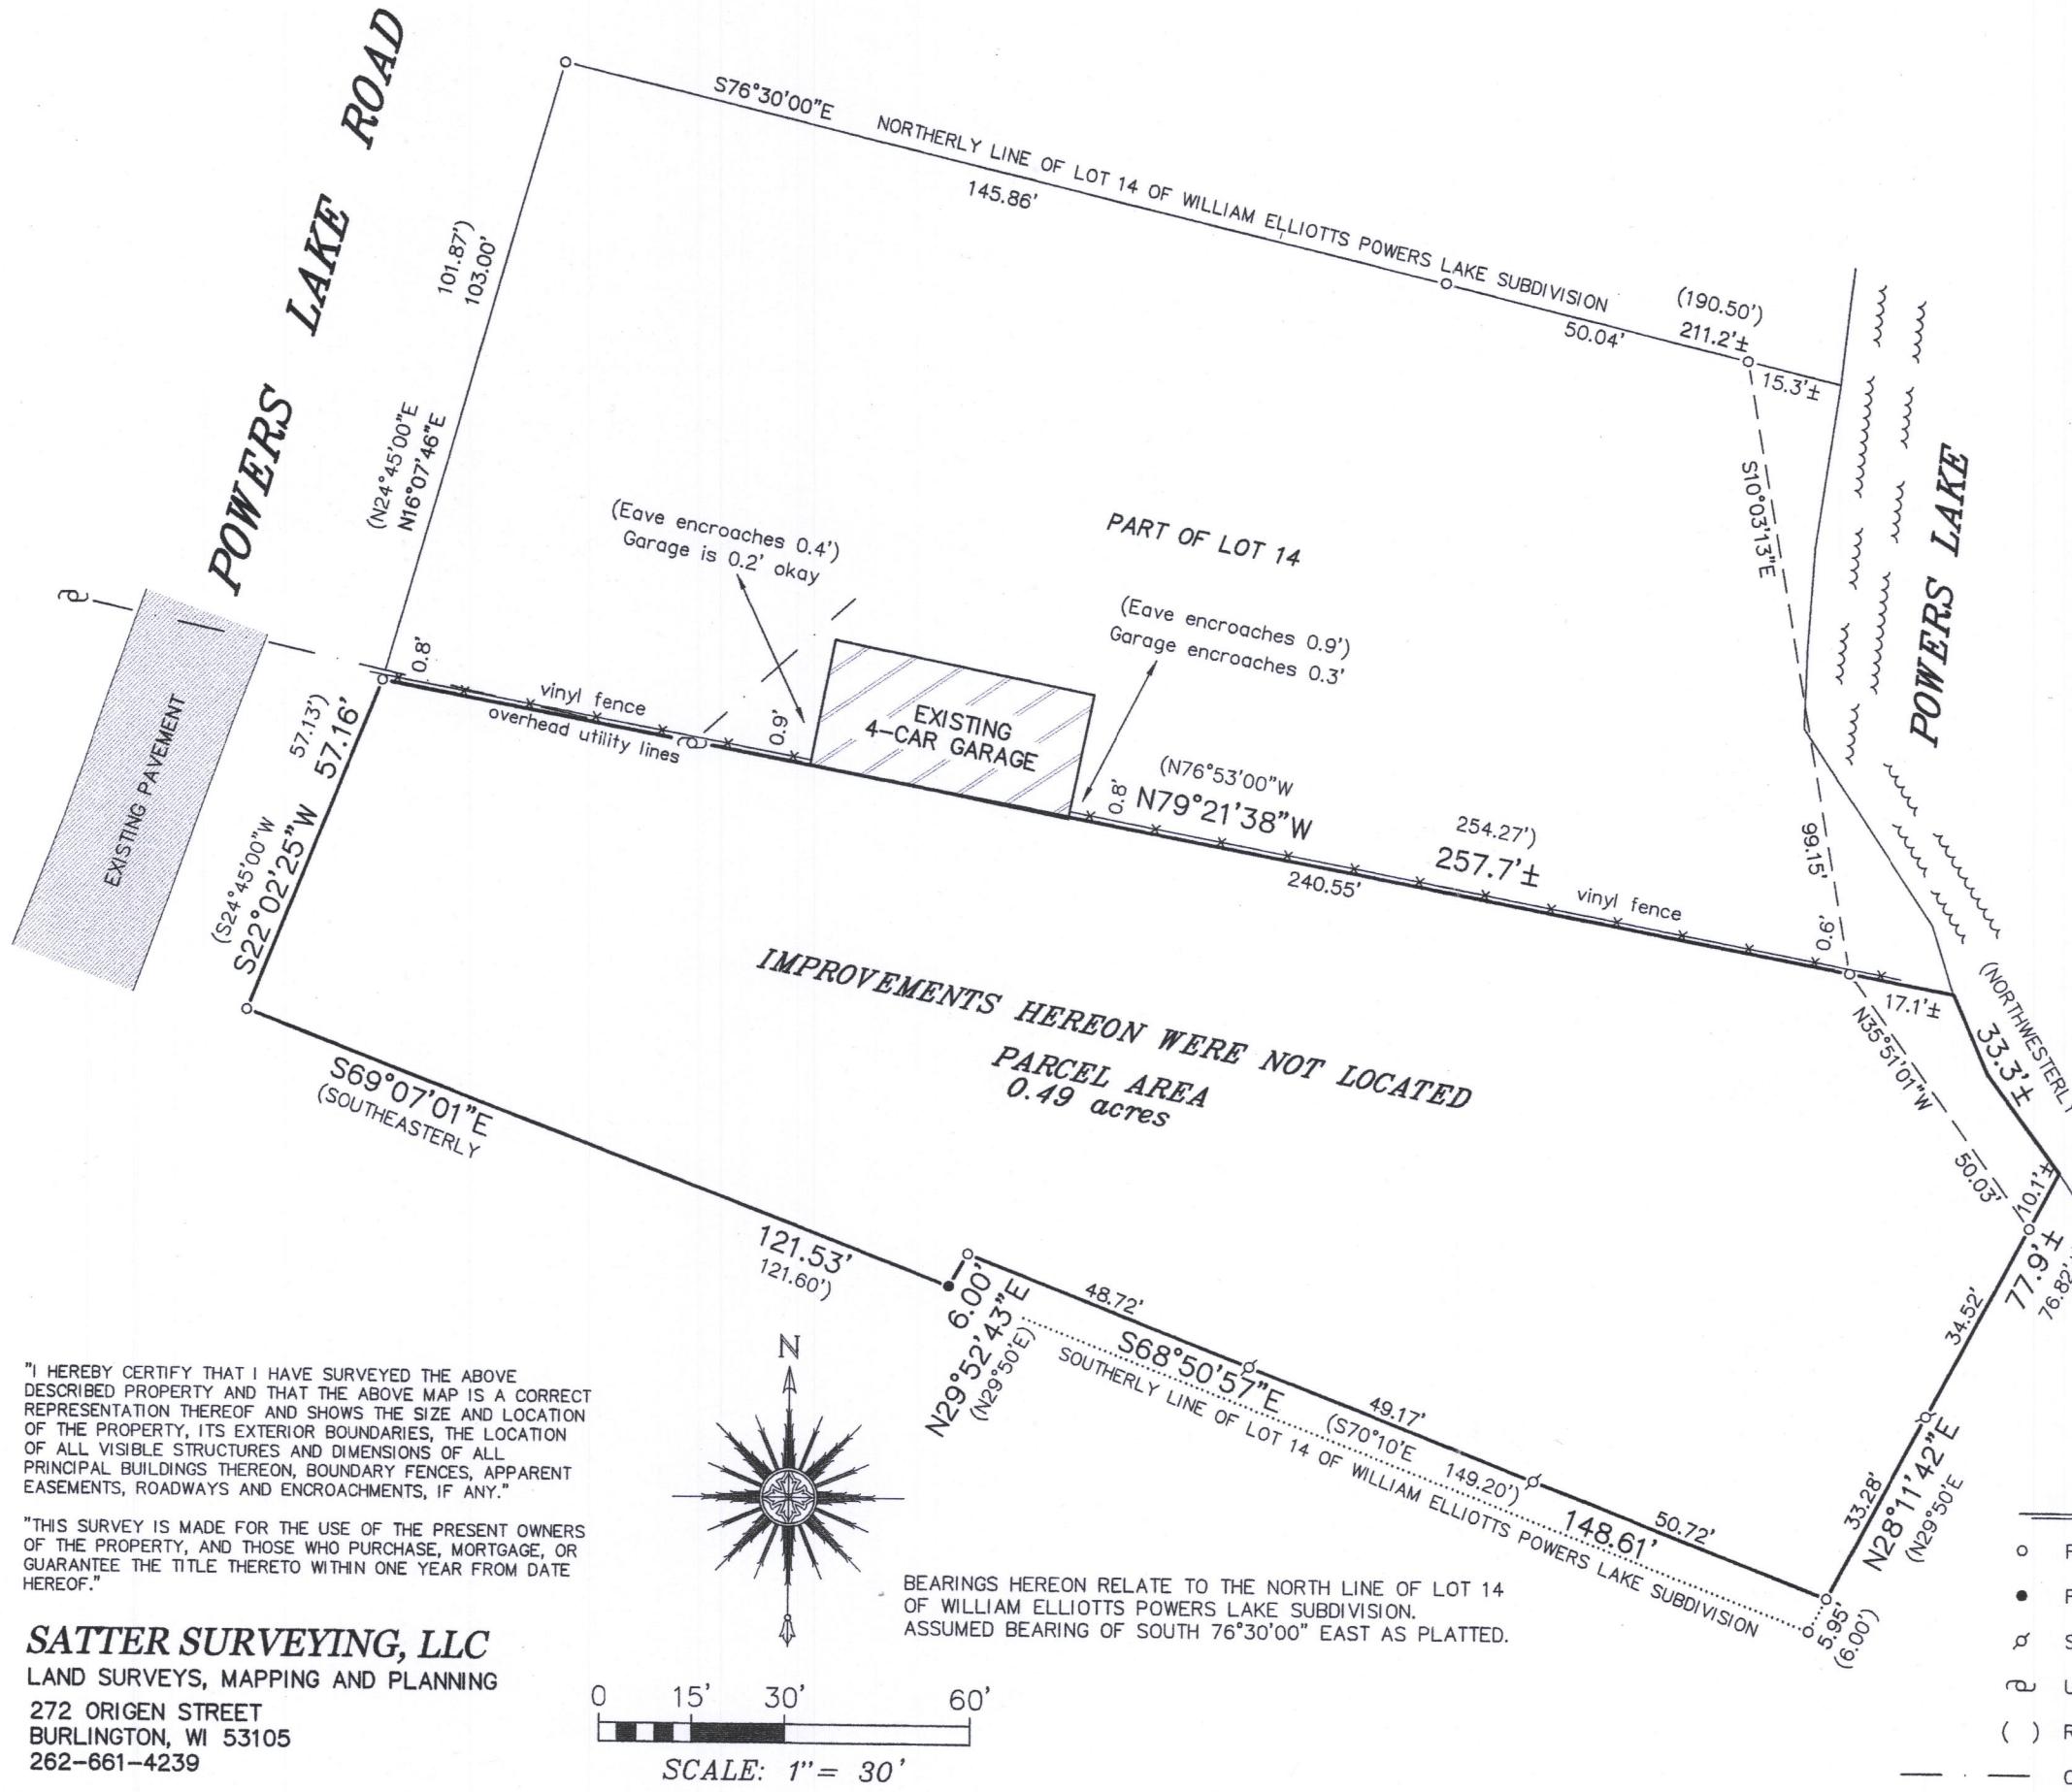

BEARINGS HEREON RELATE TO THE NORTH LINE OF LOT 14  
OF WILLIAM ELLIOTT'S POWERS LAKE SUBDIVISION.  
ASSUMED BEARING OF SOUTH 76°30'00" EAST AS PLATTED

SCALE: 1' = 30'

---

**LEGEND**

---

- FOUND IRON PIPE
- FOUND NAIL IN TRE
- ☒ SET IRON PIPE
- ☒ UTILITY POLE
- ( ) RECORDED AS

---

- OVERHEAD UTILITY

DE-14A 118-3414