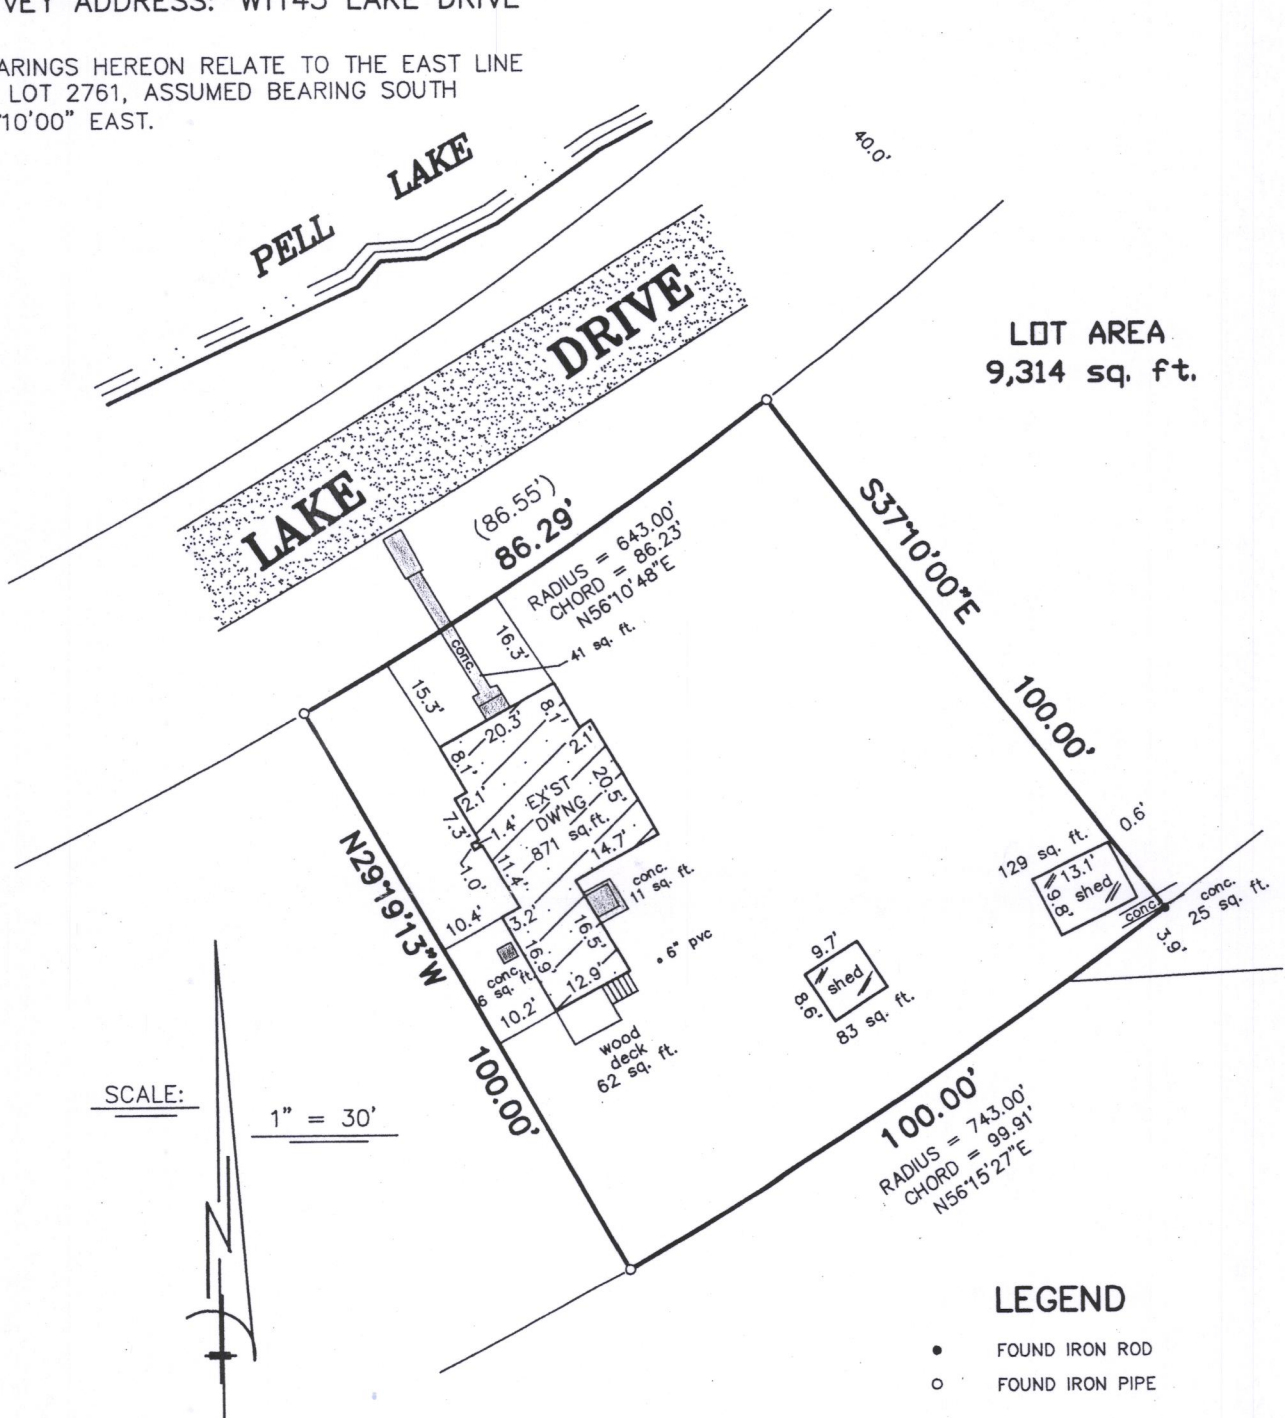


PLAT OF SURVEY
-OF-

SURVEY FOR: BOWER DESIGN AND CONSTRUCTION
SURVEY ADDRESS: W1143 LAKE DRIVE

BEARINGS HEREON RELATE TO THE EAST LINE
OF LOT 2761, ASSUMED BEARING SOUTH
37°10'00" EAST.


$$1'' = 30'$$

"I hereby certify that I have surveyed the above described property and that the above map is a correct representation thereof and shows the size and location of the property, its exterior boundaries, the location of all visible structures and dimensions of all principal buildings thereon, boundary fences, apparent easements, roadways and encroachments, if any."

"This survey is made for the use of the present owners of the property, and those who purchase, mortgage, or guarantee the title thereto within one year from date hereof."

- FOUND IRON ROD
- FOUND IRON PIPE

B.W. SURVEYING, INC.

412 N. PINE STREET
BURLINGTON, WI 53105
(262)-767-0225

THIS IS NOT AN ORIGINAL PRINT
UNLESS THIS SEAL IS RED.

ROBERT J. WETZEL S-

MAY 8, 2019
DATE

9847
JOB NUMBER



118-3443