
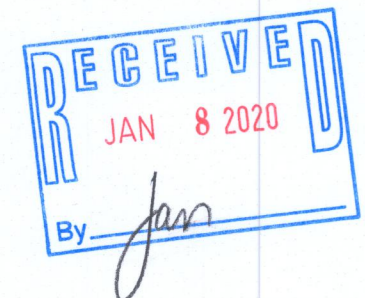
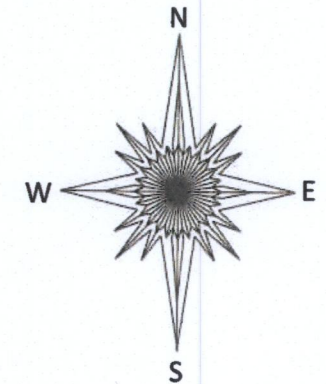


PREPARED FOR
ROBERT ERICKSON

PLAT OF SURVEY

Lots 1174 thru 1184 and 1202 thru 1218 in Block 7 of Pell Lake
Highlands Subdivision, being in the Southeast 1/4 of Section 6,
Township 1 North, Range 18 East of the Fourth Principal Meridian, in
the Village of Genoa City, Walworth County, Wisconsin.

PATHFINDER SURVEYING
(a NMB Company)
1458 HORIZON BLVD. STE. 200
RACINE, WI. 53406
WWW.PATHFINDERSURVEYING.NET
262-248-8303

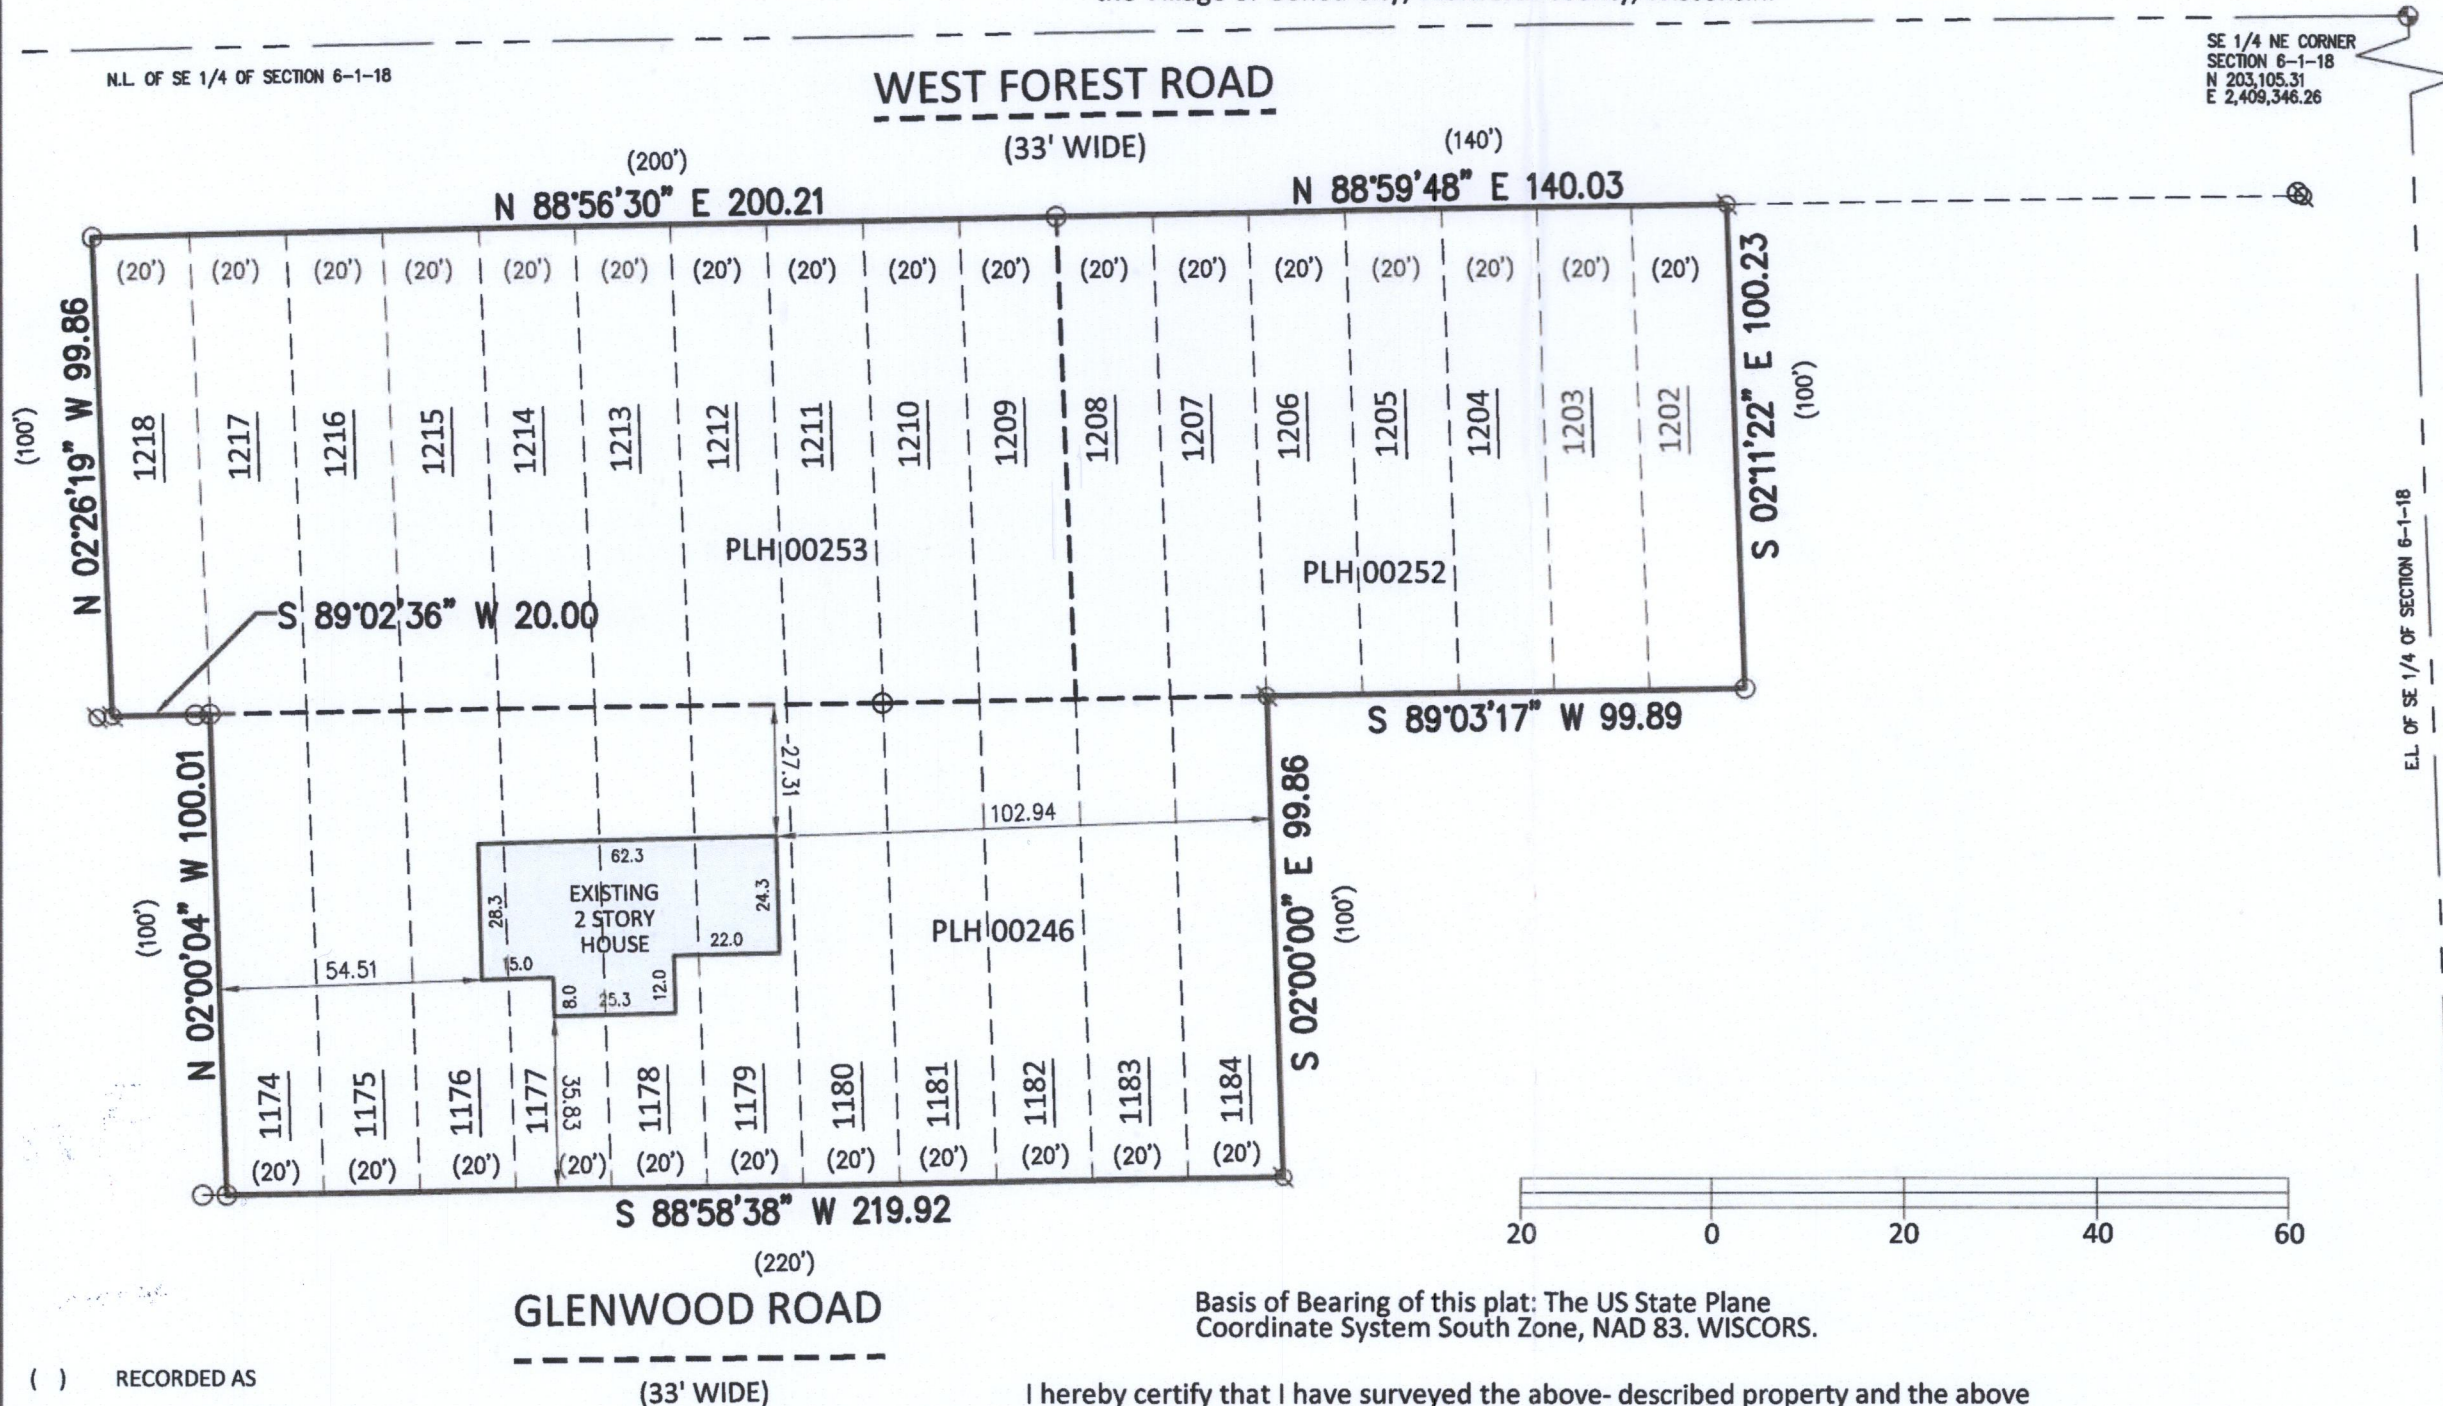

- () RECORDED AS
- FOUND IRON PIPE
- ⊗ FOUND REBAR

SCALE 1" = 40'

JOB # 2019.0269.01

TAX ID # PLH 00246 / PLH 00252 / PLH 00253

I hereby certify that I have surveyed the above- described property and the above
map is a true representation thereof and shows the size and location of the
property, its exterior boundaries, the location and dimensions of all structures
thereon, fences, apparent easements and roadways and visible encroachments if any
to the best of my knowledge and belief.

This survey is made for the present owners of the property, and those who purchase,
mortgage, or guarantee the title thereto, within one year from the date hereof.

Dated this 31st day of December, 2019.



Mark R. Madsen
MARK R. MADSEN S - 2271
Wisconsin Professional Land Surveyor

PLH-246 PLH-252 PLH-253 118-3465

11:48:53 AM

Tuesday, December 31, 2019