




Vanderstappen  
Land Surveying, Inc.

www.vandersinc.com  
1316 N. Madison St.  
Woodstock, Illinois 60098  
ph. 815-337-8310 fax 815-337-8314  
"Always faithful to the property line"


# PLAT OF SURVEY

Lots 9, 10, 11, 12, 13, 14, 15 and 16 in Shinner's 7th Addition to Nippersink Park, being a Subdivision located in the Southeast Quarter of Section 24, Township 01 North, Range 18 East of the Fourth Principal Meridian, Township of Bloomfield, County of Walworth, Wisconsin.

LAKE TOMBEAU

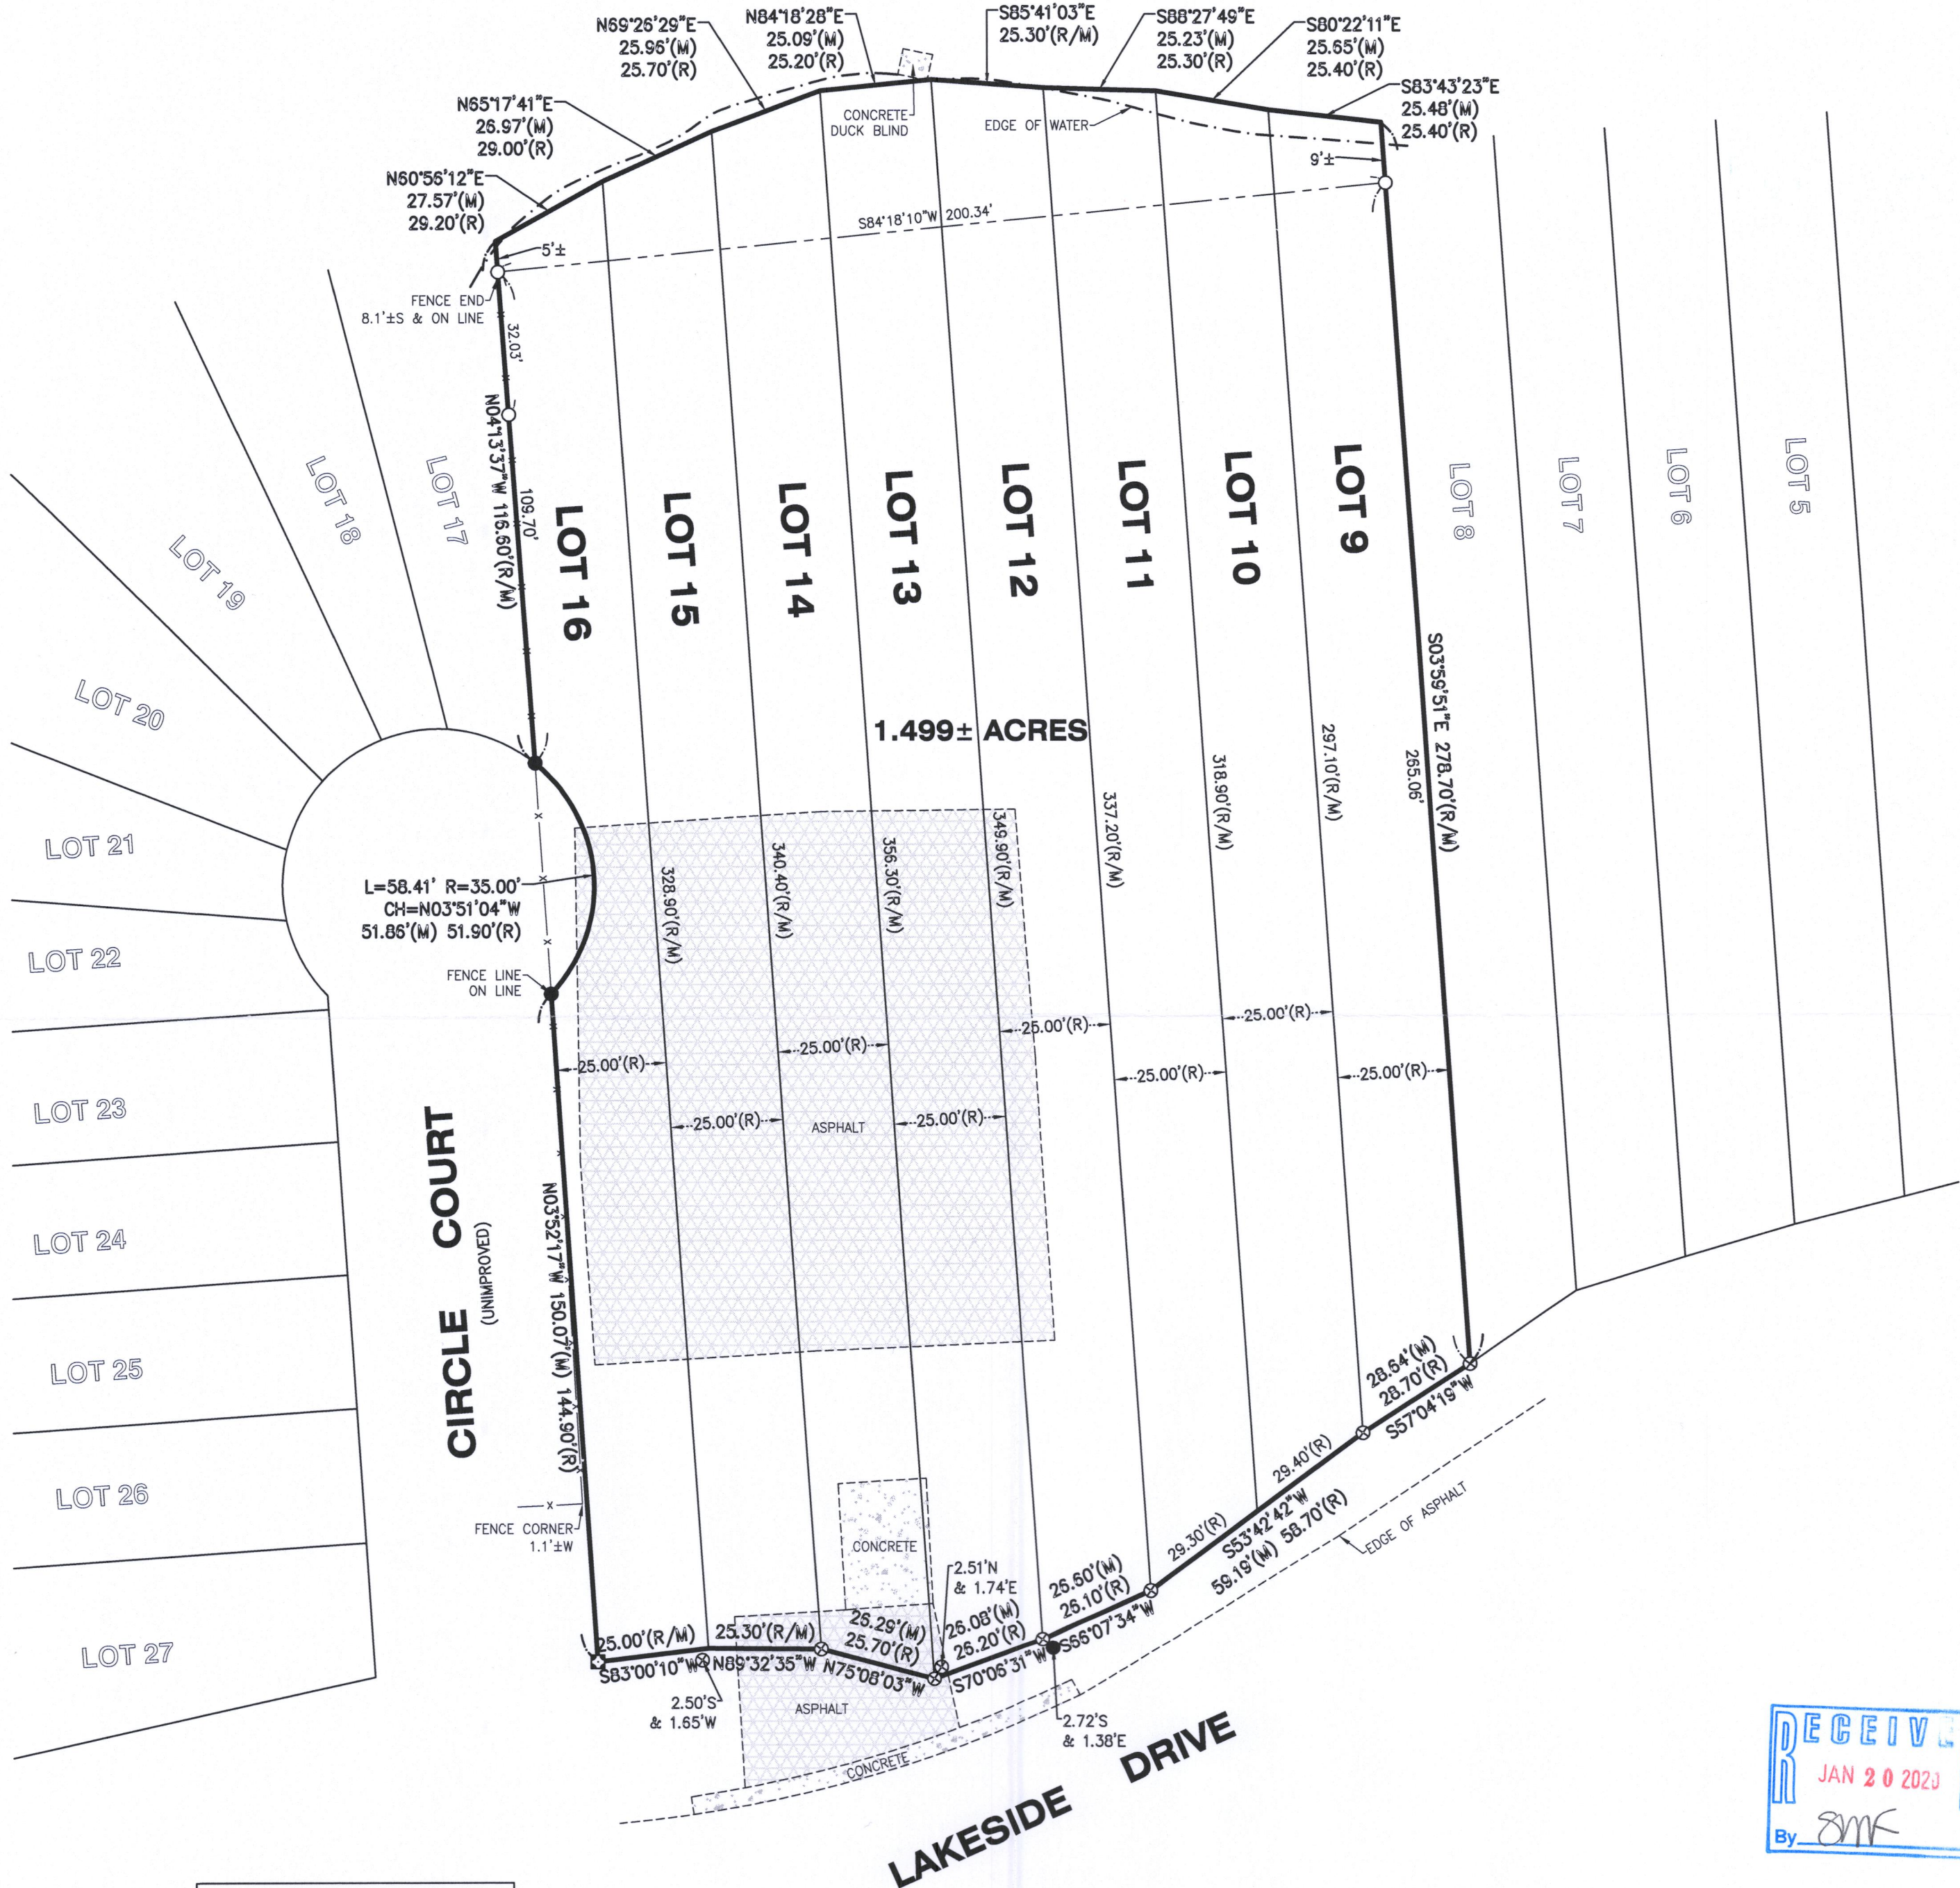

| LEGEND |                  |
|--------|------------------|
| ●      | FOUND IRON BAR   |
| ○      | FOUND IRON PIPE  |
| ⊗      | FOUND MAG NAIL   |
| ⊠      | FOUND ROW MARKER |
| (M)    | MEASURED         |
| (R)    | RECORD           |

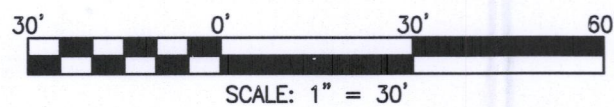

NOTE: Only those Building Line Restrictions or Easements shown on a Recorded Subdivision Plat are shown hereon unless the description ordered to be surveyed contains a proper description of the required building lines or easements.

- No distance should be assumed by scaling.
- No underground improvements have been located unless shown and noted.
- No representation as to ownership, use, or possession should be hereon implied.
- This Survey and Plat of Survey are void without original embossed or colored seal and signature affixed.

Compare your description and site markings with this plat and AT ONCE report any discrepancies which you may find.

STATE OF ILLINOIS )  
COUNTY OF McHENRY ) S.S.

In my professional opinion, and based on my observations, I hereby certify that the above described property has been surveyed under my direction and that the above map is a true representation thereof and shows the size and location of all visible structures, and dimensions of all principle buildings thereon, boundary fences, apparent easements, roadways, and visible encroachments, if any. This survey is made for the use of the present owners of the property, and also those who purchase, mortgage, or guarantee the title thereto within one year from the date hereof.

Dated at Woodstock, McHenry County, Illinois 7/29 A.D., 20 19.

Vanderstappen Land Surveying, Inc.  
Design Firm No. 184-002792

By: \_\_\_\_\_  
Wisconsin Registered Land Surveyor No. S1777

CLIENT: DENNIS & CHRIS HOLIAN  
DRAWN BY: DAM CHECKED BY: WJV  
SCALE: 1"=20' SEC. 24 T. 01 R. 15 E.  
BASIS OF BEARING: ASSUMED  
P.I.N.: &NPS 700066  
JOB NO.: 190527 I.D. LSV  
FIELDWORK COMP.: 7/26/19 BK. PG.  
ALL DISTANCES SHOWN IN FEET AND DECIMAL PARTS THEREOF CORRECTED TO 68° F.

