


**REGISTERED PROFESSIONAL LAND SURVEYOR
LAKE GENEVA, WISCONSIN**




Box 377-177, Block 16, P.O. Box
Islands Subdivision, 4110
Main St. Court, Wickenburg.

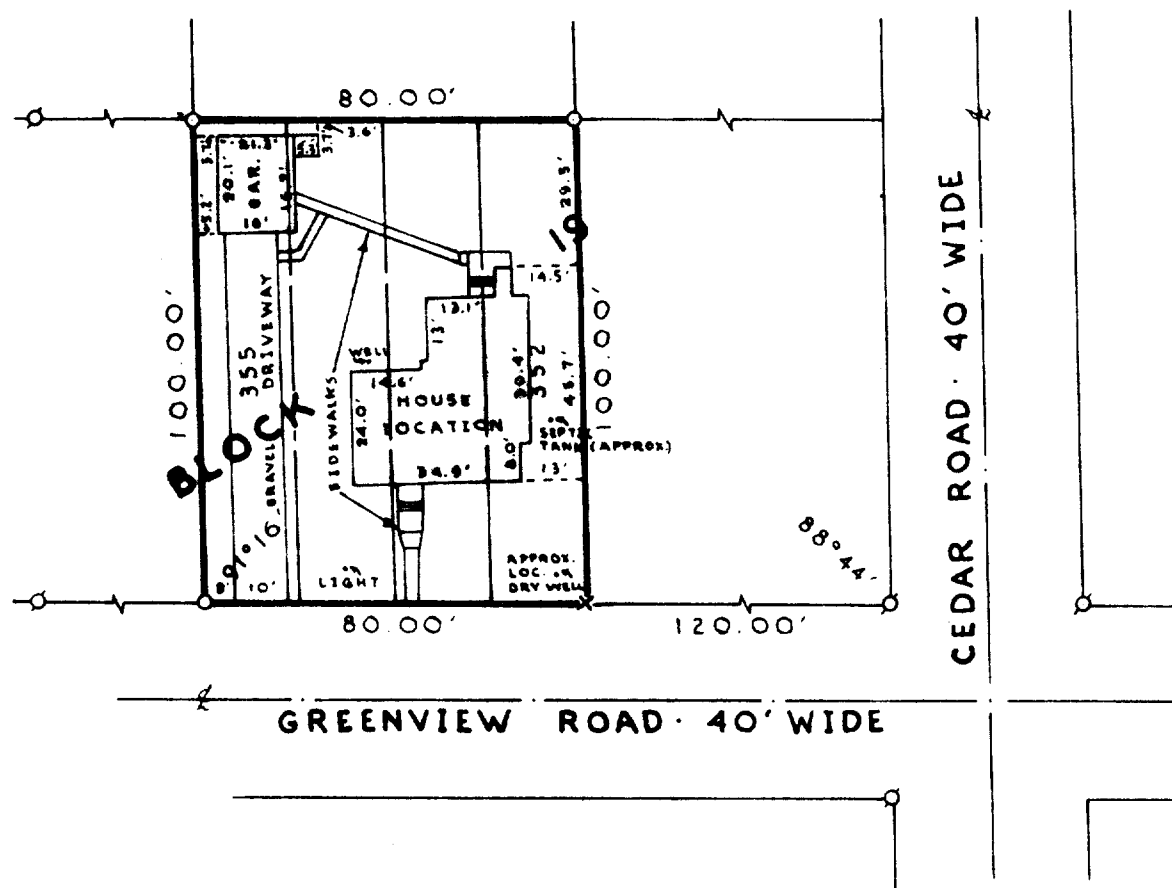

LEGEND

- φ — IRON PIPE FOUND
 ○ — IRON PIPE PLACED
 ● — CONCRETE MONUMENT
 x — CROSS CUT IN ROCK

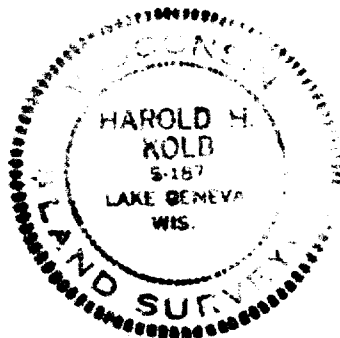

I, HAROLD H. KOLB, DO HEREBY CERTIFY THAT I HAVE SURVEYED THE PROPERTY HEREON DESCRIBED ACCORDING TO THE OFFICIAL RECORDS. AND THAT THE PLAT HEREON IS A CORRECT REPRESENTATION OF THE LOT LINES, AND ALL VISIBLE IMPROVEMENTS.

Harold H. Kolt
HAROLD H. KOLT
WISCONSIN REGISTERED LAND SURVEYOR, S-187
DATE Feb. 1972

118-~~229~~³⁴⁷