


PLAT OF SURVEY

LOCATION: W195 Lake Street, Genoa City, Wisconsin

LEGAL DESCRIPTION: Lot 12 in WM. ELLIOT'S POWERS LAKE SUBDIVISION, located in part of the Southeast 1/4 of the Northeast 1/4 of Section 13, Town 1 North, Range 18 East, in the Village of Bloomfield, Walworth County, Wisconsin.

March 9, 2020

Survey No. 110978-B

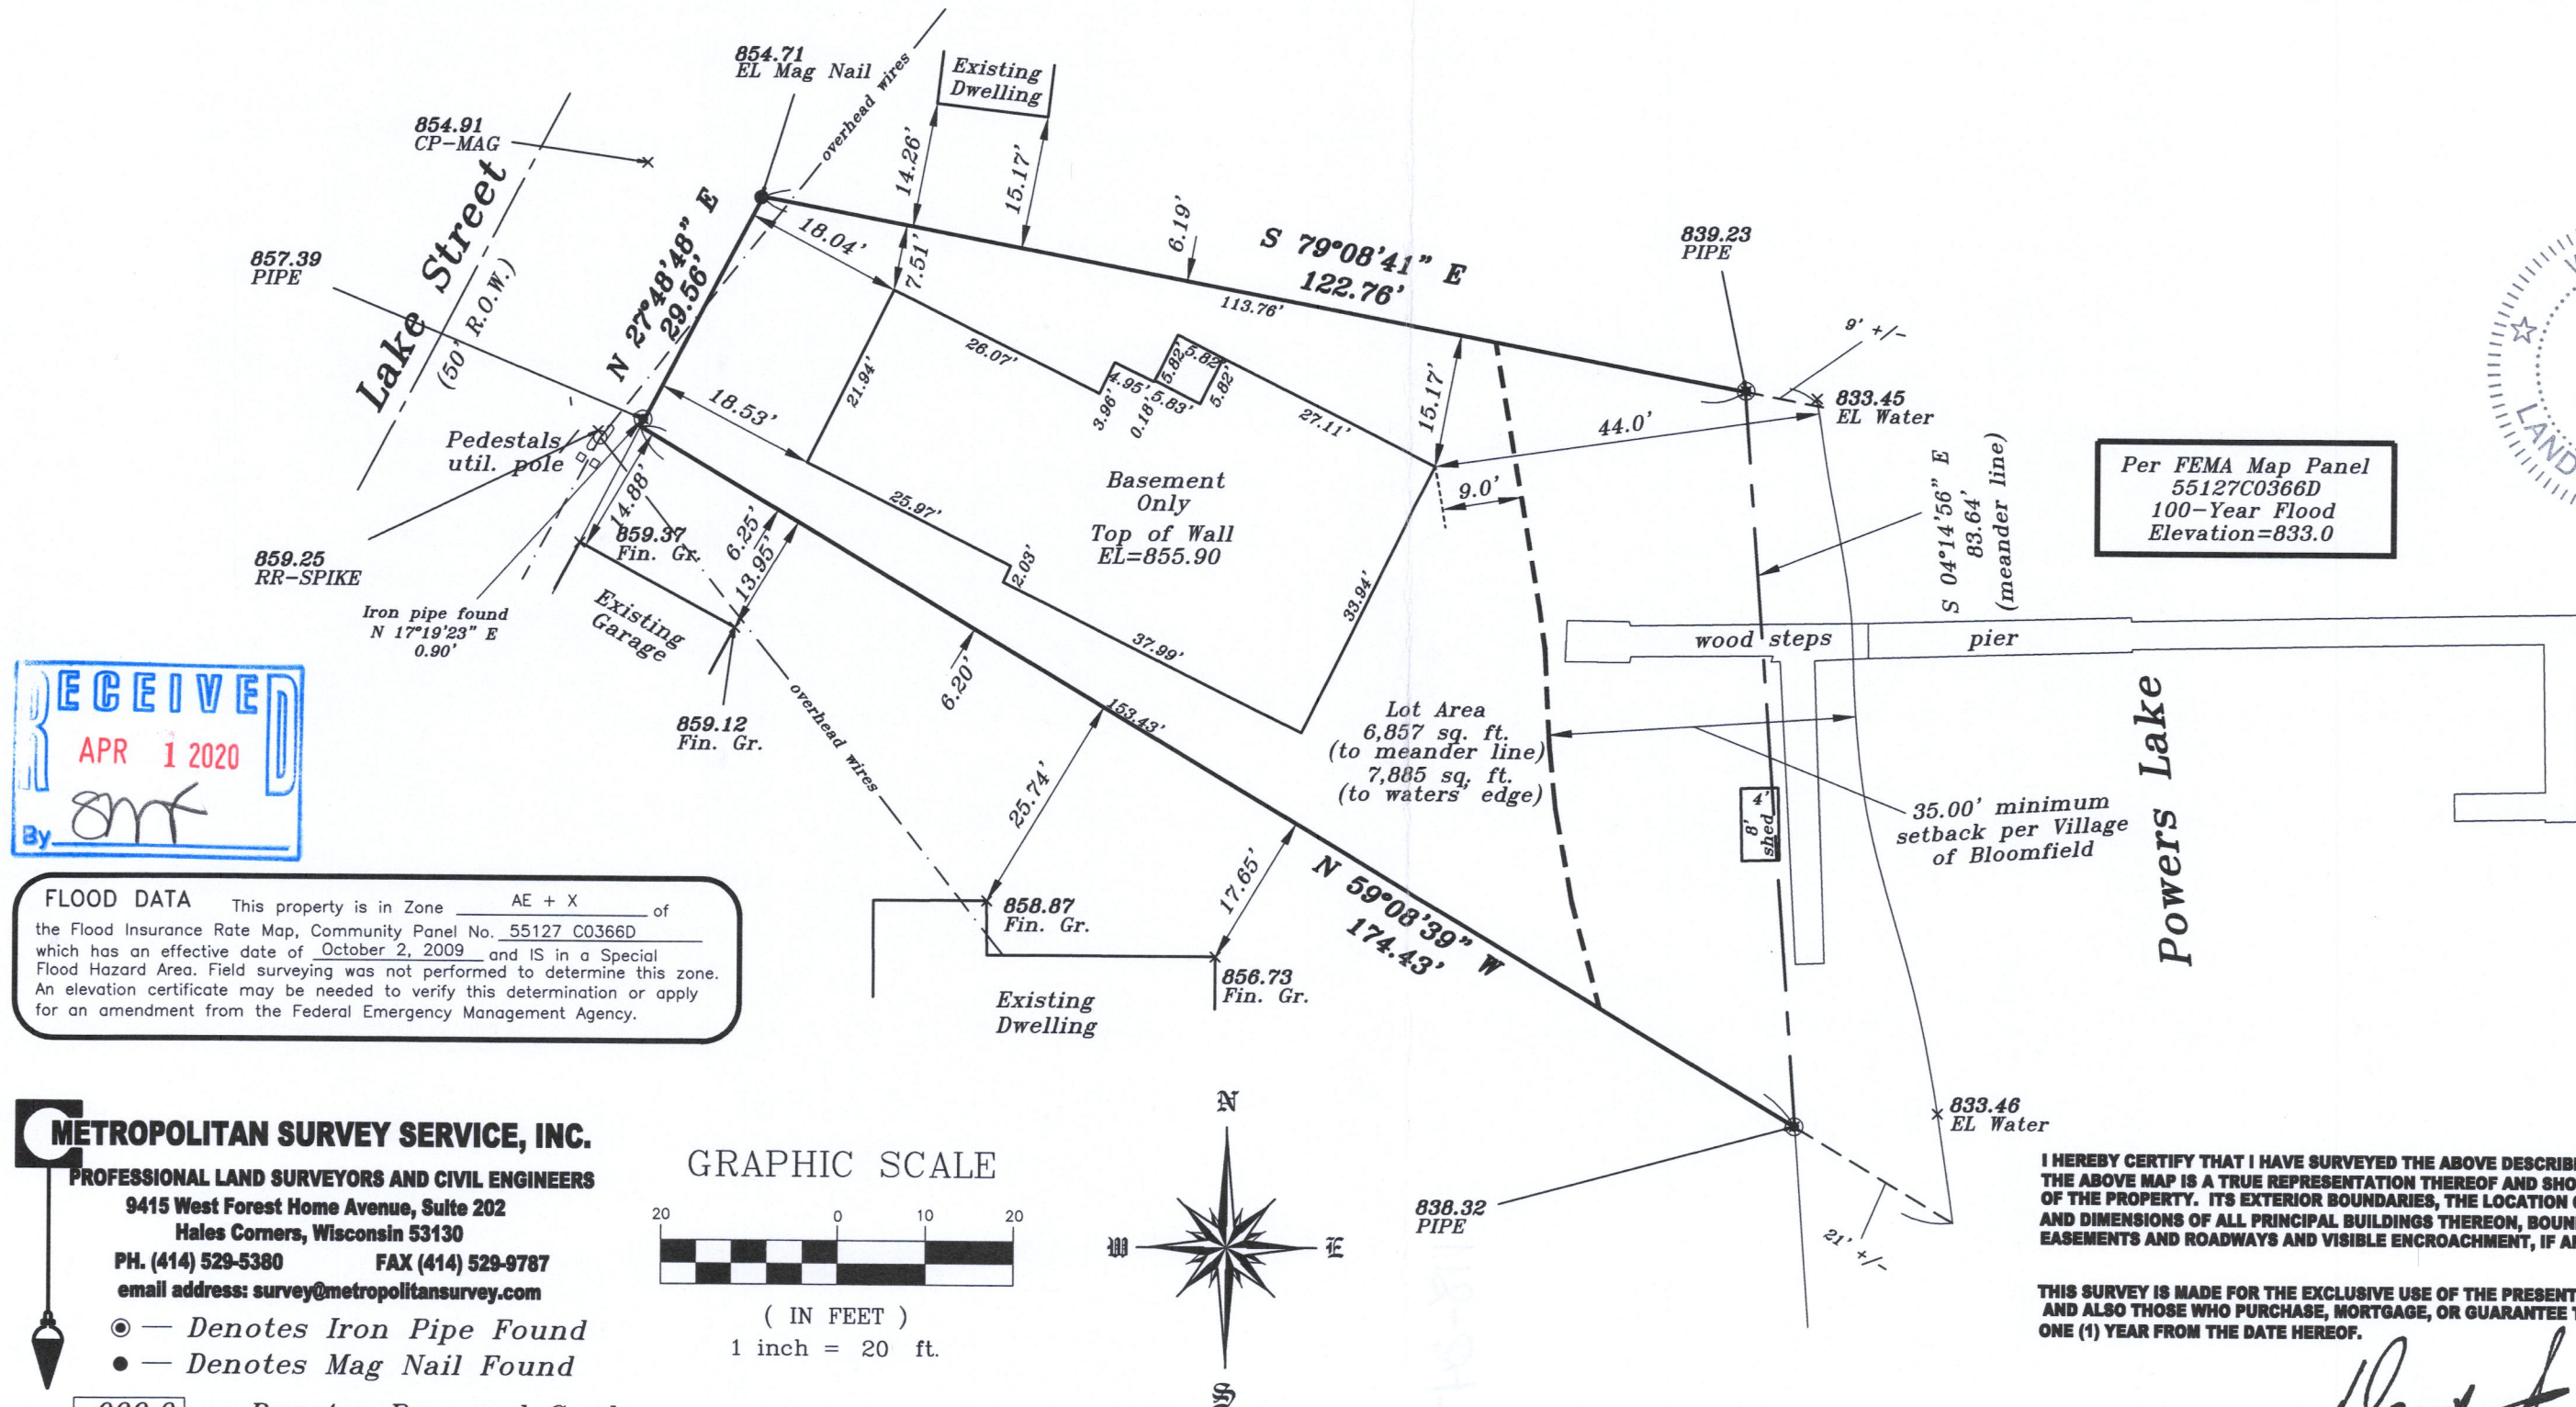

Per FEMA Map Panel
55127C0366D
100-Year Flood
Elevation=833.0

I HEREBY CERTIFY THAT I HAVE SURVEYED THE ABOVE DESCRIBED PROPERTY AND THAT THE ABOVE MAP IS A TRUE REPRESENTATION THEREOF AND SHOWS THE SIZE AND LOCATION OF THE PROPERTY. ITS EXTERIOR BOUNDARIES, THE LOCATION OF ALL VISIBLE STRUCTURES AND DIMENSIONS OF ALL PRINCIPAL BUILDINGS THEREON, BOUNDARY FENCES, APPARENT EASEMENTS AND ROADWAYS AND VISIBLE ENCROACHMENT, IF ANY.

THIS SURVEY IS MADE FOR THE EXCLUSIVE USE OF THE PRESENT OWNERS OF THE PROPERTY, AND ALSO THOSE WHO PURCHASE, MORTGAGE, OR GUARANTEE THE TITLE THERETO WITHIN ONE (1) YEAR FROM THE DATE HEREOF.

SIGNED Dennis C. Sauer
Dennis C. Sauer
Professional Land Surveyor S-2421

118-3474