


Parcel ID#: &PLH 00246

Plat of a survey for Robert Erickson and Gwen Erickson of Lots 1174 thru 1184 and 1202 thru 1218 in Block 7 of Pell Lake Highlands Subdivision, being in the Southeast 1/4 of Section 6, Township 1 North, Range 18 East of the Fourth Principal Meridian, in the Village of Genoa City, Walworth County, Wisconsin.

Certificate

The above-described property has been surveyed under my direction and the map hereon drawn is a correct representation thereof to the best of my knowledge and belief.


08/10/2021

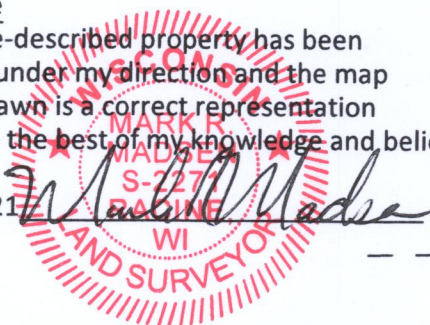

N.L. OF SE 1/4 OF SECTION 6-1-18

SE 1/4 NE CORNER
SECTION 6-1-18
N 203,105.31
E 2,409,346.26

WEST FOREST ROAD
(33' WIDE)

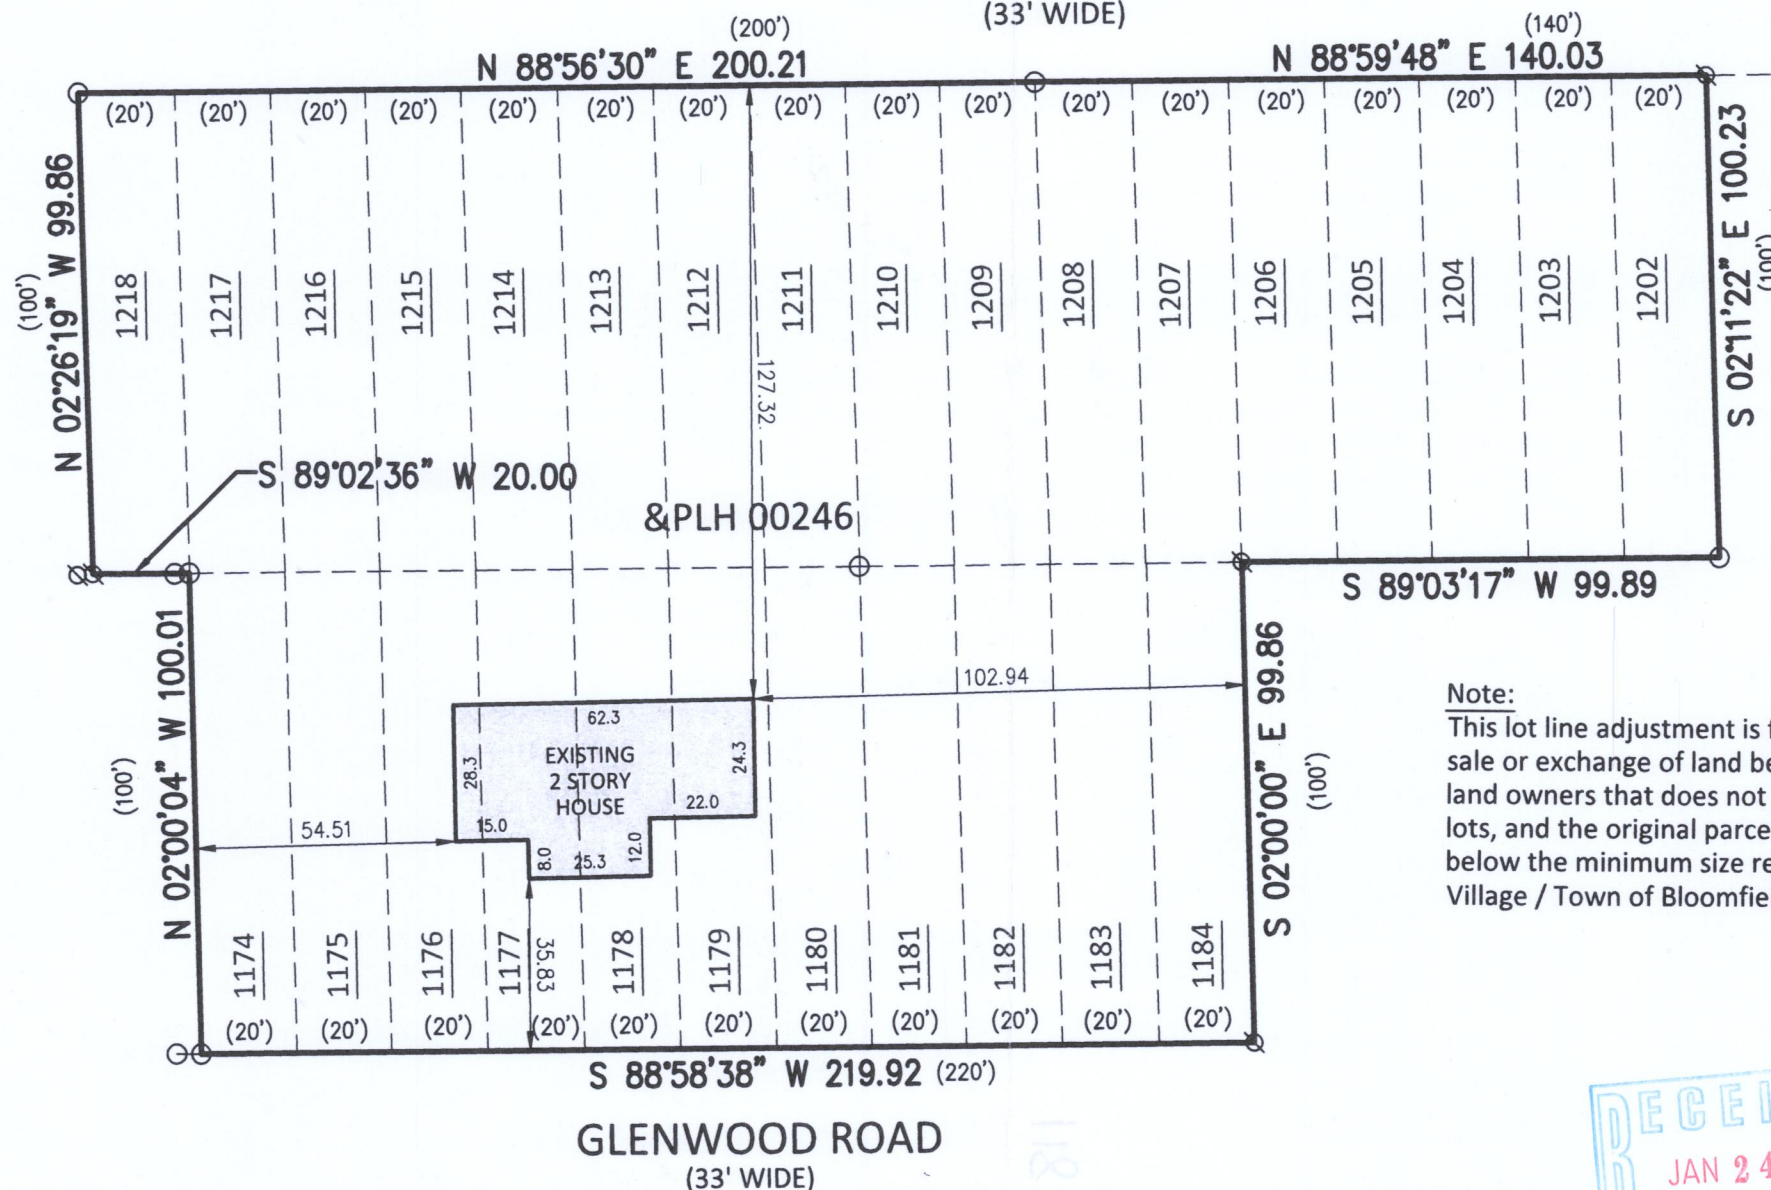

NOTES

BEARING BASE: GRID NORTH, WISCONSIN
COORDINATE SYSTEM, SOUTH ZONE.
BASED UPON NAD 1983 / 2011

LEGEND

- () RECORDED AS
- FOUND IRON PIPE
- ⊗ FOUND REBAR


Note:

This lot line adjustment is for the purpose of a sale or exchange of land between adjoining land owners that does not create additional lots, and the original parcels are not reduced below the minimum size required by the Village / Town of Bloomfield's Municipal Codes.



Nielsen Madsen + Barber
CIVIL ENGINEERS AND LAND SURVEYORS

1458 Horizon Blvd. Suite 200, Racine, WI. 53406
Tele: (262)634-5588 Website: www.nmbssc.net

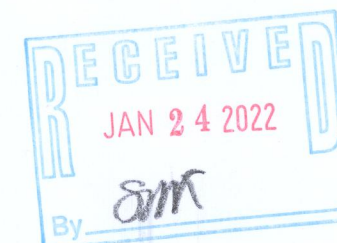

FIELD WORK 12-27-2019 BY JWP/BME
DRAWN 8-9-2021 BY SCB
SCALE 1" = 40'
SHEET 1 OF 1 SHEETS
JOB NO. 2019.0269.01

&PLH-246

118-35060