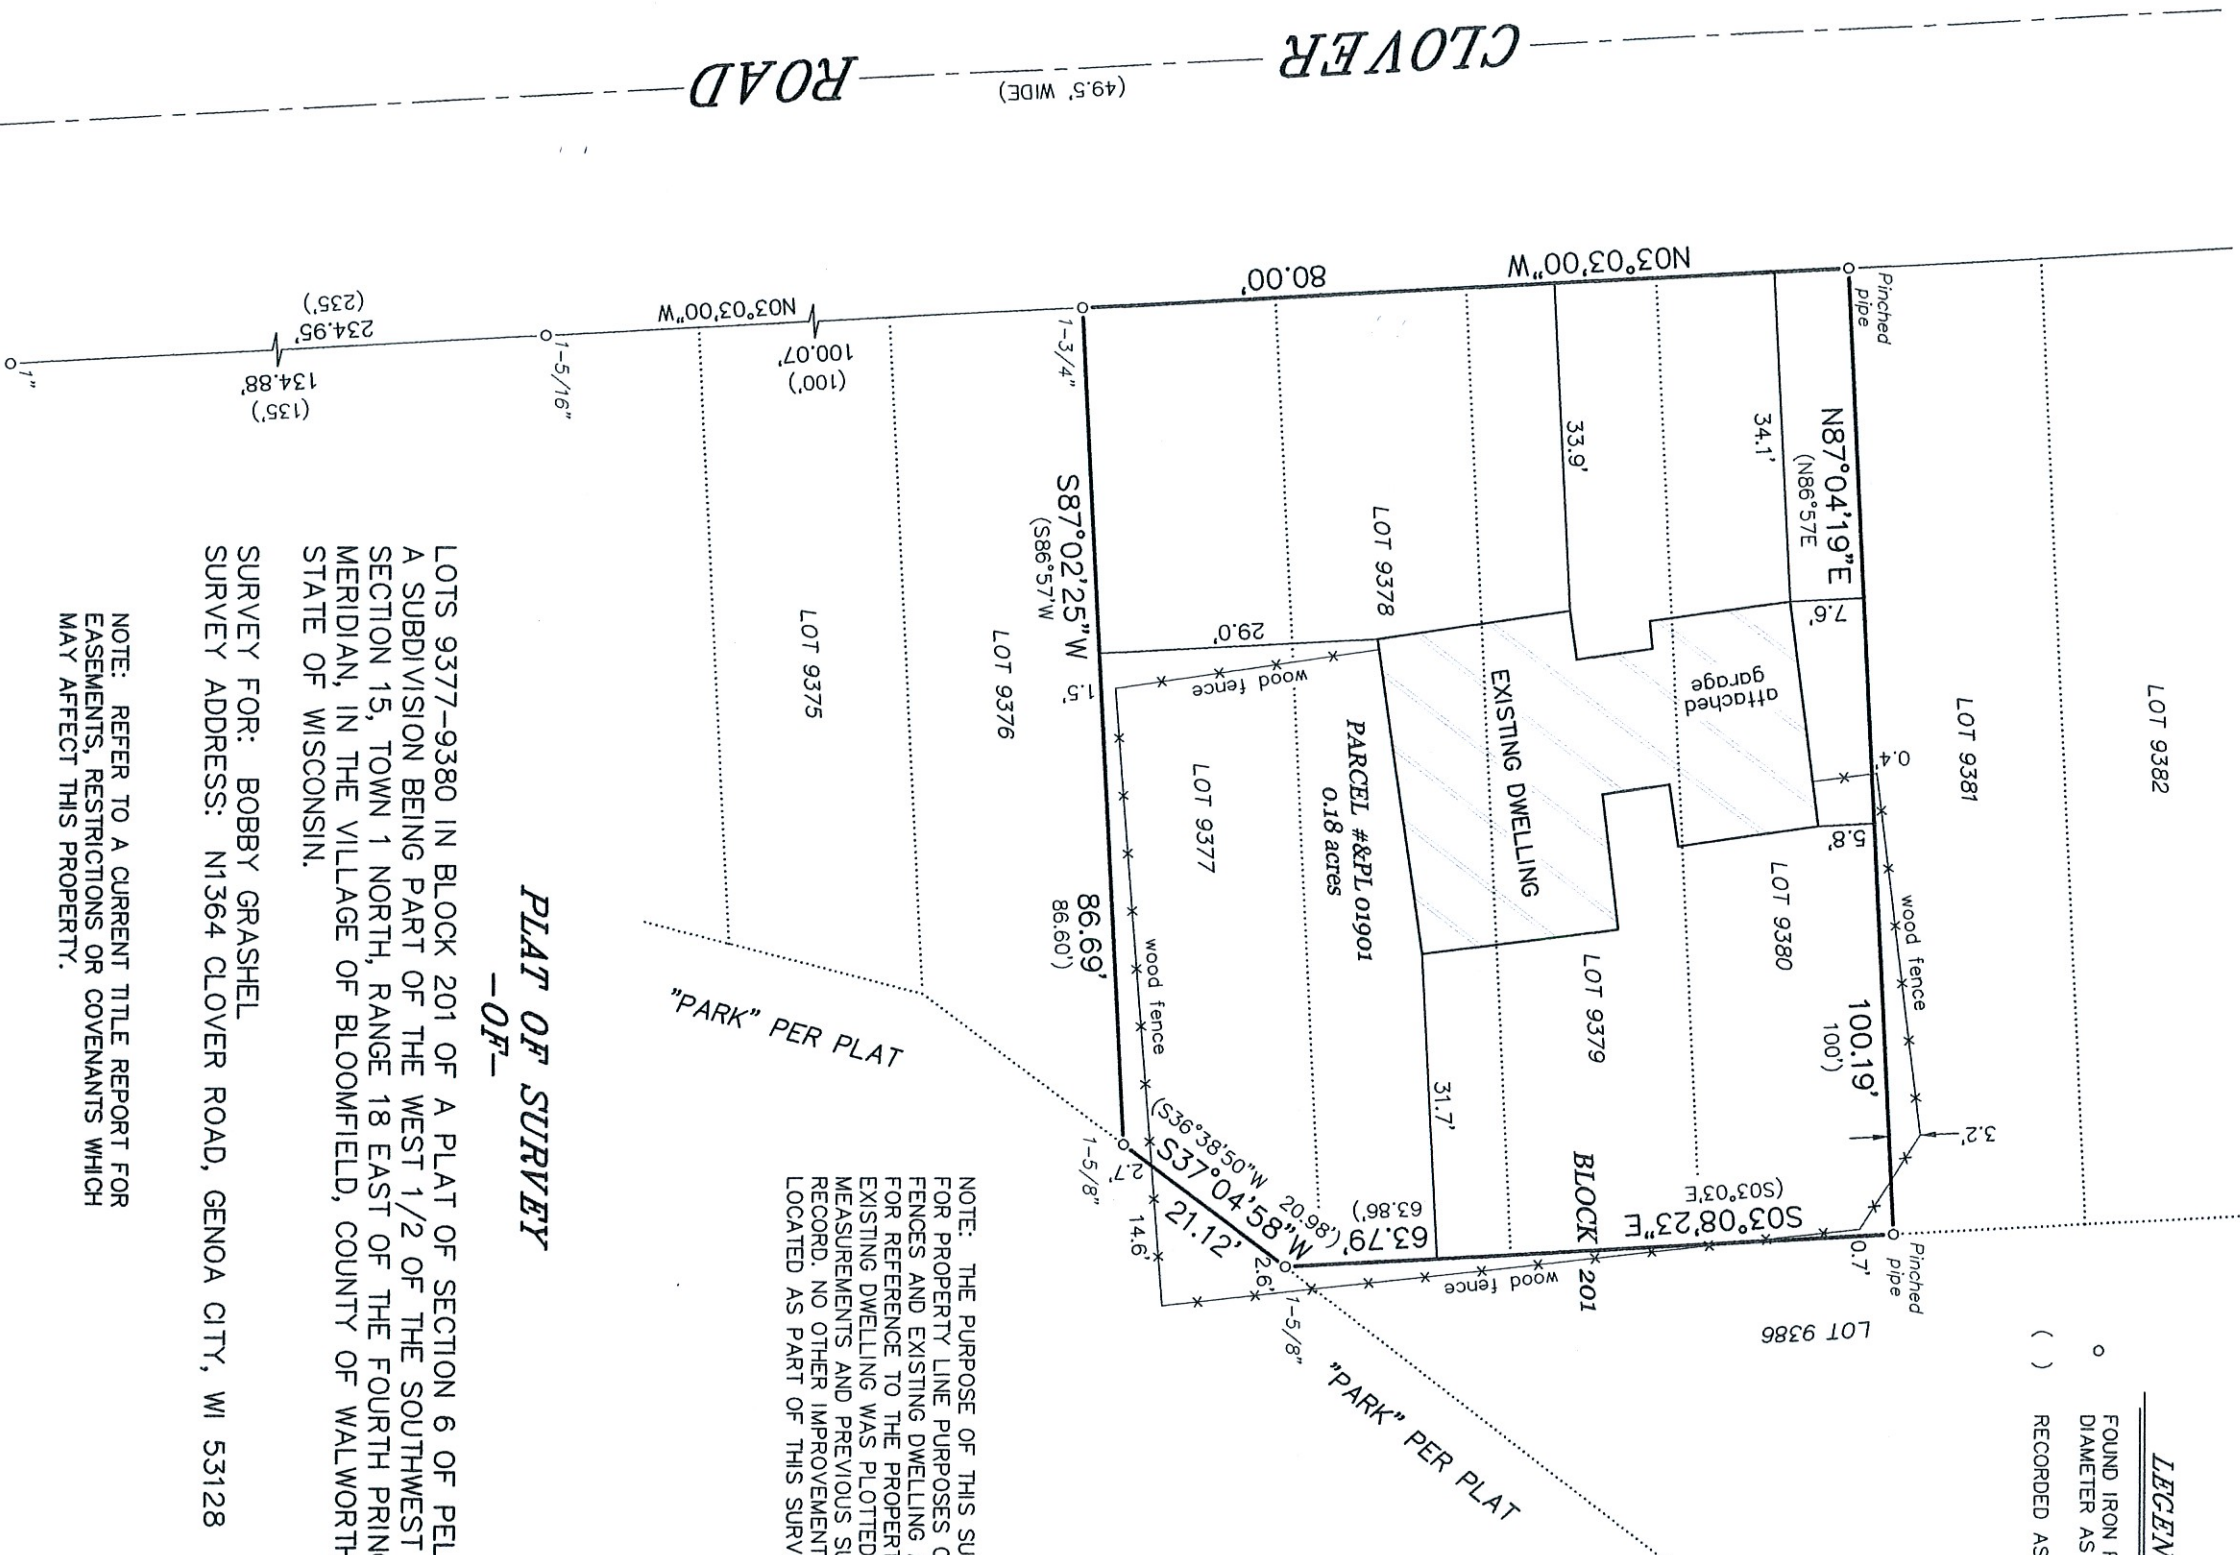


LEGEND

o FOUND IRON PIPE (OUTSIDE
DIAMETER AS NOTED)

() RECORDED AS

○ FOUND IRON PIPE (OUTSIDE
DIAMETER AS NOTED)

PLAT OF SURVEY
-OF-

SURVEY FOR: BOBBY GRASHEL
SURVEY ADDRESS: N1364 CLOVER ROAD, GENOA CITY, WI 53128

BEARINGS HEREON RELATE TO THE EAST
RIGHT-OF-WAY LINE OF CLOVER ROAD. ASSUMED
BEARING OF NORTH 03°03'00" WEST AS PLATTED.

"THIS SURVEY IS MADE FOR THE USE OF THE PRESENT OWNERS OF THE PROPERTY, AND THOSE WHO PURCHASE, MORTGAGE, OR GUARANTEE THE TITLE THERETO WITHIN ONE YEAR FROM DATE HEREOF."

THIS IS NOT AN ORIGINAL PRINT
UNLESS THIS SEAL IS RED.

Thomas Z. Satter

APRIL 11, 2022

DATE

032210

JOB NUMBER

DATE _____