


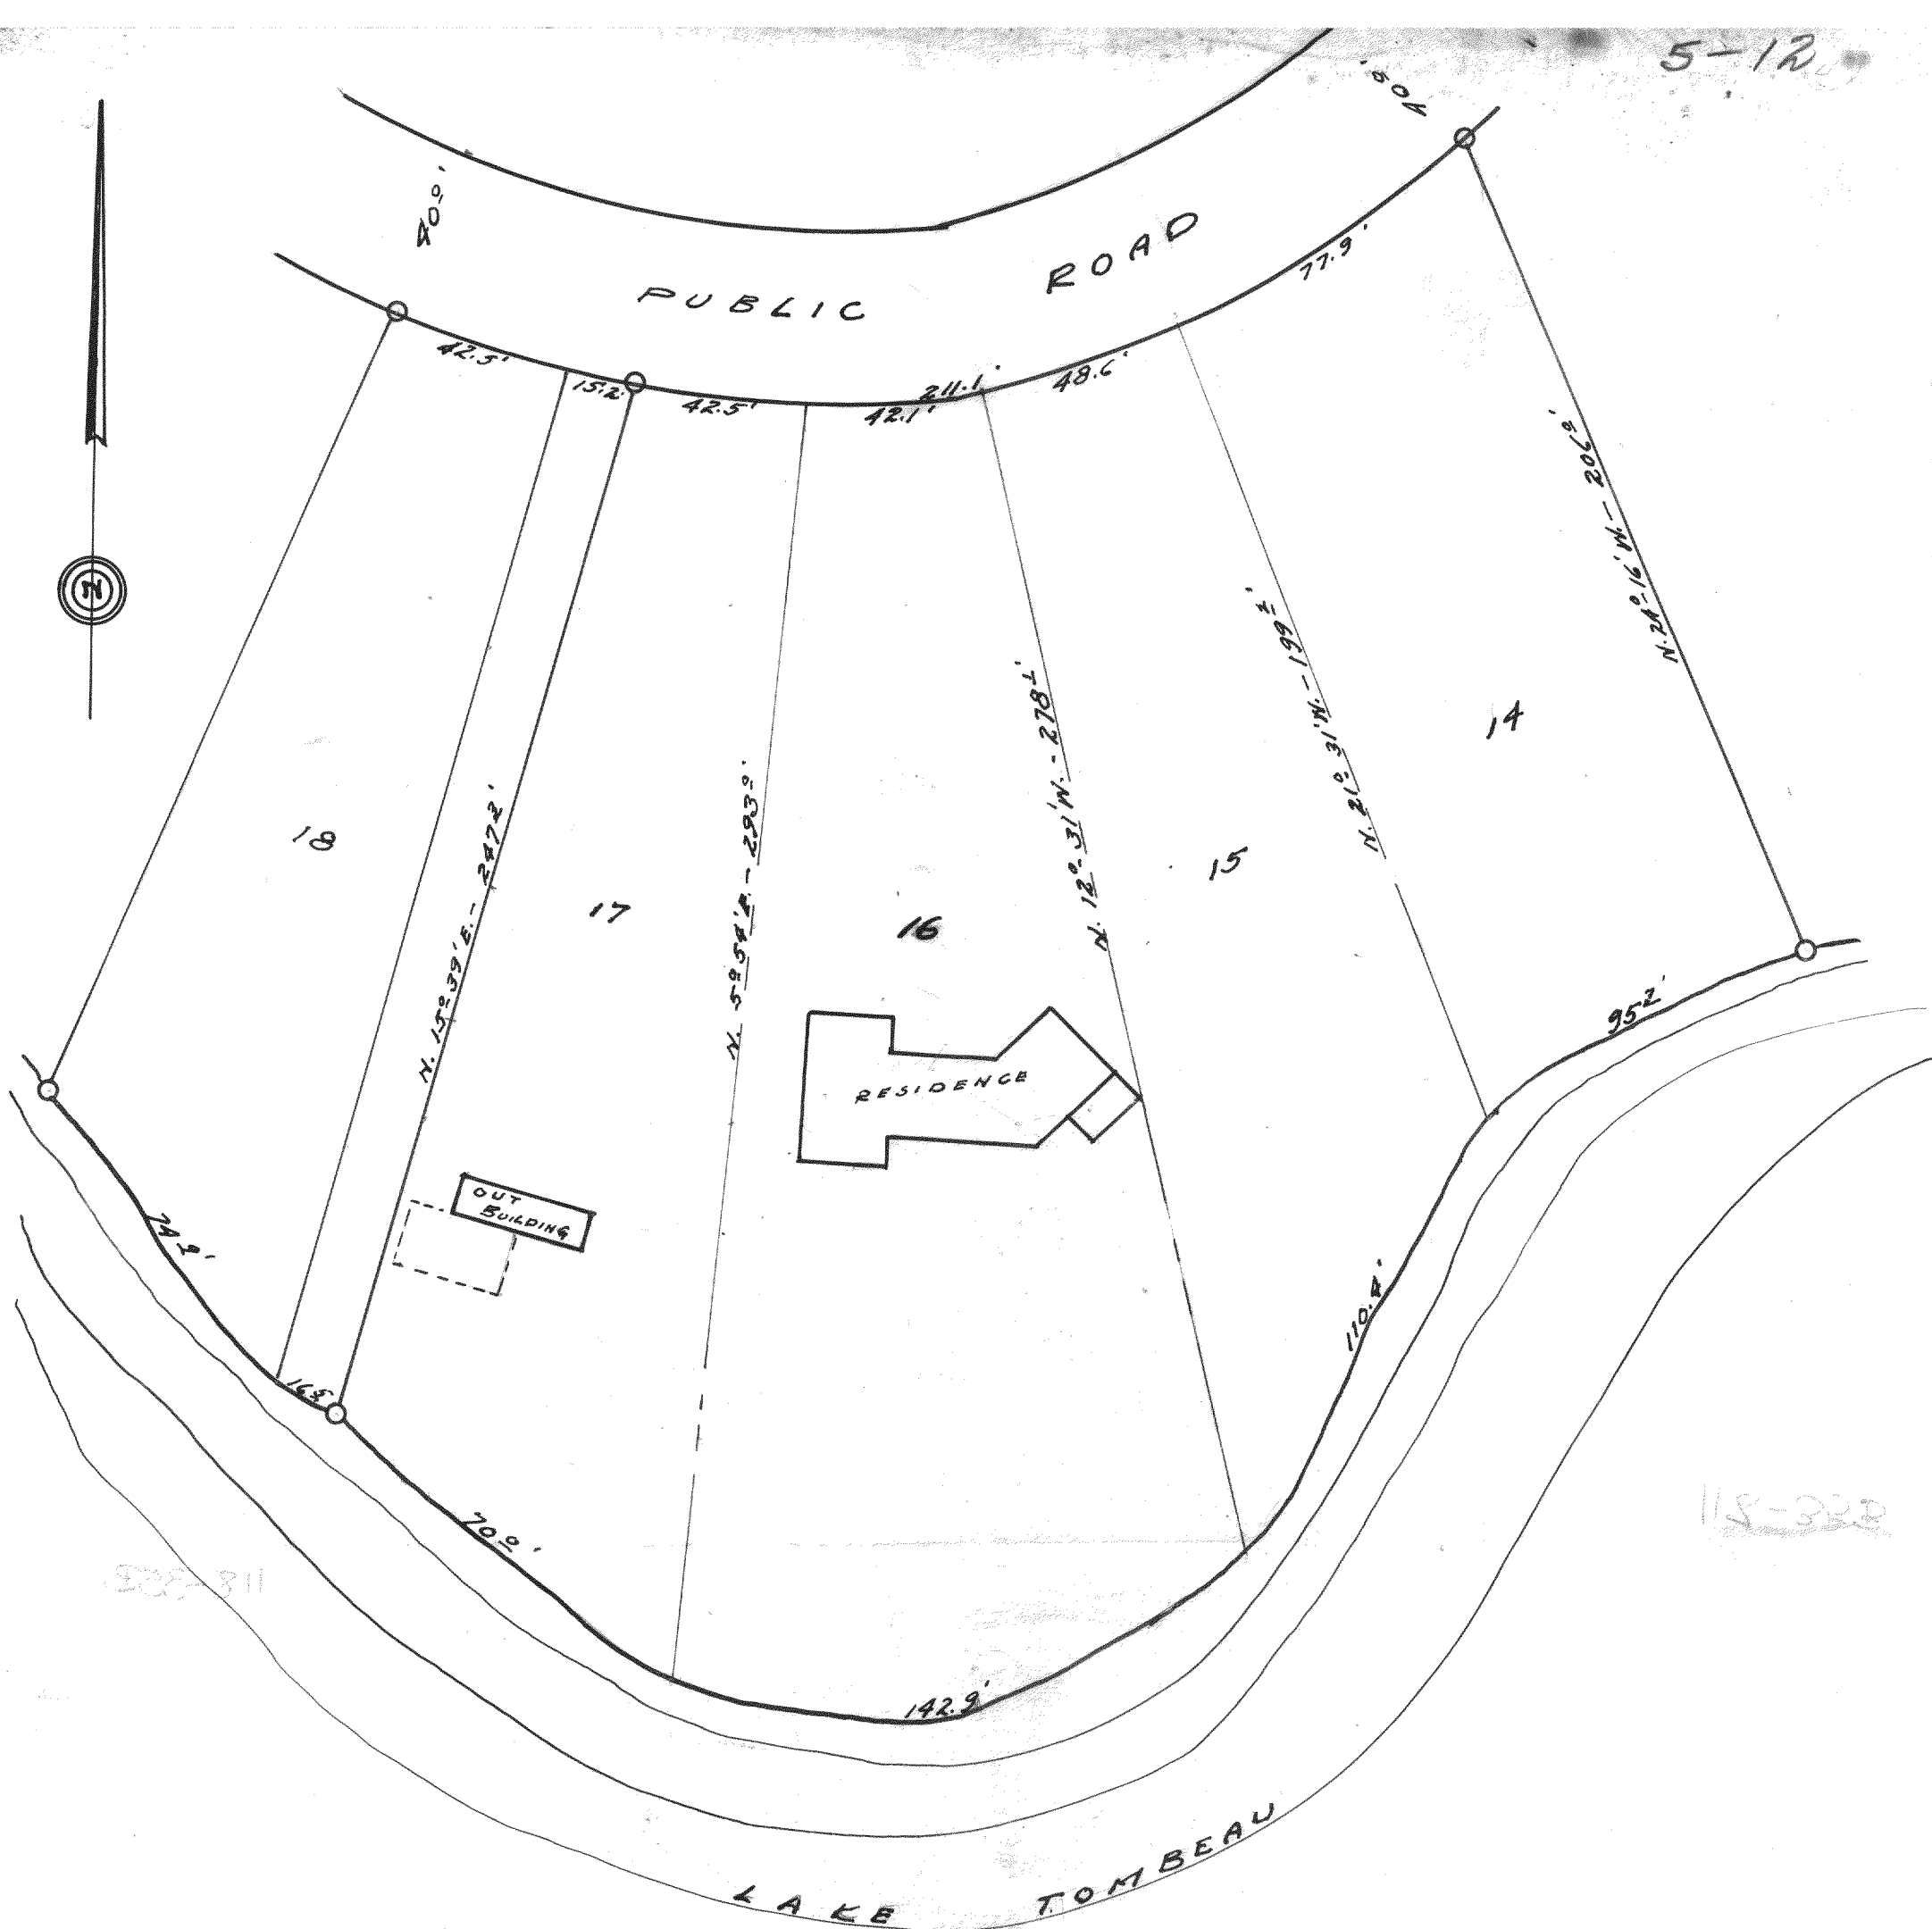

DESCRIPTION:

Lots 14, 15, 16, & 17, Block #1 of Nippersink Park, Being a Subdivision in the Town of Bloomfield, Walworth County, Wisconsin.

CERTIFICATE:

I, hereby certify that I have on this the 27th day of August 1952, surveyed the above described property according to the official record on file in the office of the Recorder of Deeds in and for Walworth County, Wisconsin, and find that the measurements and bearings of the boundary lines of said property as taken at the site on this day, substantially agree with those in said official record, and that the residence and out building shown as being constructed upon said property are wholly within the confines of the boundary lines of said property and that no encroachments exist.

SIGNED AND SEALED ON THIS THE 28TH DAY OF AUGUST 1952.

Joseph M. Biagi
Joseph M. Biagi, Consulting Engineer.
Elkhorn Wisconsin.