


PLAT OF SURVEY

- OF -

LOT 1, BLOCK 1 OF PART ONE OF FIRST ADDITION TO JEFFERSON ISLAND SUBDIVISION,
A SUBDIVISION IN SECTION 13, TOWN 1 NORTH, RANGE 18 EAST OF THE FOURTH PRINCIPAL
MERIDIAN, TOWN (NOW VILLAGE) OF BLOOMFIELD, WALWORTH COUNTY, STATE OF WISCONSIN.


SURVEY FOR: BOB RIGGS CONSTRUCTION
SURVEY LOCATION: W146 92ND STREET

NOTE: REFER TO CURRENT TITLE REPORT FOR
EASEMENTS AND/OR RESTRICTIONS THAT
MAY AFFECT THE USE OF THIS SITE.

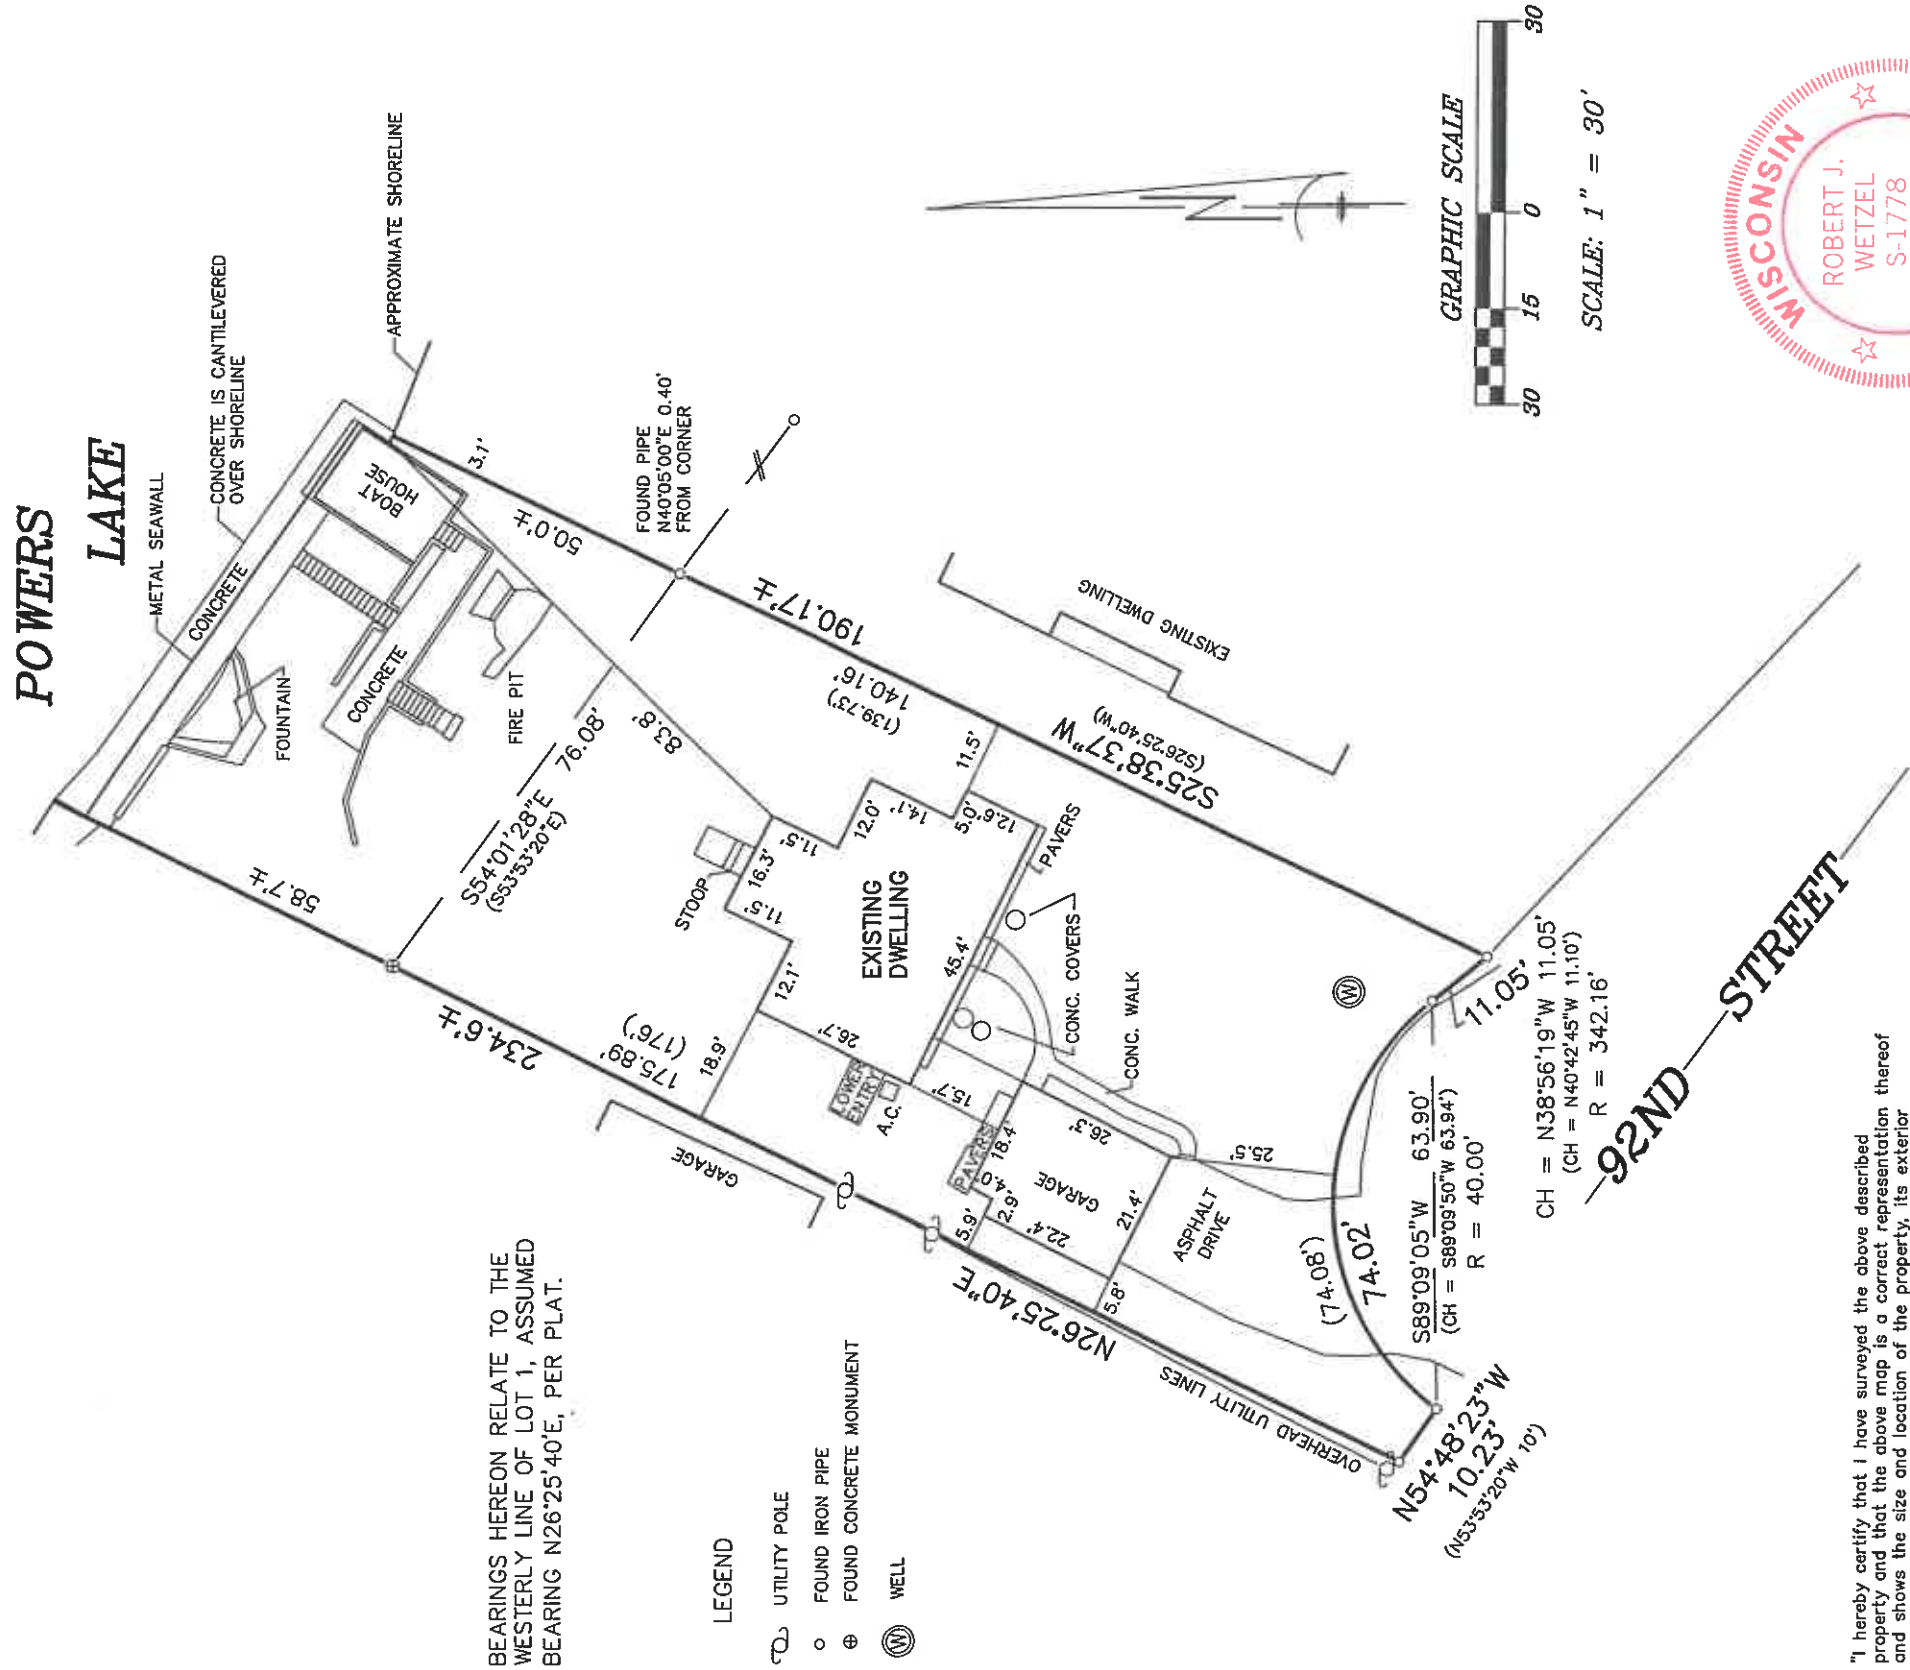

"I hereby certify that I have surveyed the above described
property and that the above map is a correct representation thereof
and shows the size and location of the property, its exterior
boundaries, the location of all visible structures and dimensions
of all principal buildings thereon, boundary fences, apparent
easements, roadways and encroachments, if any."

"This survey is made for the use of the present owners of the
property, and those who purchase, mortgage, or guarantee the
title thereto within one year from date hereof."

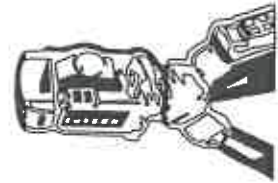

B.W. SURVEYING, INC.

LAND SURVEYS
MAPPING AND PLANNING

412 N. PINE STREET
BURLINGTON, WI 53105
(262)-767-0225

THIS IS NOT AN ORIGINAL PRINT
UNLESS THIS SEAL IS RED.



Robert J. Wetzel
ROBERT J. WETZEL, S-1778

OCTOBER 11, 2022
DATE

10734
JOB NUMBER