


GEORGE T. DUNHAM
SURVEYING & SUBDIVIDING
DELAVER, WISCONSIN

HIGHLAND

BOULEVARD

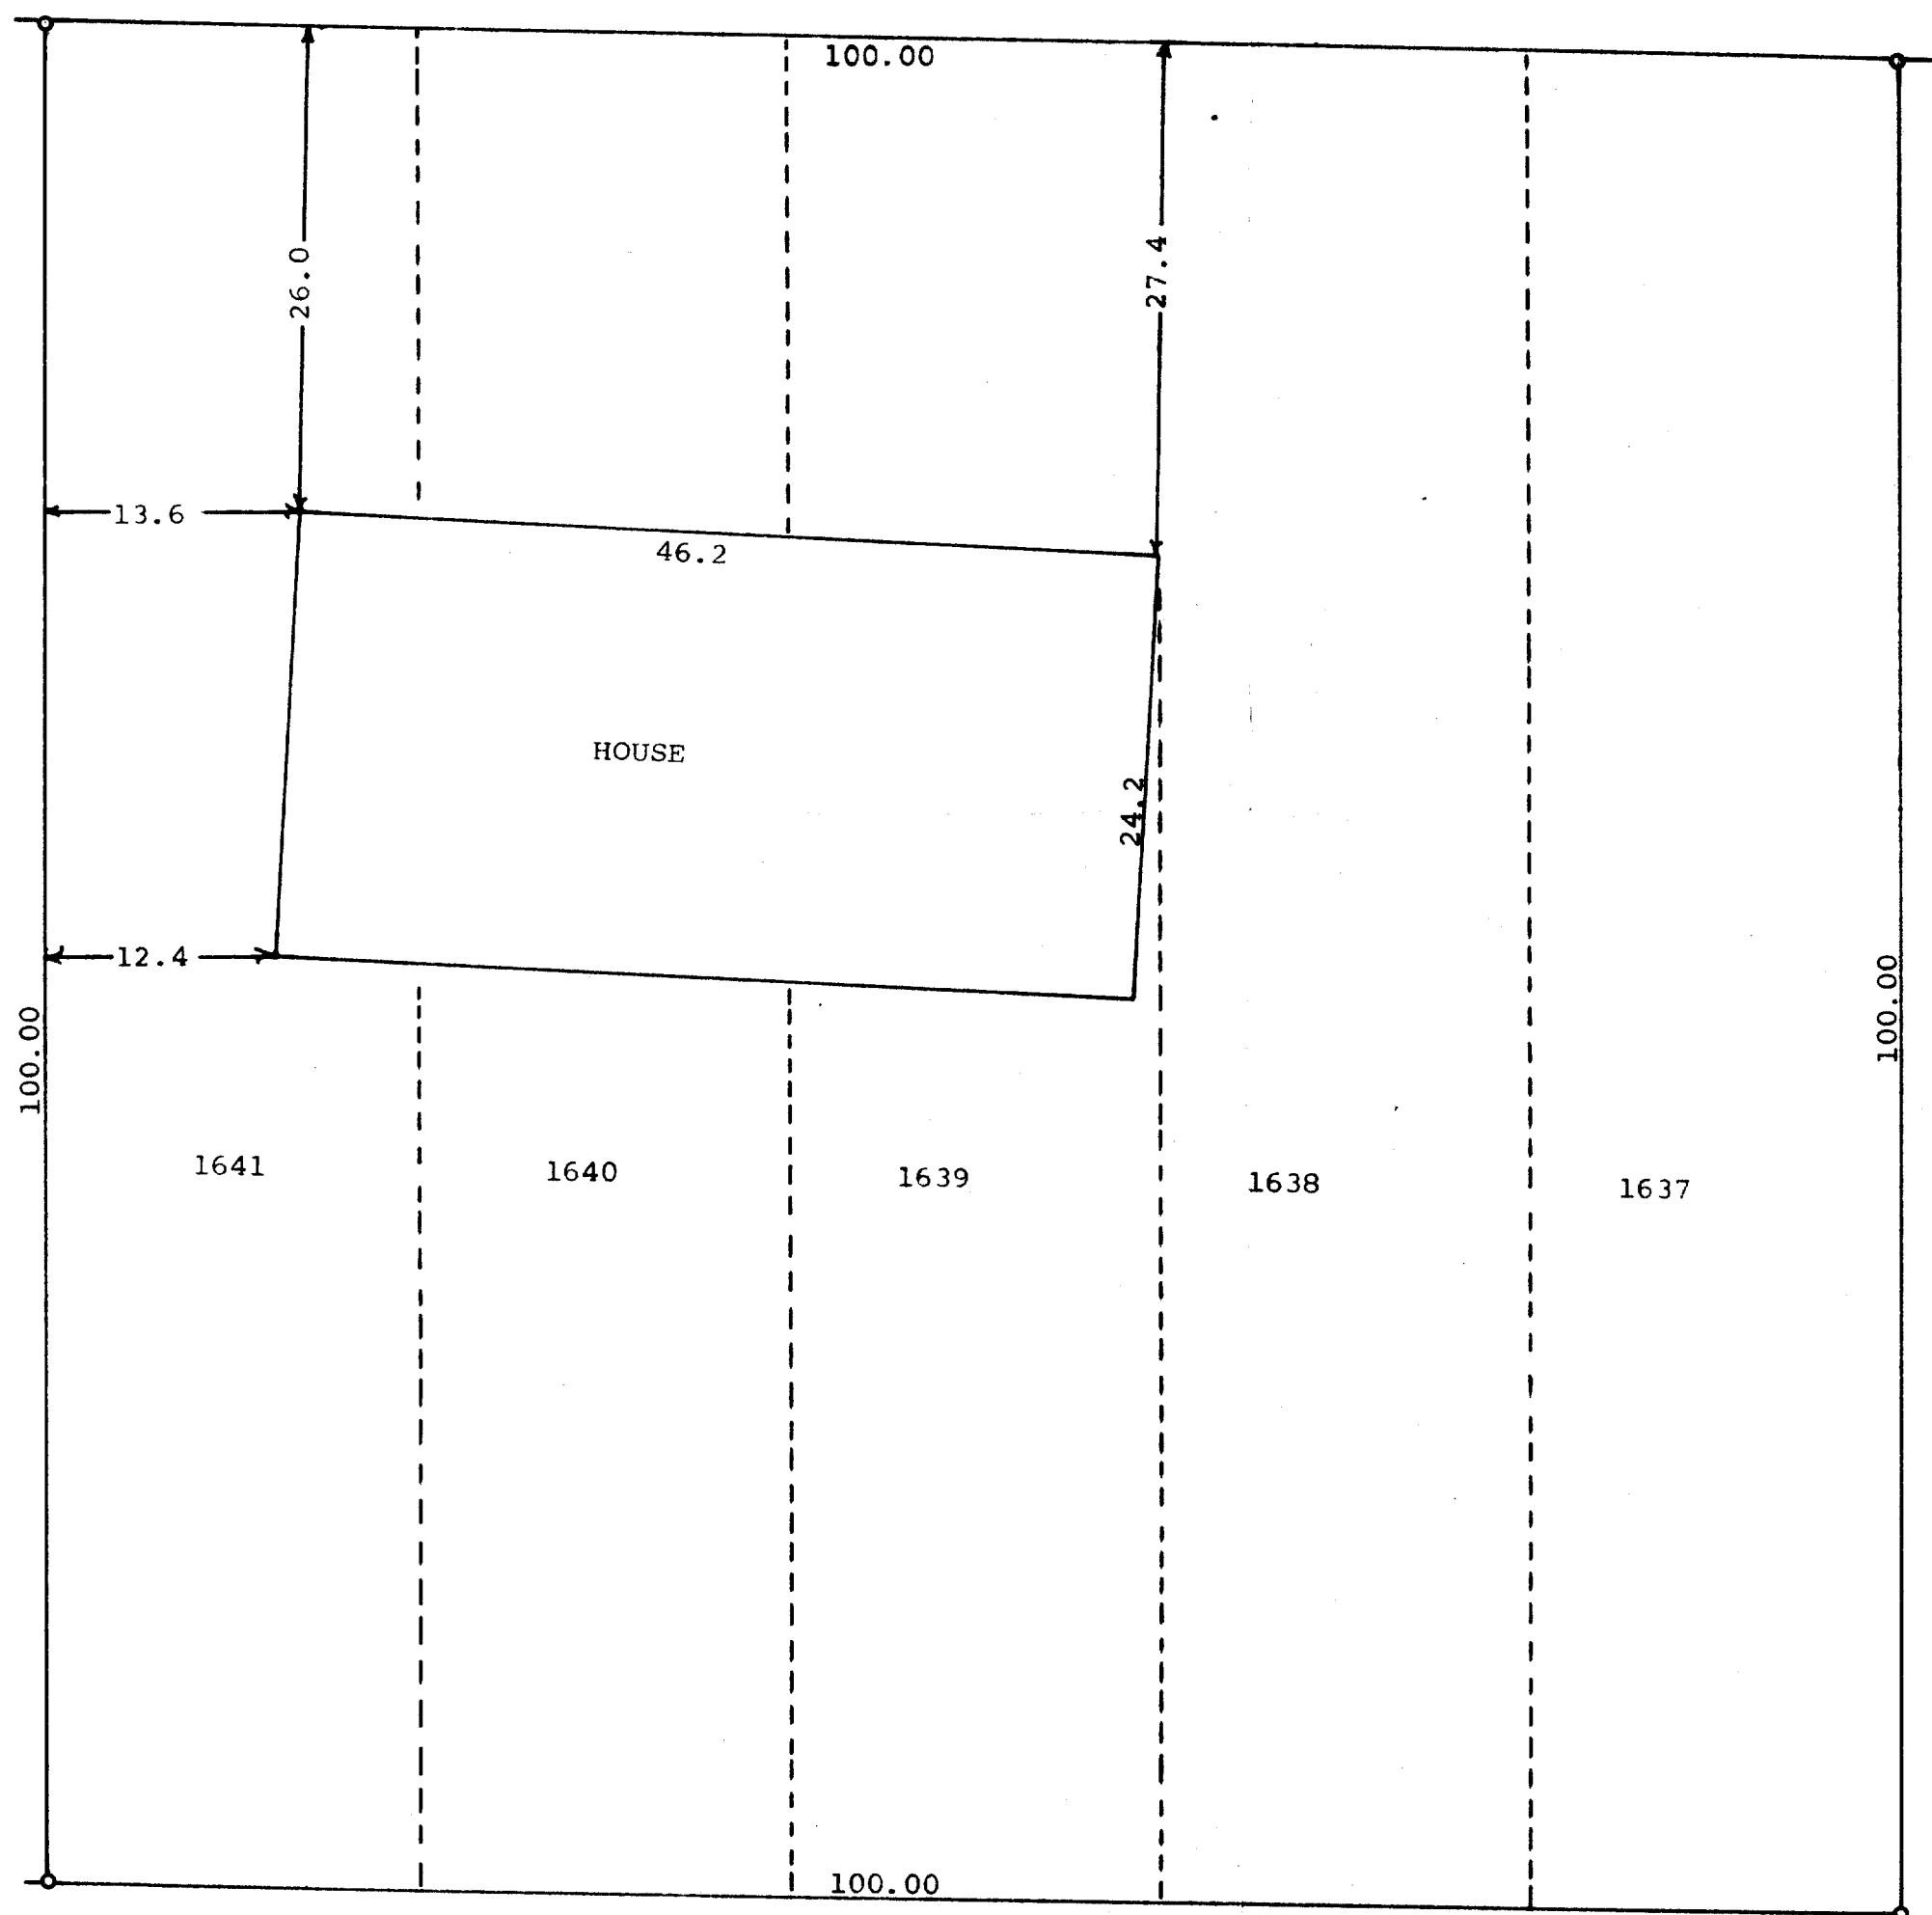

Scale - 1" = 10'
● = Iron Pipe

STATE OF WISCONSIN)
COUNTY OF WALWORTH) SS

I, George T. Dunham, Surveyor, certify that I have surveyed the property described as follows,

Lots 1637, 1638, 1639, 1640, and 1641 in Block 24 of Pell Lake Highlands, a subdivision located in Section 16, T1N, R18E, Walworth County, Wisconsin,

and that the plat shown above is an accurate survey and a true representation thereof and correctly shows the exterior boundary lines and location of the buildings located thereon and the correct measurements thereof.

July 21, 1972

George T. Dunham
George T. Dunham, Surveyor

