


PLAT OF SURVEY

LOT 1 OF LAKE TOMBEAU WOODS SUBDIVISION, LOCATED IN
SECTION 24, TOWN 1 NORTH, RANGE 18 EAST, VILLAGE OF
BLOOMFIELD, WALWORTH COUNTY, WISCONSIN.

OWNER:
ASHLEY MASUR
N1143 JOY DRIVE
GENOA CITY, WI 53128

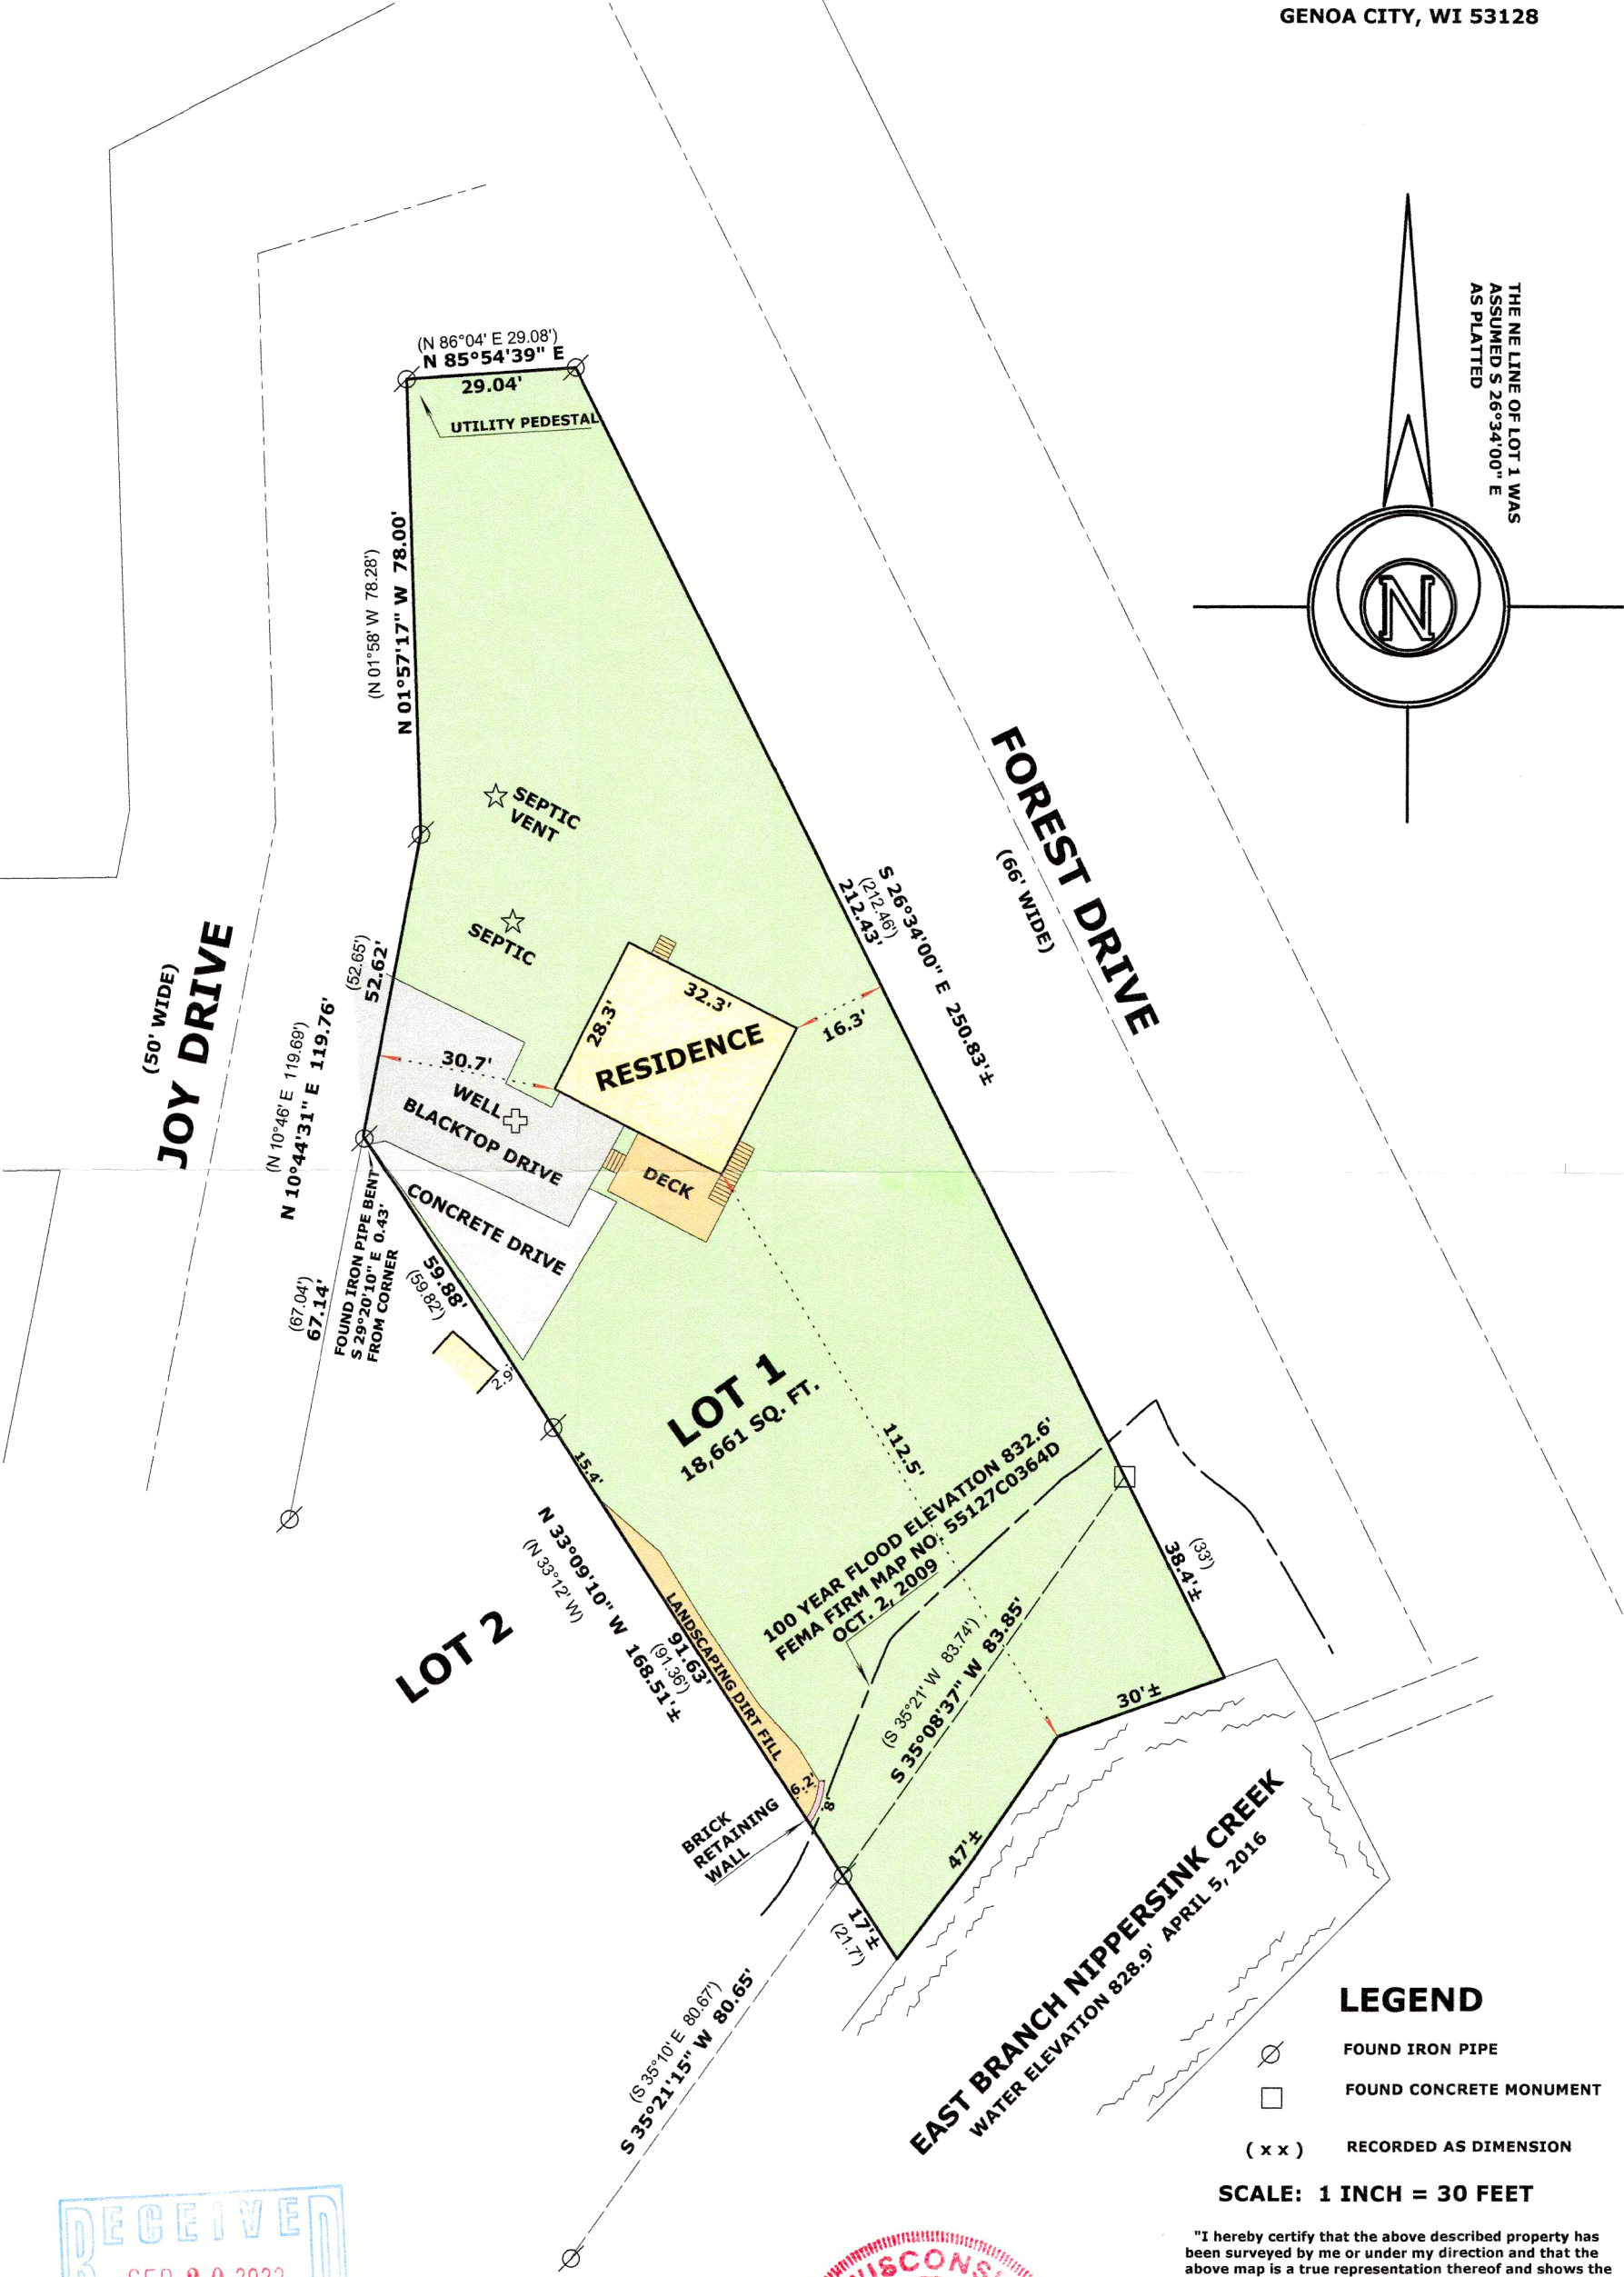

LEGEND

- FOUND IRON PIPE
- FOUND CONCRETE MONUMENT
- (x x) RECORDED AS DIMENSION

SCALE: 1 INCH = 30 FEET

"I hereby certify that the above described property has been surveyed by me or under my direction and that the above map is a true representation thereof and shows the size and location of the property, its exterior boundaries, the location of all visible structures and dimensions of all principal buildings thereon, boundary fences, apparent easements, roadways and visible encroachments, if any."
"This survey is made for the use of the present owners of the property, and also those who purchase, mortgage, or guarantee the title thereto within one year from date hereof."

Mark L. Miritz
MARK L. MIRITZ
WISCONSIN PROFESSIONAL
LAND SURVEYOR S-2582

REVISED AUG. 1, 2023 TO SHOW
RETAINING WALL ENCROACHMENT

DATE: APRIL 9, 2016 JOB NO. 16.402

BLTW-1

118-3054