


HAROLD H. KOLB
REGISTERED PROFESSIONAL LAND SURVEYOR
LAKE GENEVA, WISCONSIN



PLAT OF SURVEY OF

Lots 963-969, 970-975, 976-981, 1002-1009, 1010-1015, and 1016-1020, Block 10, Pell Lake Highlands, T 1 N, R 18 E, Walworth County, Wisconsin.

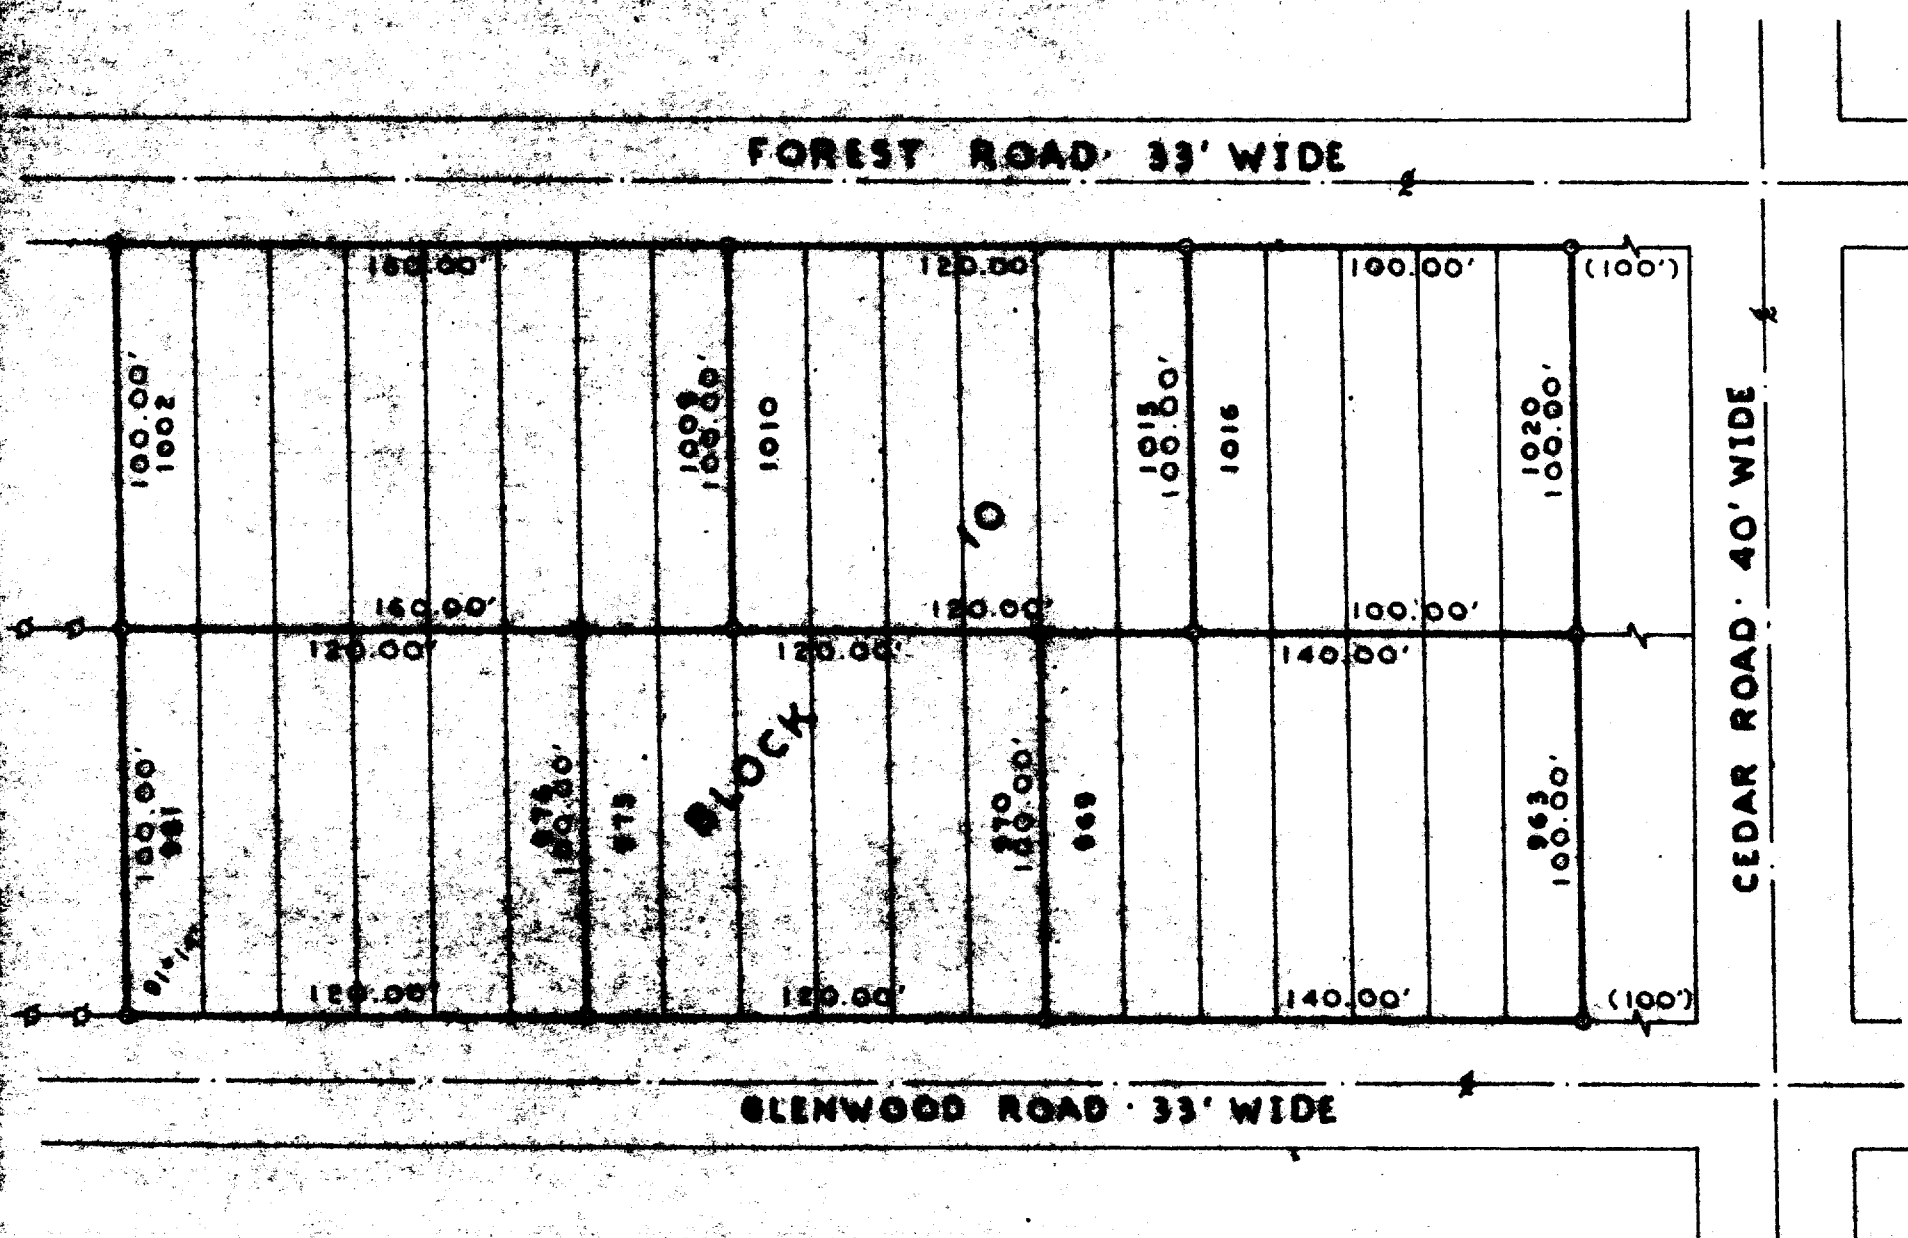

SCALE: 1" = 50'

LEGEND

- - IRON PIPE POINT
- - IRON PIPE PLACED
- - CONCRETE MONUMENT
- X - SPINE
- () - AS PLATTED



I, HAROLD H. KOLB, DO HEREBY CERTIFY THAT I HAVE SURVEYED THE PROPERTY HEREON DESCRIBED ACCORDING TO THE OFFICIAL RECORDS, AND THAT THE PLAT HEREON IS A CORRECT REPRESENTATION OF THE LOT LINES.

Harold H. Kolb
HAROLD H. KOLB

WISCONSIN REGISTERED LAND SURVEYOR, S-187
DATE October 24, 1972

MDZ4-204 205 206 207 211A 214

118-371A