


GEORGE T. DUNHAM
SURVEYING & SUBDIVIDING
DELAVAN, WISCONSIN

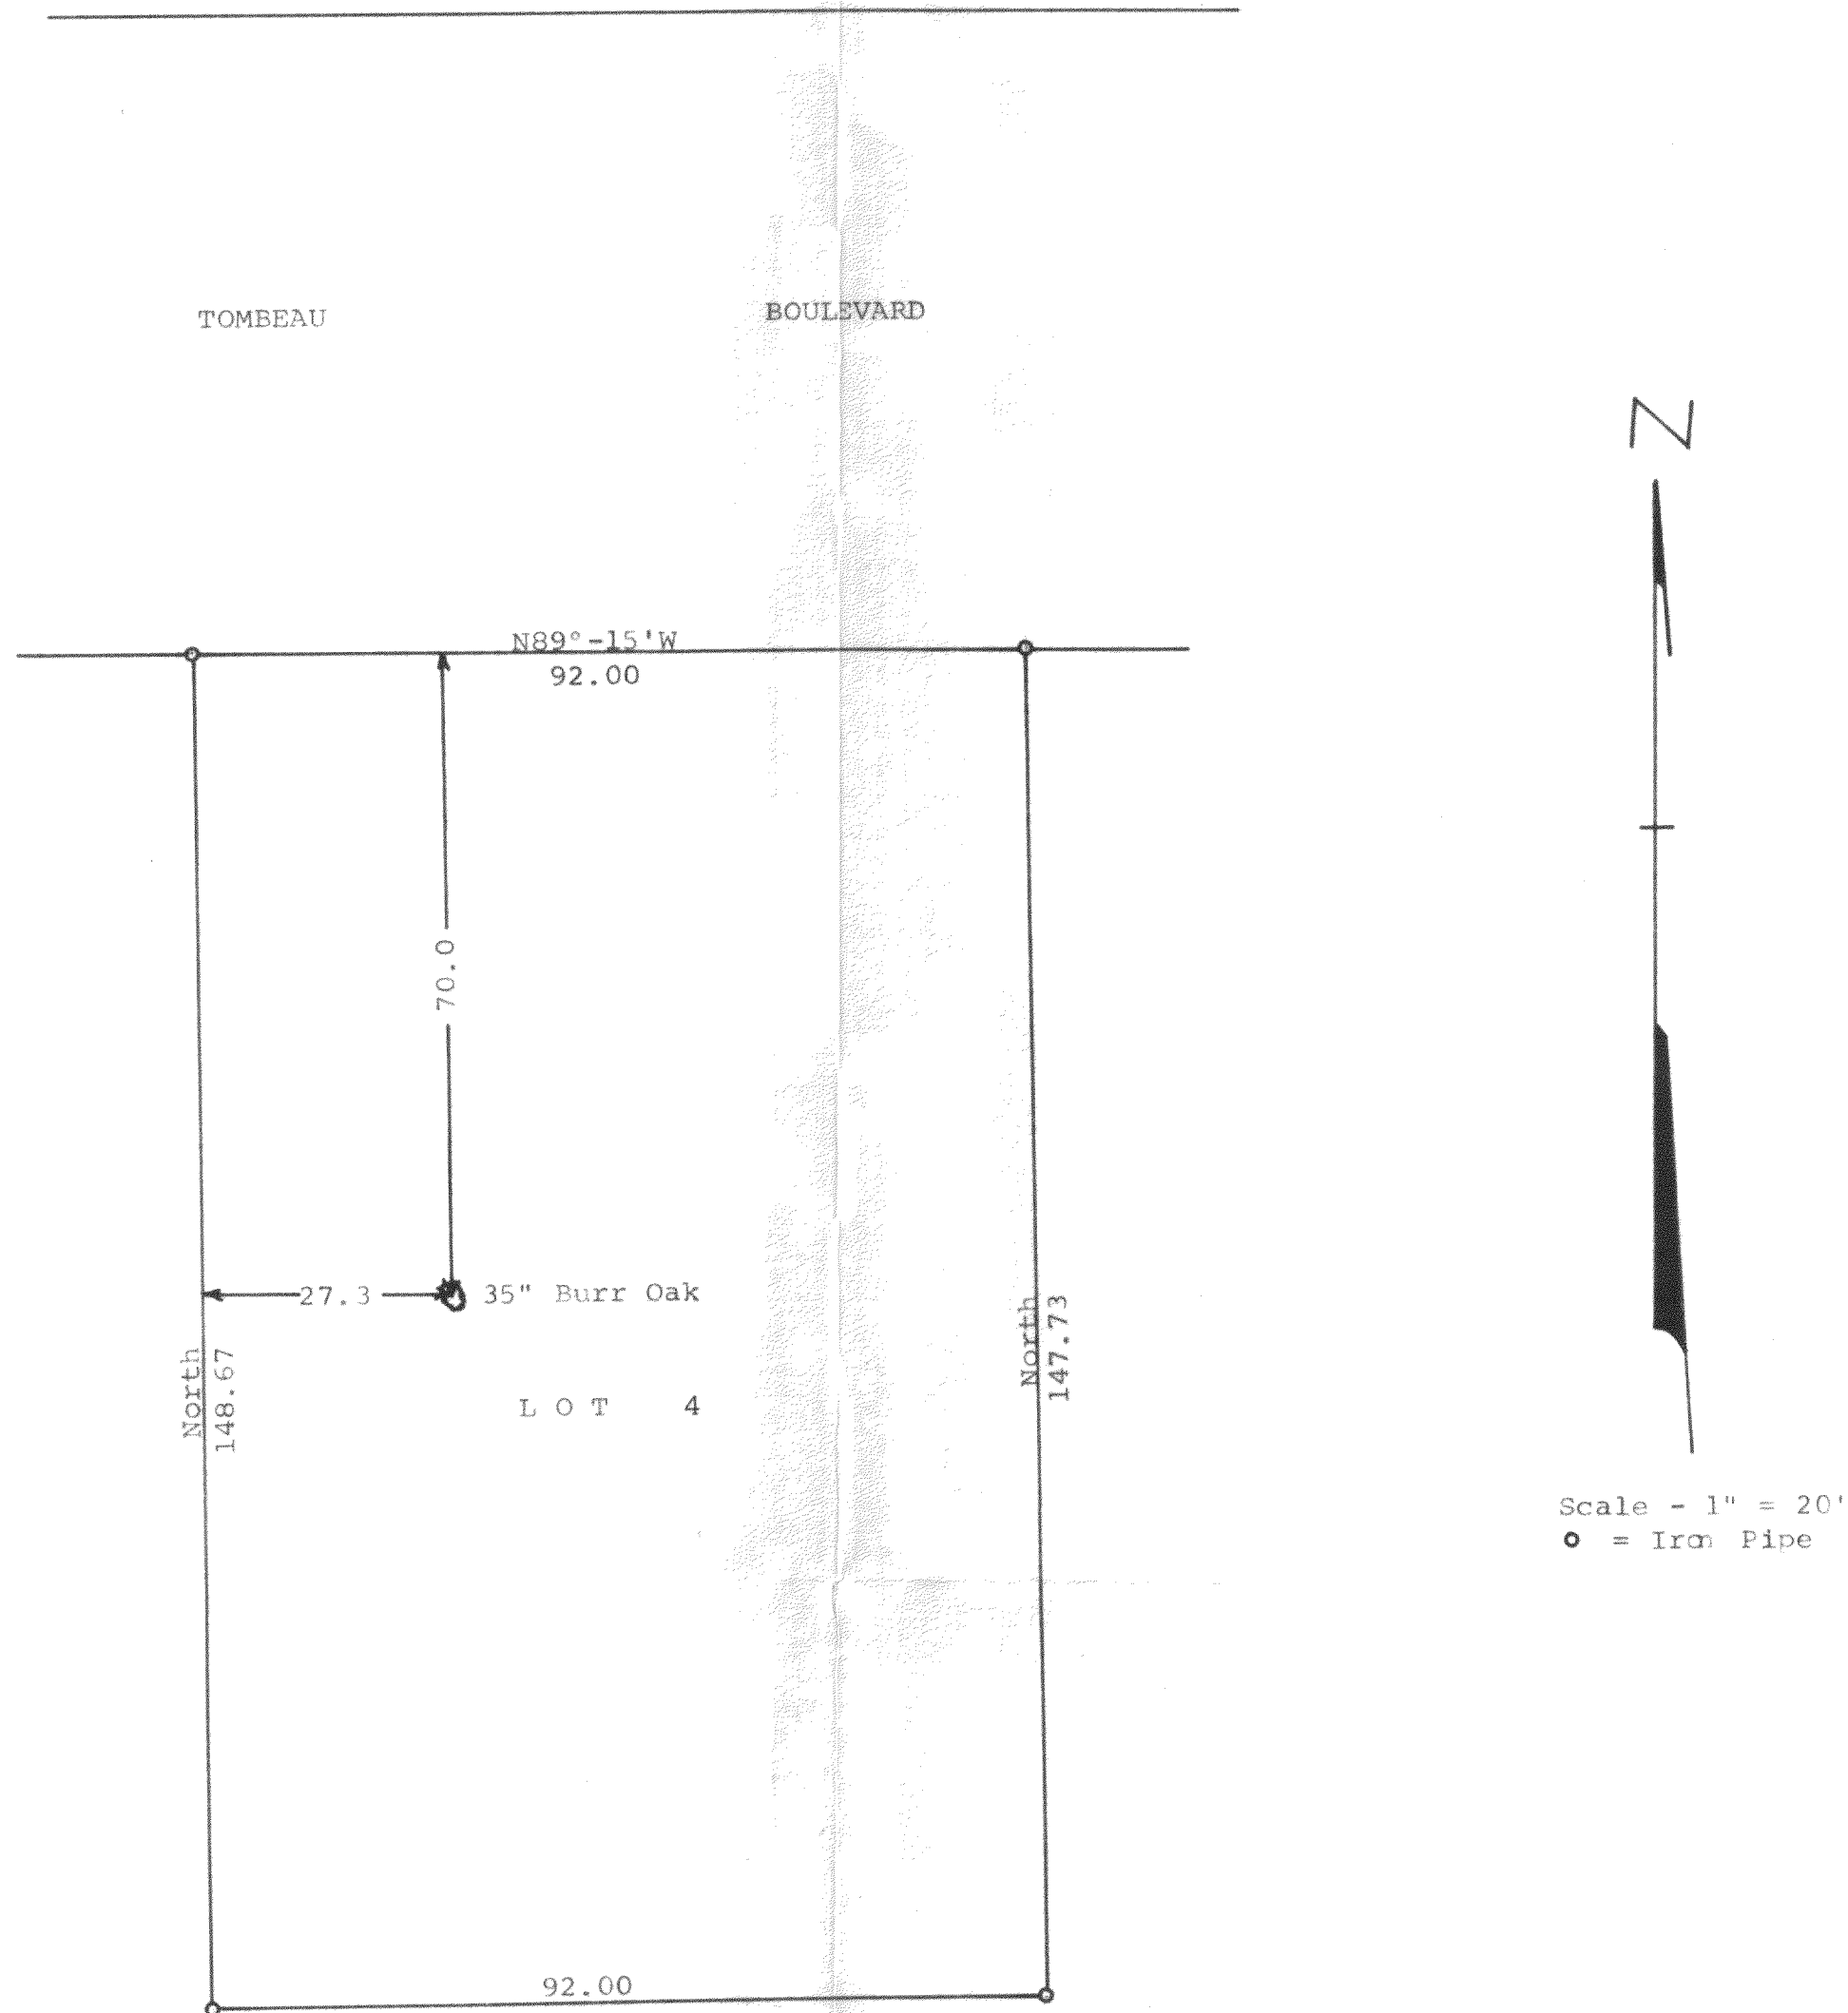

STATE OF WISCONSIN)
COUNTY OF WALWORTH) SS

I, George T. Dunham, Surveyor, certify that I have surveyed
the property described as follows,

Lot 4, Block 1, Rose Nippersink Gardens, a subdivision located
in Section 24, T 1 N, R 18 E, Walworth County, Wisconsin,
and that the above plat is an accurate survey and a true representation
thereof and correctly shows the exterior boundary lines and there are no
buildings located on said lot at this time.

March 7, 1973

George T. Dunham
George T. Dunham, Surveyor

