


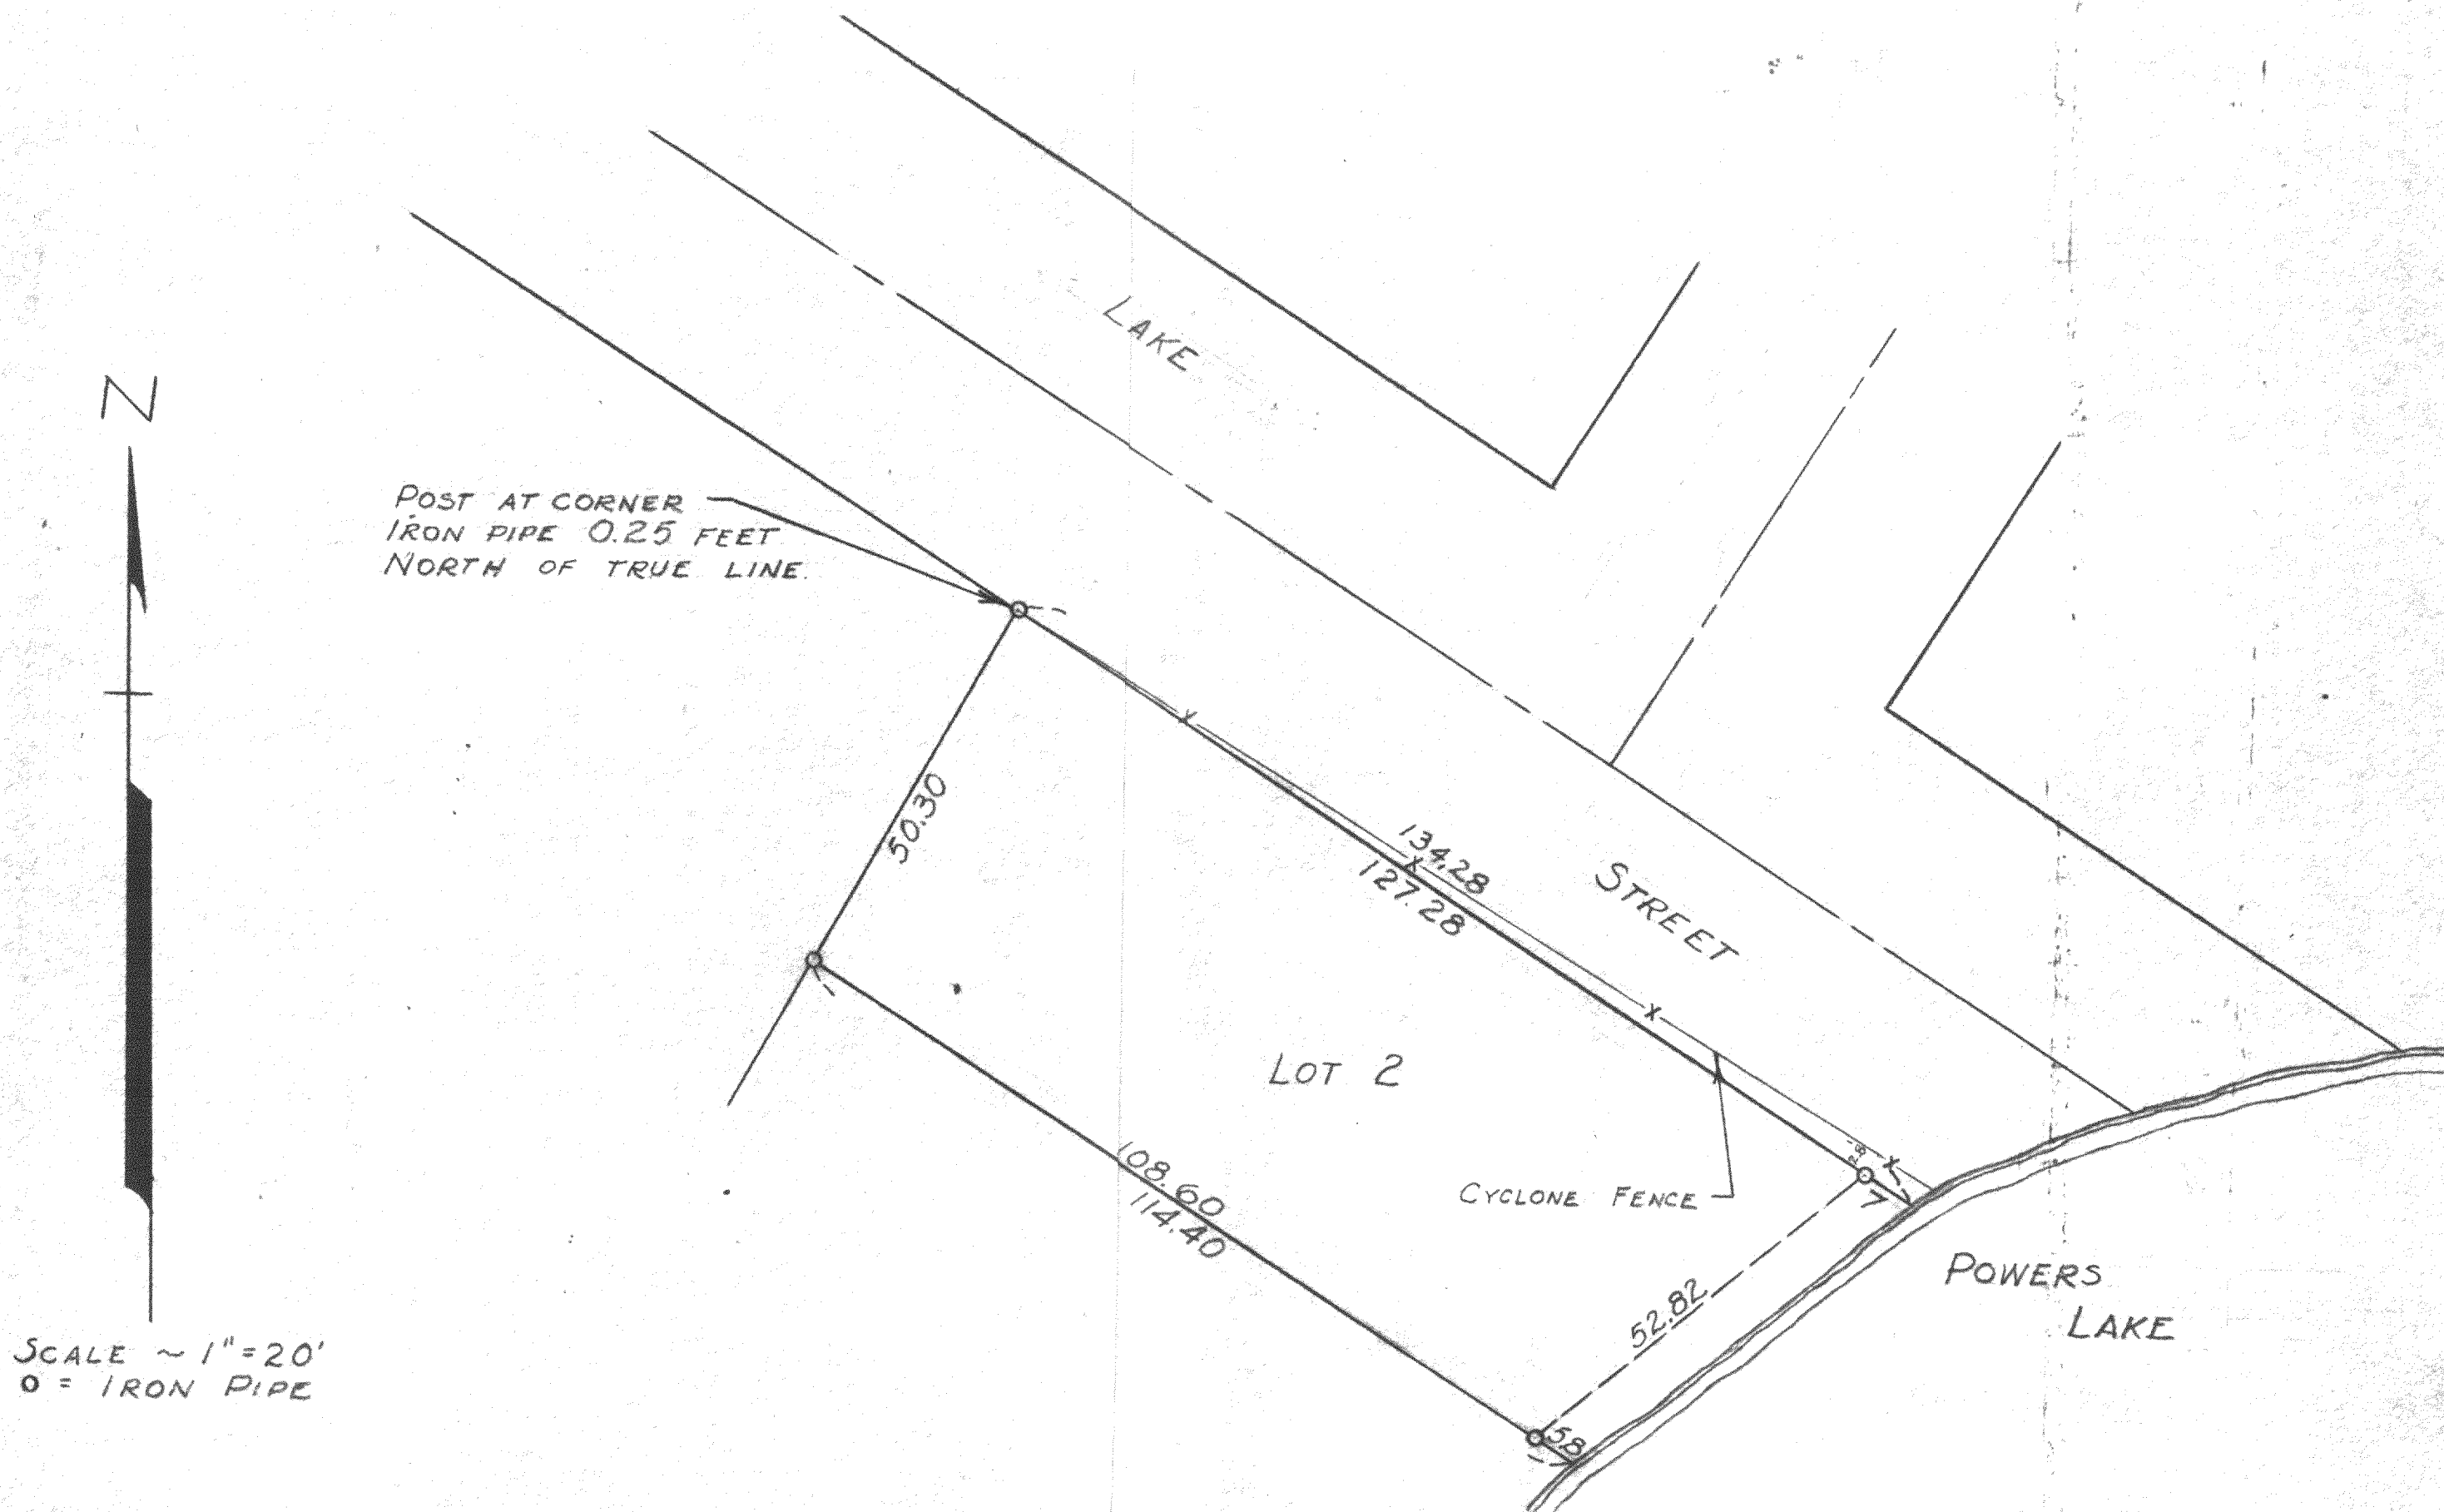

PLAT OF SURVEY OF LOT 2, WM. ELLIOT'S POWERS LAKE SUBDIVISION, LOCATED IN SECTION 13,
TINRIBE OF WALWORTH COUNTY, WISCONSIN.
APRIL 18, 1958

George T. Dunham
GEORGE T. DUNHAM, SURVEYOR
DELAVER, WISCONSIN

118-40