


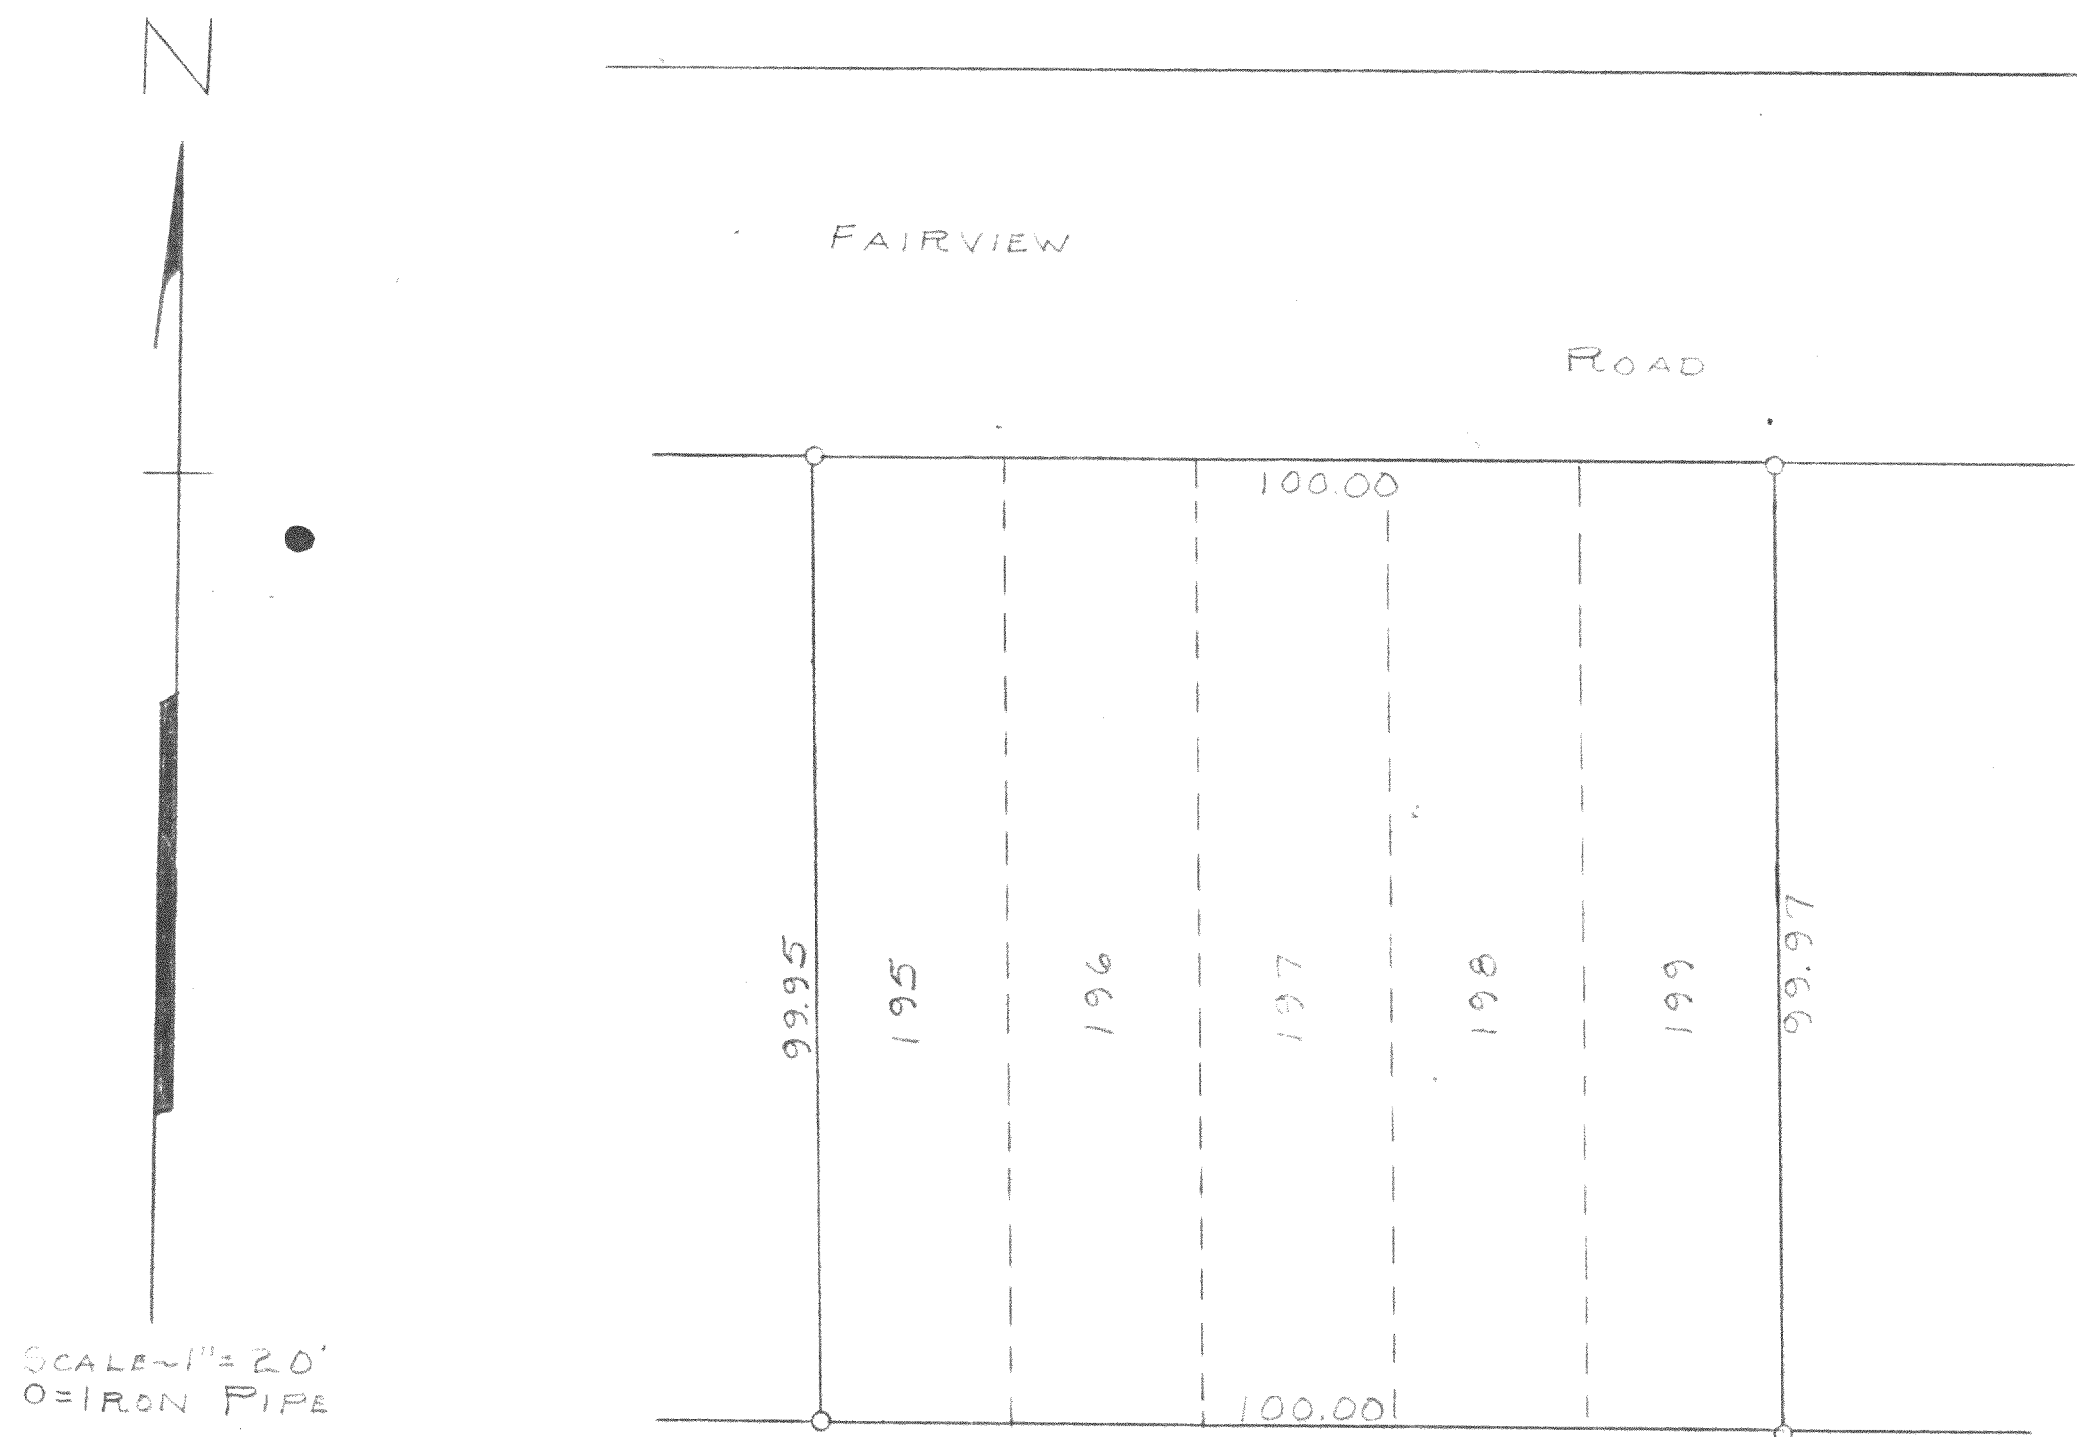

STATE OF WISCONSIN)^{SS}
WALWORTH COUNTY)

I, GEORGE T. DUNHAM, DO HEREBY CERTIFY THAT I HAVE
SURVEYED THE PROPERTY DESCRIBED AS FOLLOWS:

LOTS 195-199 INCLUSIVE OF PELL LAKE HIGHLANDS LOCATED
IN SECTION 16, T1N R18E OF WALWORTH COUNTY, WISCONSIN
AND THAT THE PLAT SHOWN ABOVE IS A CORRECT REPRESENTATION THE
PROPERTY LINES
JULY 7, 1959

George T. Dunham
GEORGE T. DUNHAM
WIS. LAND SURVEYOR NO 5-306
DELAVER, WISCONSIN 118-41