


HAROLD H. KOLB

REGISTERED PROFESSIONAL LAND SURVEYOR
LAKE GENEVA, WISCONSIN




N

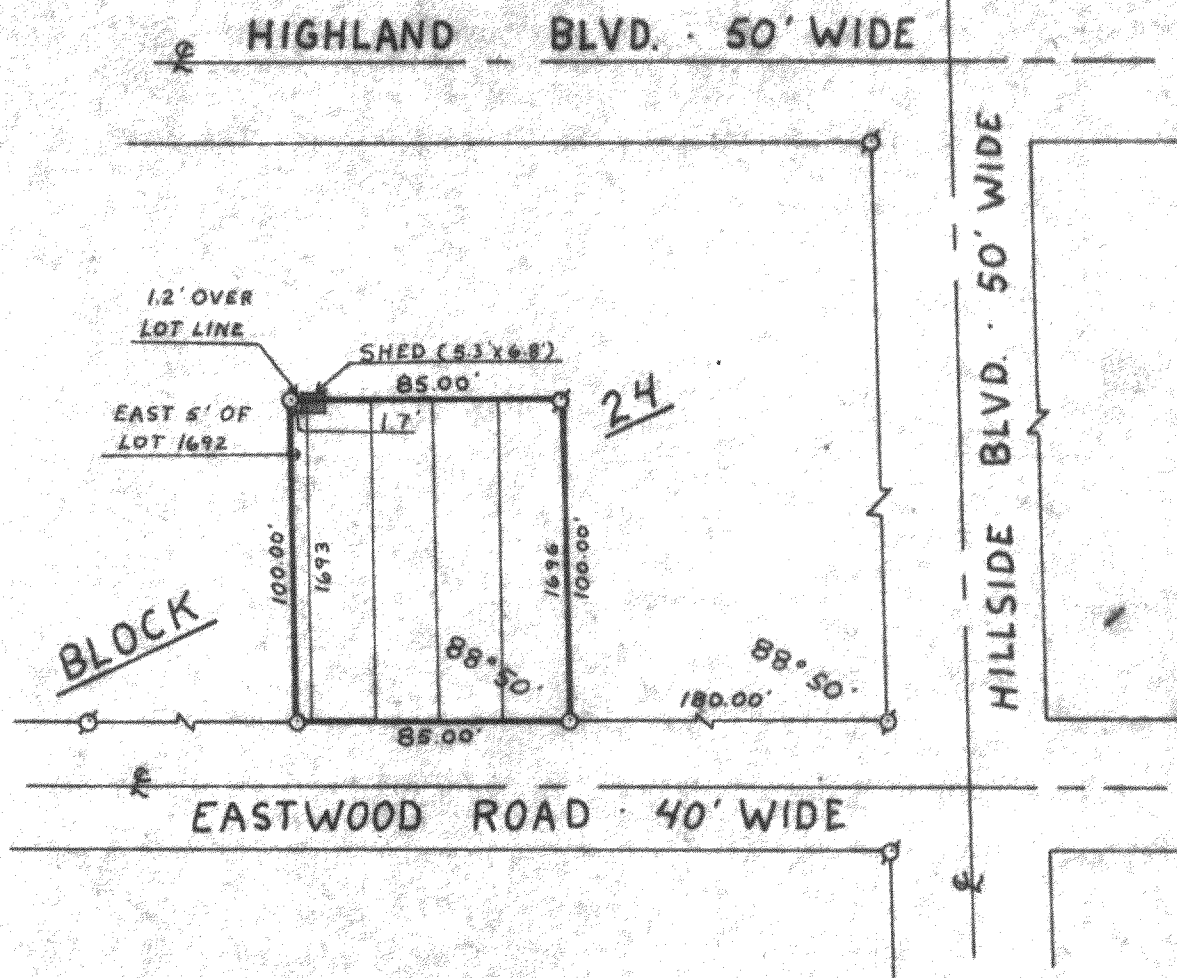

SCALE - 1" = 60'

LEGEND

- phi - IRON PIPE FOUND
- o - IRON PIPE PLACED
- bullet - CONCRETE MONUMENT
- x - SPIKE

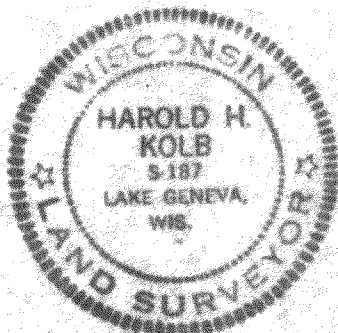

PLAT OF SURVEY OF

Lots 1693-1696 and the East 5 feet
of lot 1692, Block 24, Pell Lake
Highlands, T1N, R18E, Walworth County,
Wisconsin.

I, HAROLD H. KOLB, DO HEREBY CERTIFY THAT I HAVE
SURVEYED THE PROPERTY HEREON DESCRIBED ACCORDING
TO THE OFFICIAL RECORDS, AND THAT THE PLAT HEREON
IS A CORRECT REPRESENTATION OF THE LOT LINES.

Harold H. Kolb
HAROLD H. KOLB
WISCONSIN REGISTERED LAND SURVEYOR, S-187
DATE Oct 24, 1973

118-415