


HAROLD H. KOLB

REGISTERED PROFESSIONAL LAND SURVEYOR
LAKE GENEVA, WISCONSIN

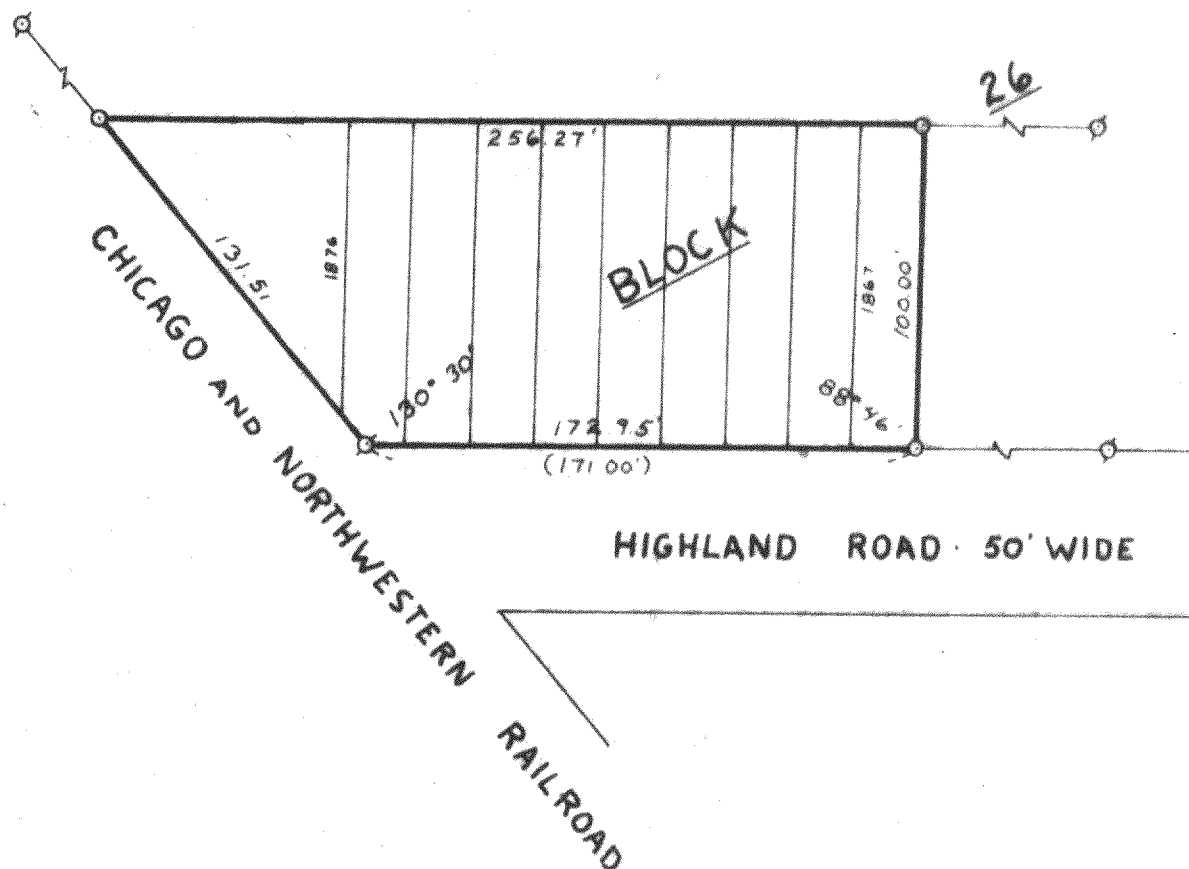

HIGHLAND ROAD - 50' WIDE

PLAT OF SURVEY OF


Lots 1867-1876, in Block 26 in the Pell
Lake Highlands Subdivision in the NW $\frac{1}{4}$
of the SE $\frac{1}{4}$ of Section 16, T 1 N, R 18 E,
Walworth County, Wisconsin.



SCALE - 1" = 60'

LEGEND

- ⊕ - IRON PIPE FOUND
- - IRON PIPE PLACED
- - CONCRETE MONUMENT
- x - SPIKE
- () - AS PLATTED

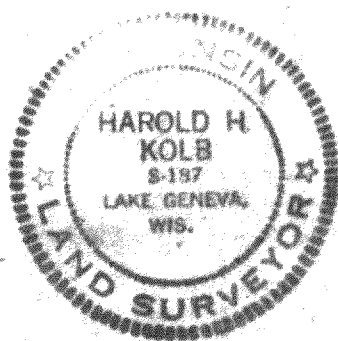

I, HAROLD H. KOLB, DO HEREBY CERTIFY THAT I HAVE
SURVEYED THE PROPERTY HEREON DESCRIBED ACCORDING
TO THE OFFICIAL RECORDS, AND THAT THE PLAT HEREON
IS A CORRECT REPRESENTATION OF THE LOT LINES.

Harold H. Kolb

HAROLD H. KOLB
WISCONSIN REGISTERED LAND SURVEYOR, S-187
DATE Oct. 8, 1973

118-416