


GEORGE T. DUNHAM
SURVEYING & SUBDIVIDING
DELAVER, WISCONSIN

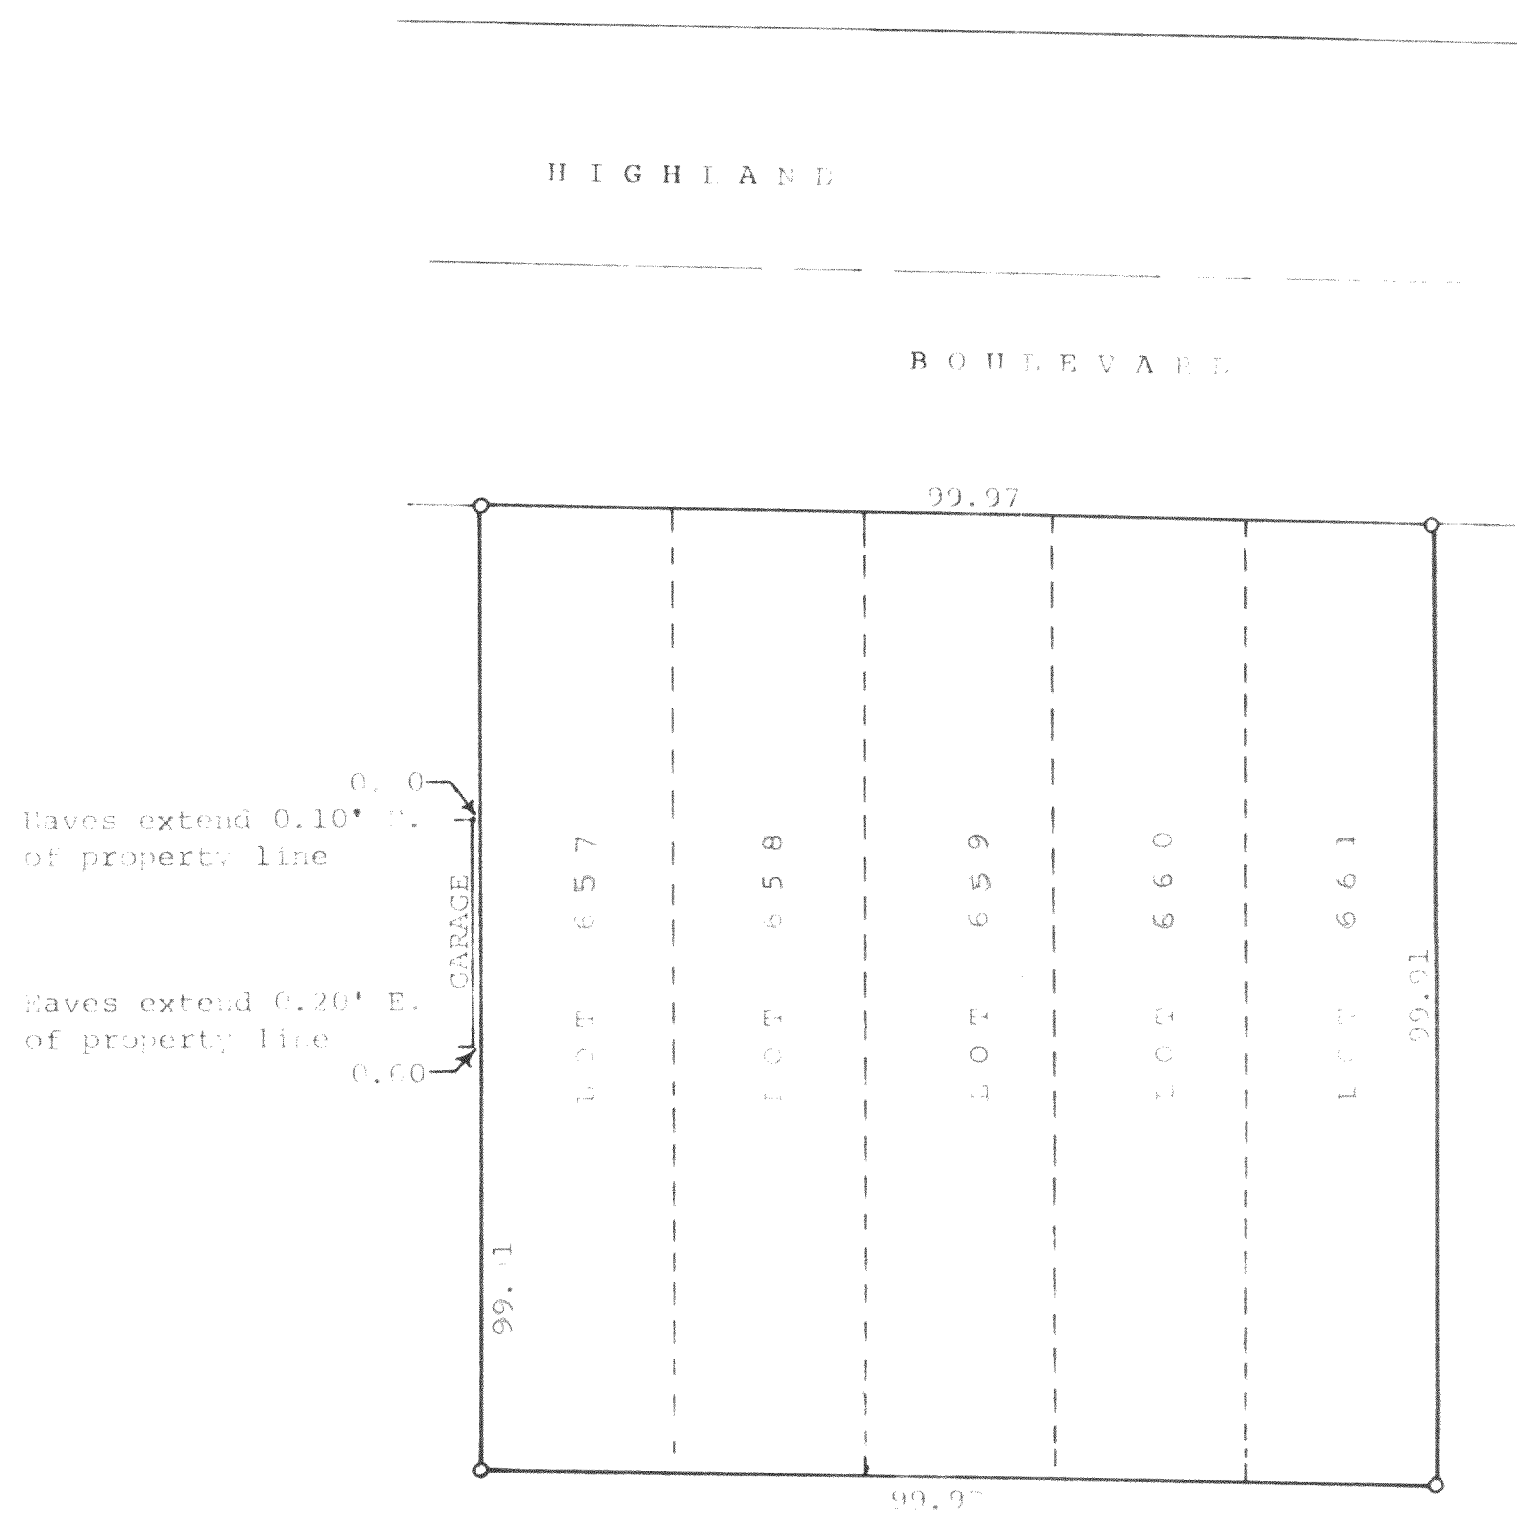

Scale = 1" = 20'

• = Iron Pipe

This plat serves lots 657-661 inclusive of
Full Lake Highlands, a subdivision located in
Section 16, T1N 31E, W2W2, Wisconsin
June 4, 1963

George T. Dunham
George T. Dunham, Surveyor